



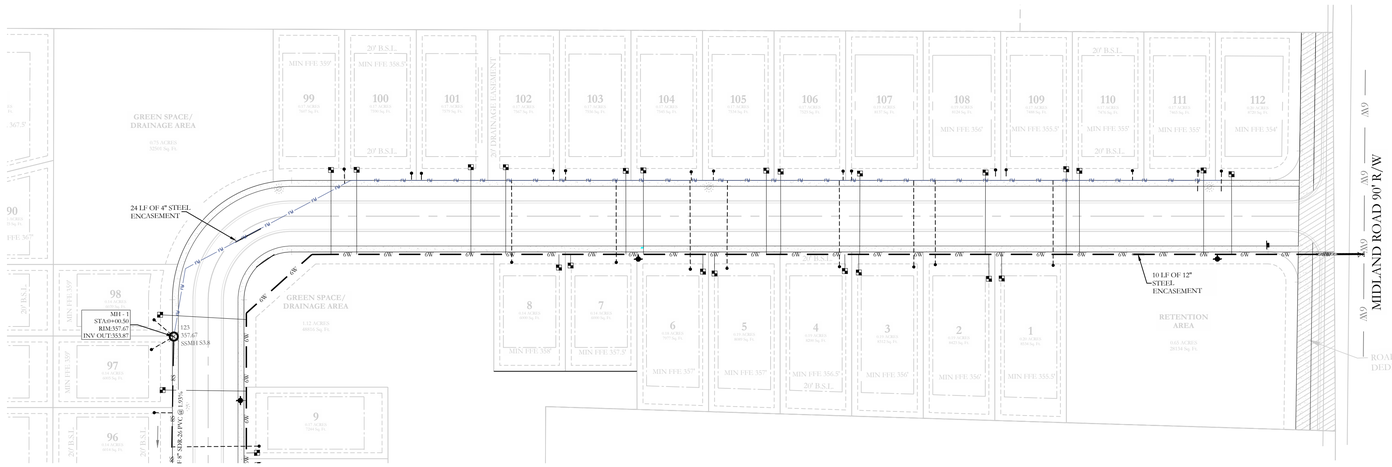


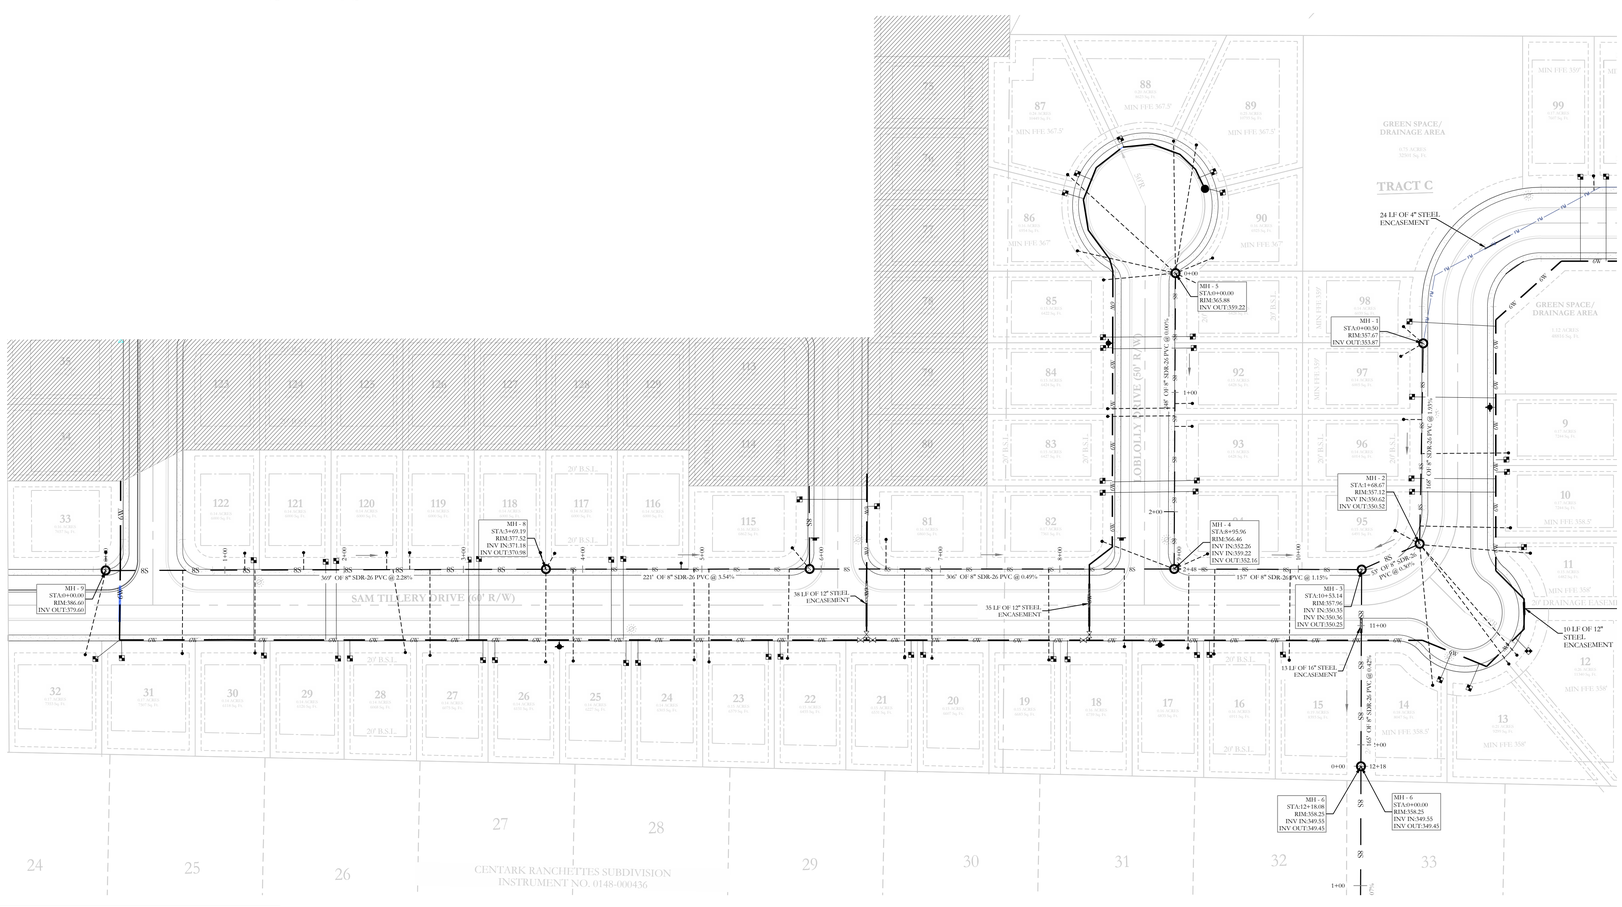

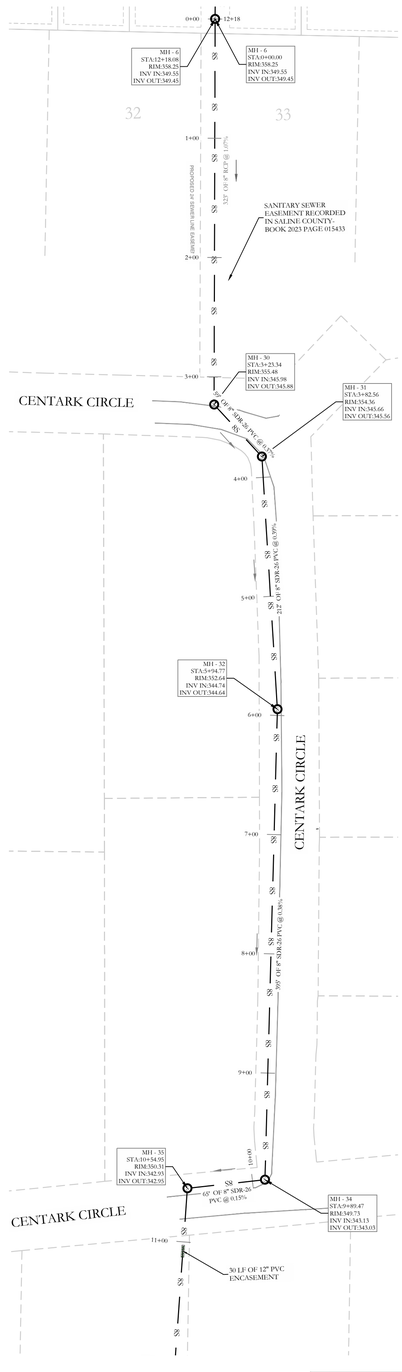

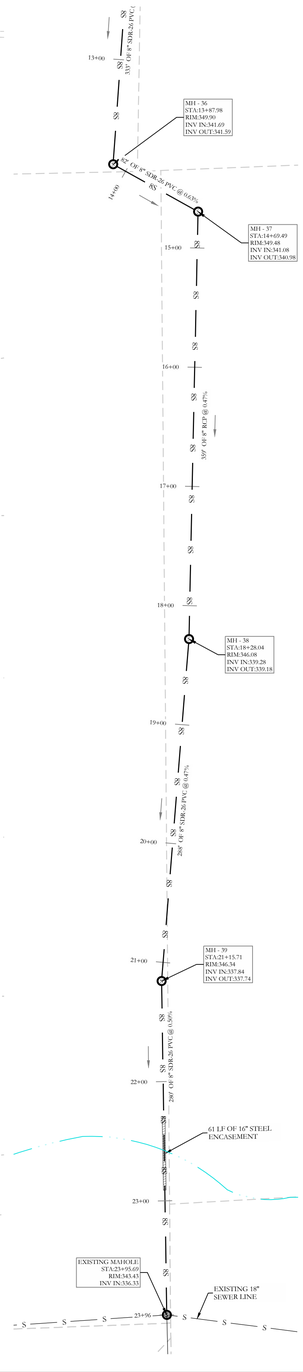

VICINITY MAP:

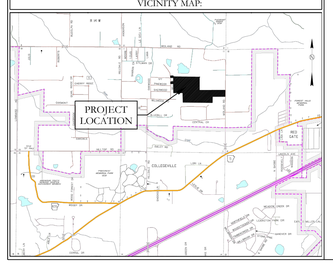

BASIS OF BEARINGS:
GRID NORTH, ARKANSAS
COORDINATE SYSTEM, SOUTH ZONE
BY GPS OBSERVATION

60 30 0 60

HOPE CONSULTING
ENGINEERS - SURVEYORS
129 North Main Street,
Benton, Arkansas 72015
PH. (501)315-2626
FAX (501) 315-0024
www.hopeconsulting.com


FOR USE AND BENEFIT OF:

HAVEN'S DEVELOPMENT, LLC

SANITARY SEWER AS-BUILTS
MIDLAND ROAD ESTATES
IN THE CITY OF BRYANT, SALINE COUNTY, ARKANSAS


DATE: 12/13/2024	C.A.D. BY:		DRAWING NUMBER:
REVISED:	CHECKED BY:		23-0024
SHEET:	SCALE: 1" = 60'		
500		0	


VICINITY MAP:

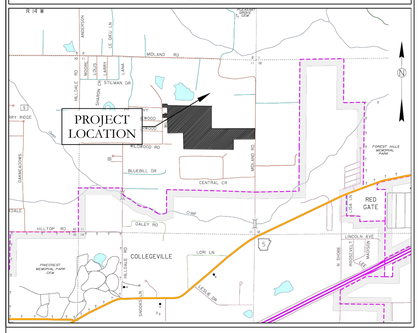


HDPE

RCP

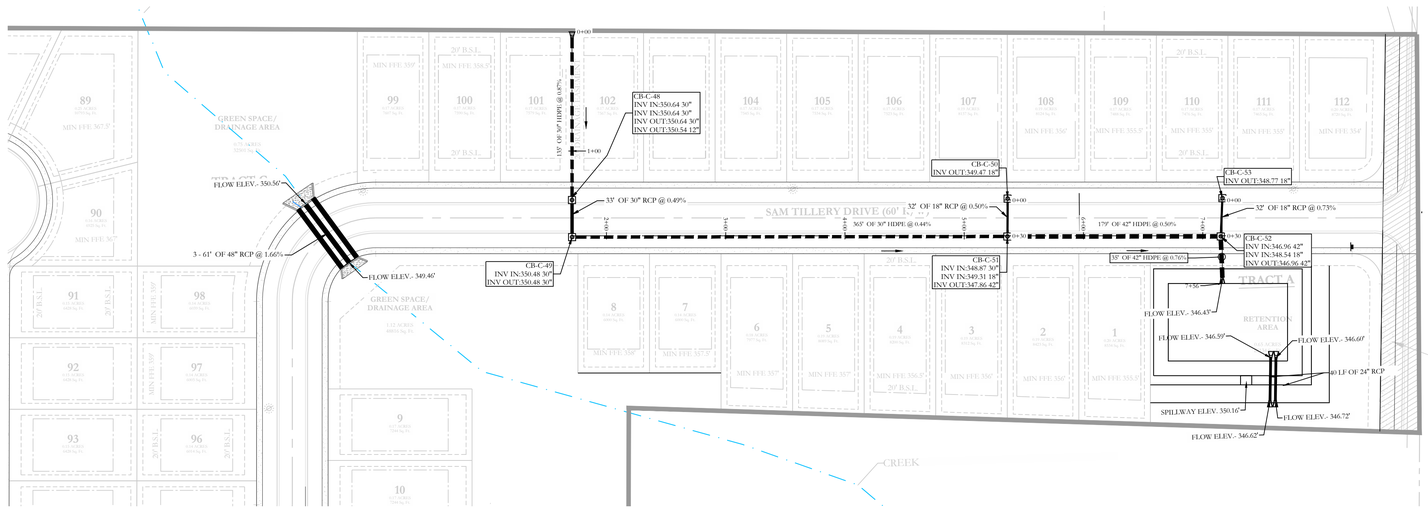

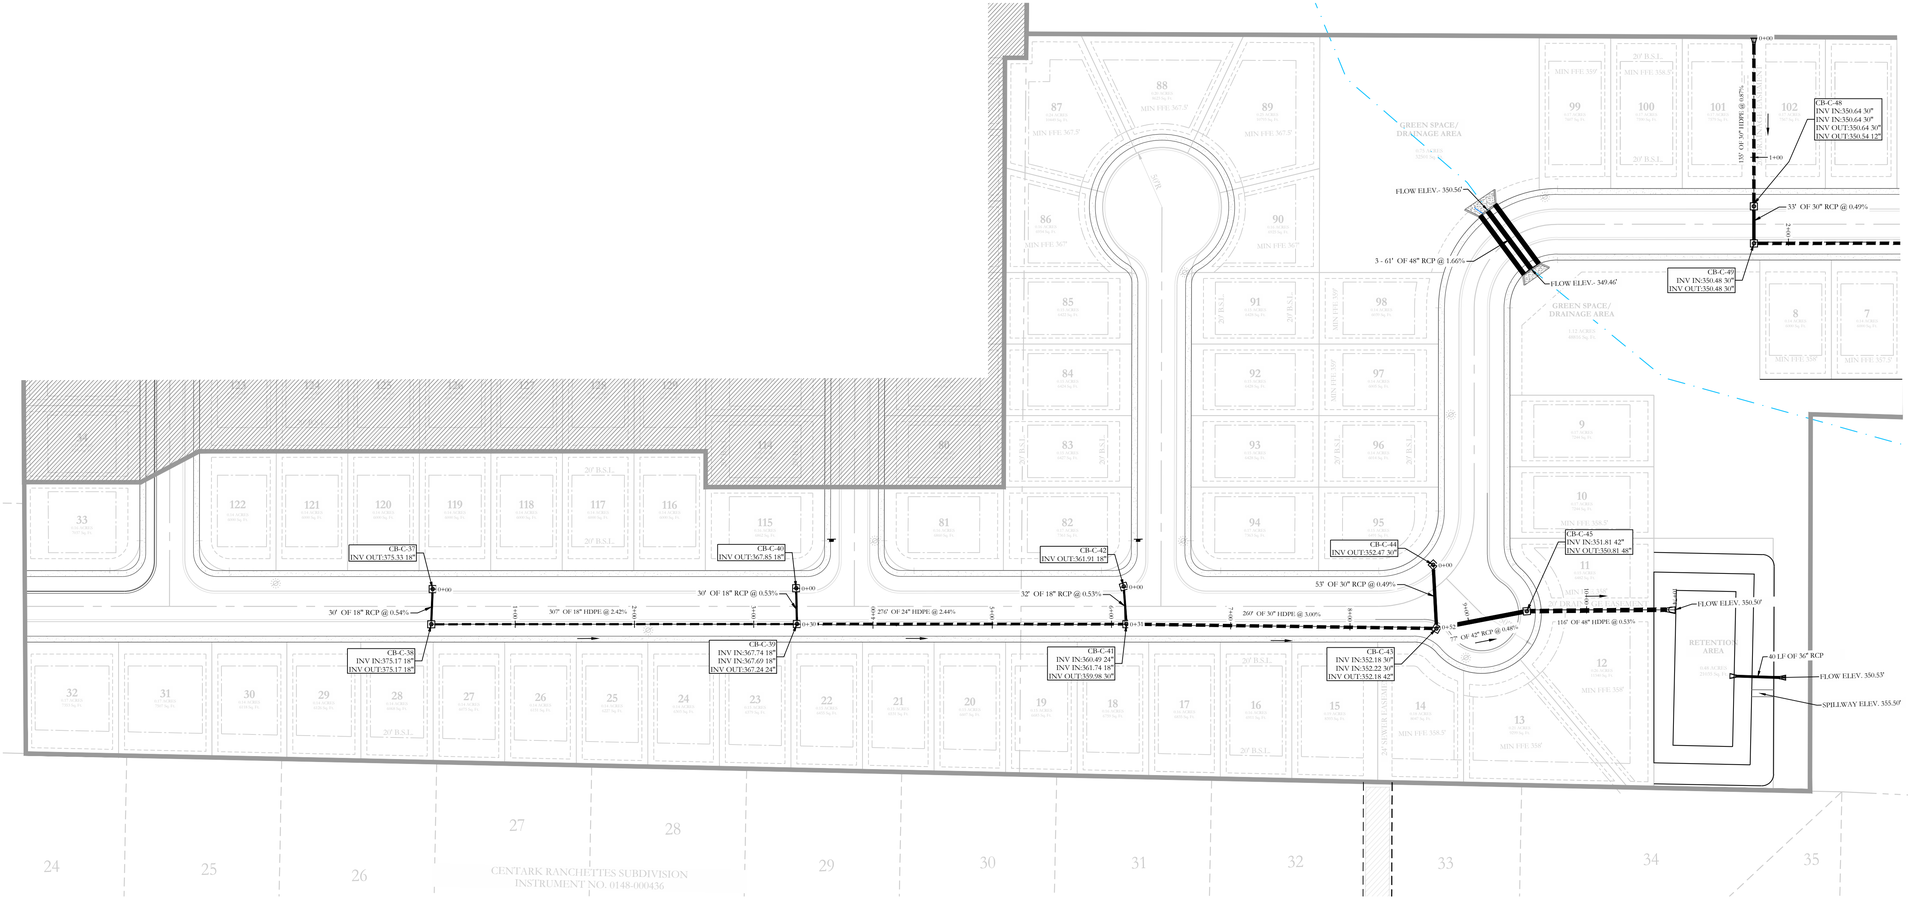

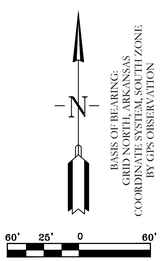

HOPE CONSULTING
ENGINEERS - SURVEYORS
129 North Main Street,
Benton, Arkansas 72015
PH. (501)315-2626
FAX (501) 315-0024
www.hopeconsulting.com

FOR USE AND BENEFIT OF:

HAVEN'S DEVELOPMENT, LLC

MIDLAND ROAD ESTATES

DRAINAGE AS-BUILTS

IN THE CITY OF BRYANT, SALINE COUNTY, ARKANSAS

DATE: 12/13/2024	C.A.D. BY:		DRAWING NUMBER:
REVISED:	CHECKED BY:		23-0024
SHEET:	SCALE: 1" = 60'		
500		0	

© Hope Consulting, LLC. ENGINEERS - SURVEYORS