
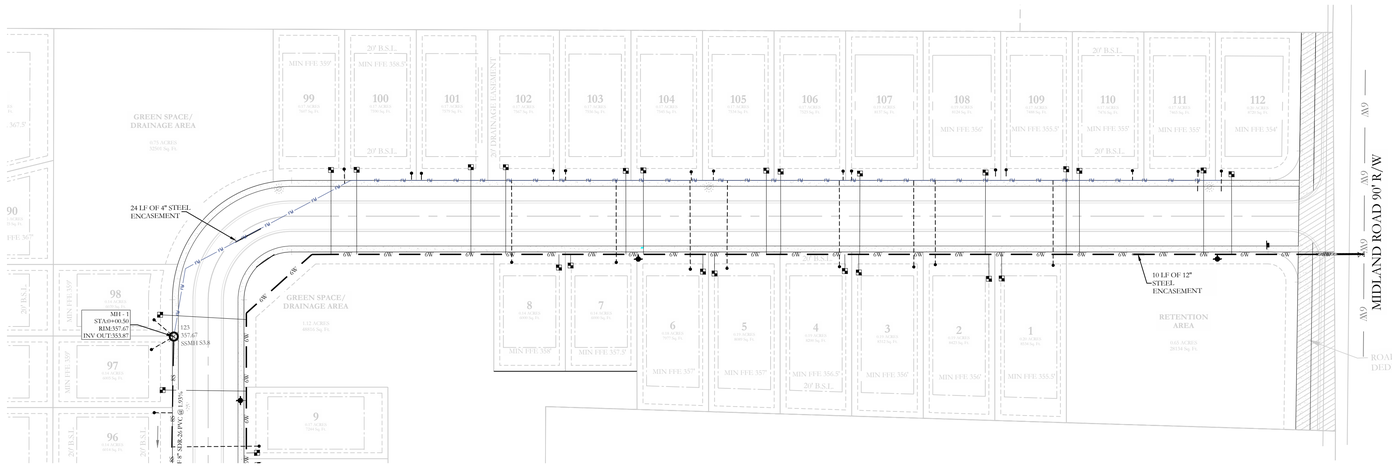
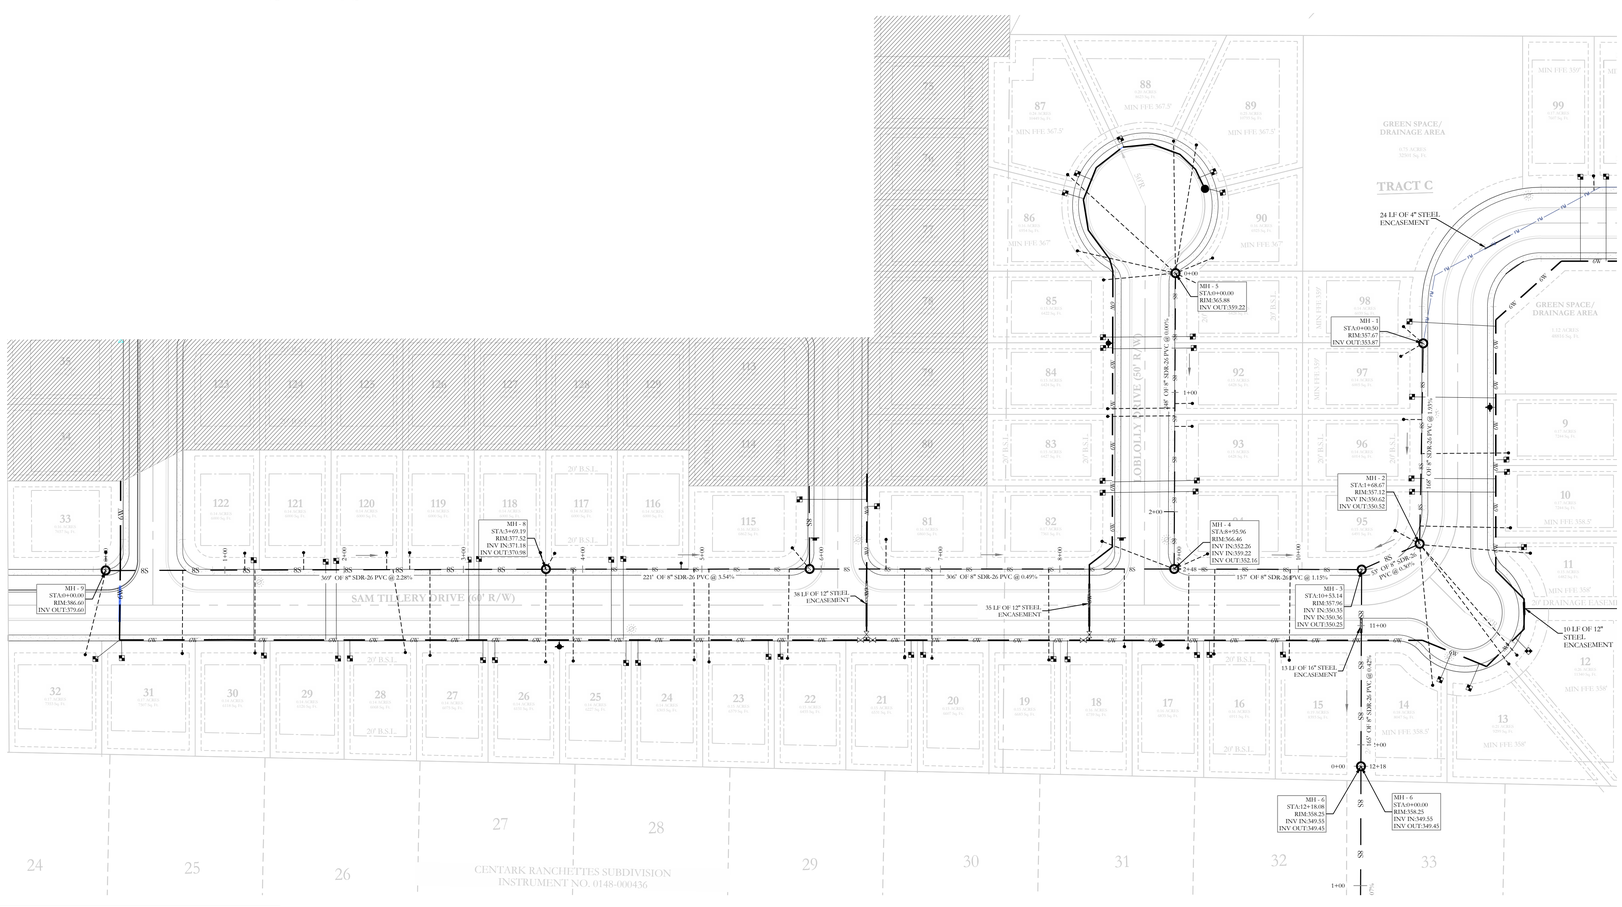
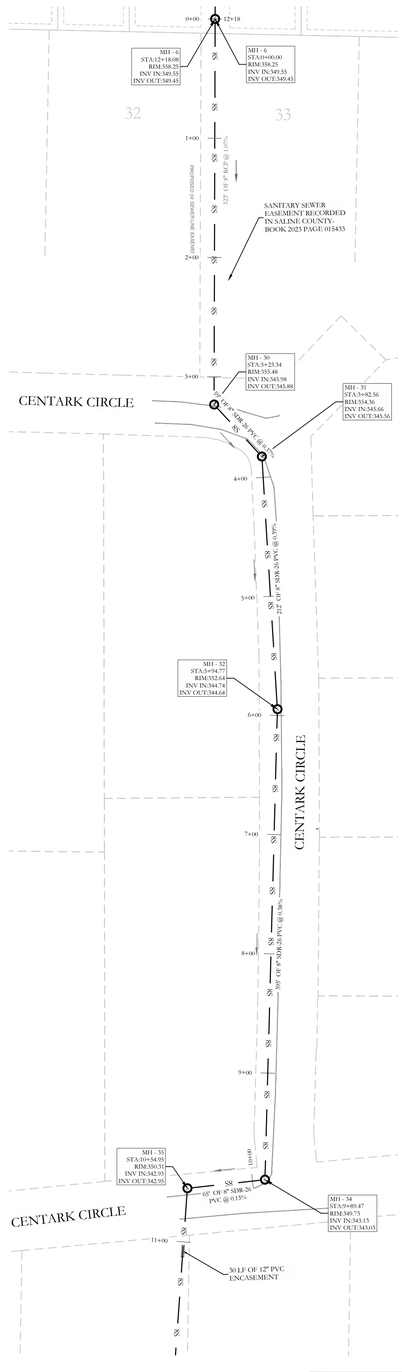
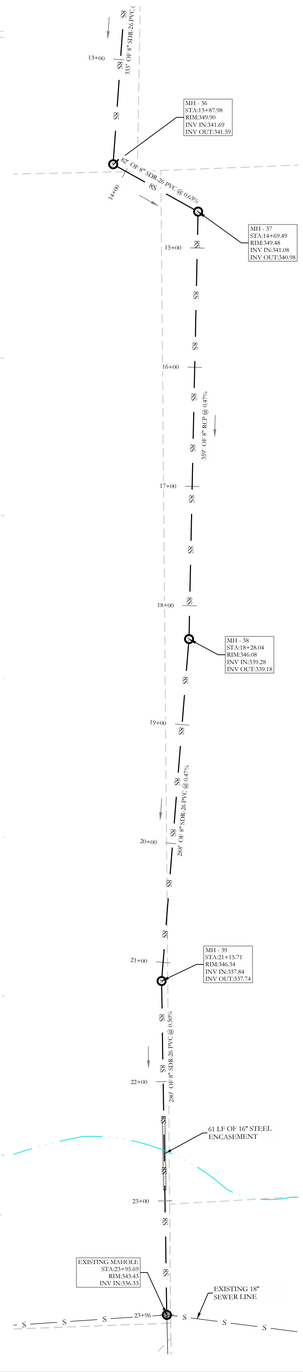



VICINITY MAP:

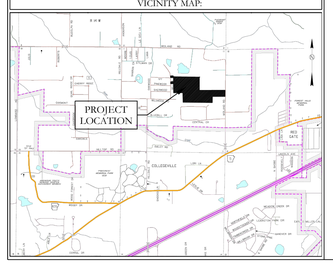


BASIS OF BEARINGS:
GRID NORTH, ARKANSAS
COORDINATE SYSTEM, SOUTH ZONE
BY GPS OBSERVATION

60 30 0 60

HOPE CONSULTING
ENGINEERS - SURVEYORS
129 North Main Street,
Benton, Arkansas 72015
PH. (501)315-2626
FAX (501) 315-0024
www.hopeconsulting.com


FOR USE AND BENEFIT OF:

**HAVEN'S DEVELOPMENT, LLC**

SANITARY SEWER AS-BUILTS
**MIDLAND ROAD ESTATES**
IN THE CITY OF BRYANT, SALINE COUNTY, ARKANSAS


| | | | |
|---|---|---|---|
| DATE: 12/13/2024 | C.A.D. BY: | | DRAWING NUMBER: |
| REVISED: | CHECKED BY: | | 23-0024 |
| SHEET: | SCALE: 1" = 60' | | |
| 500 | | 0 | |


VICINITY MAP:

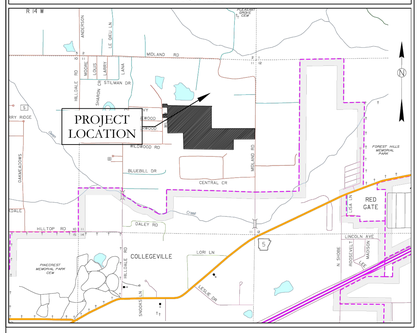



HDPE

RCP

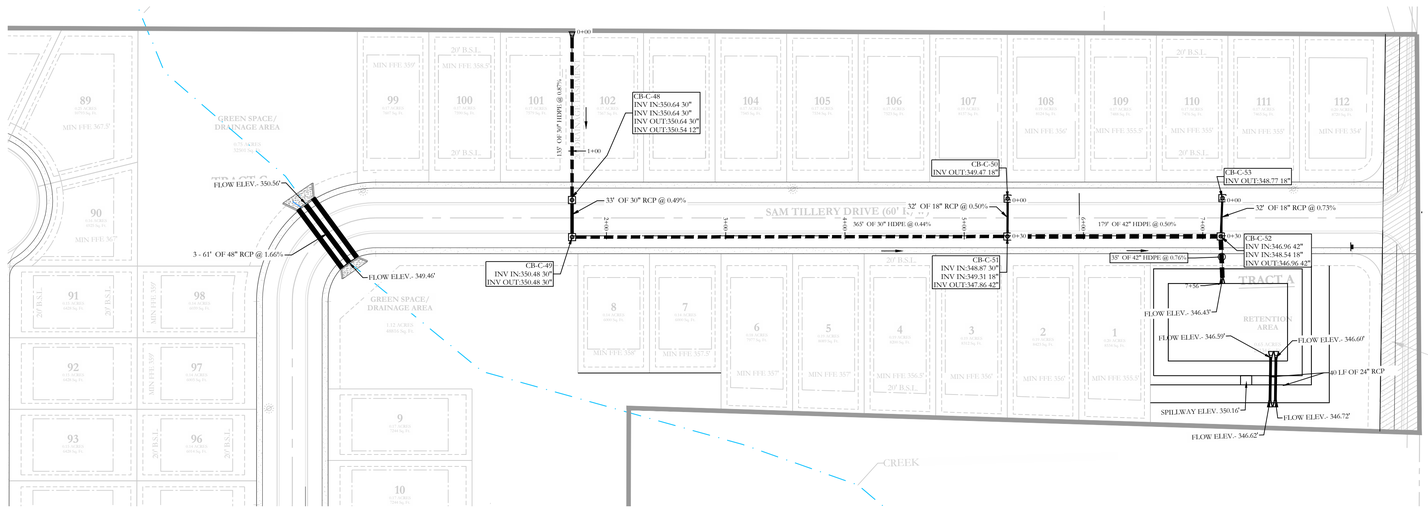

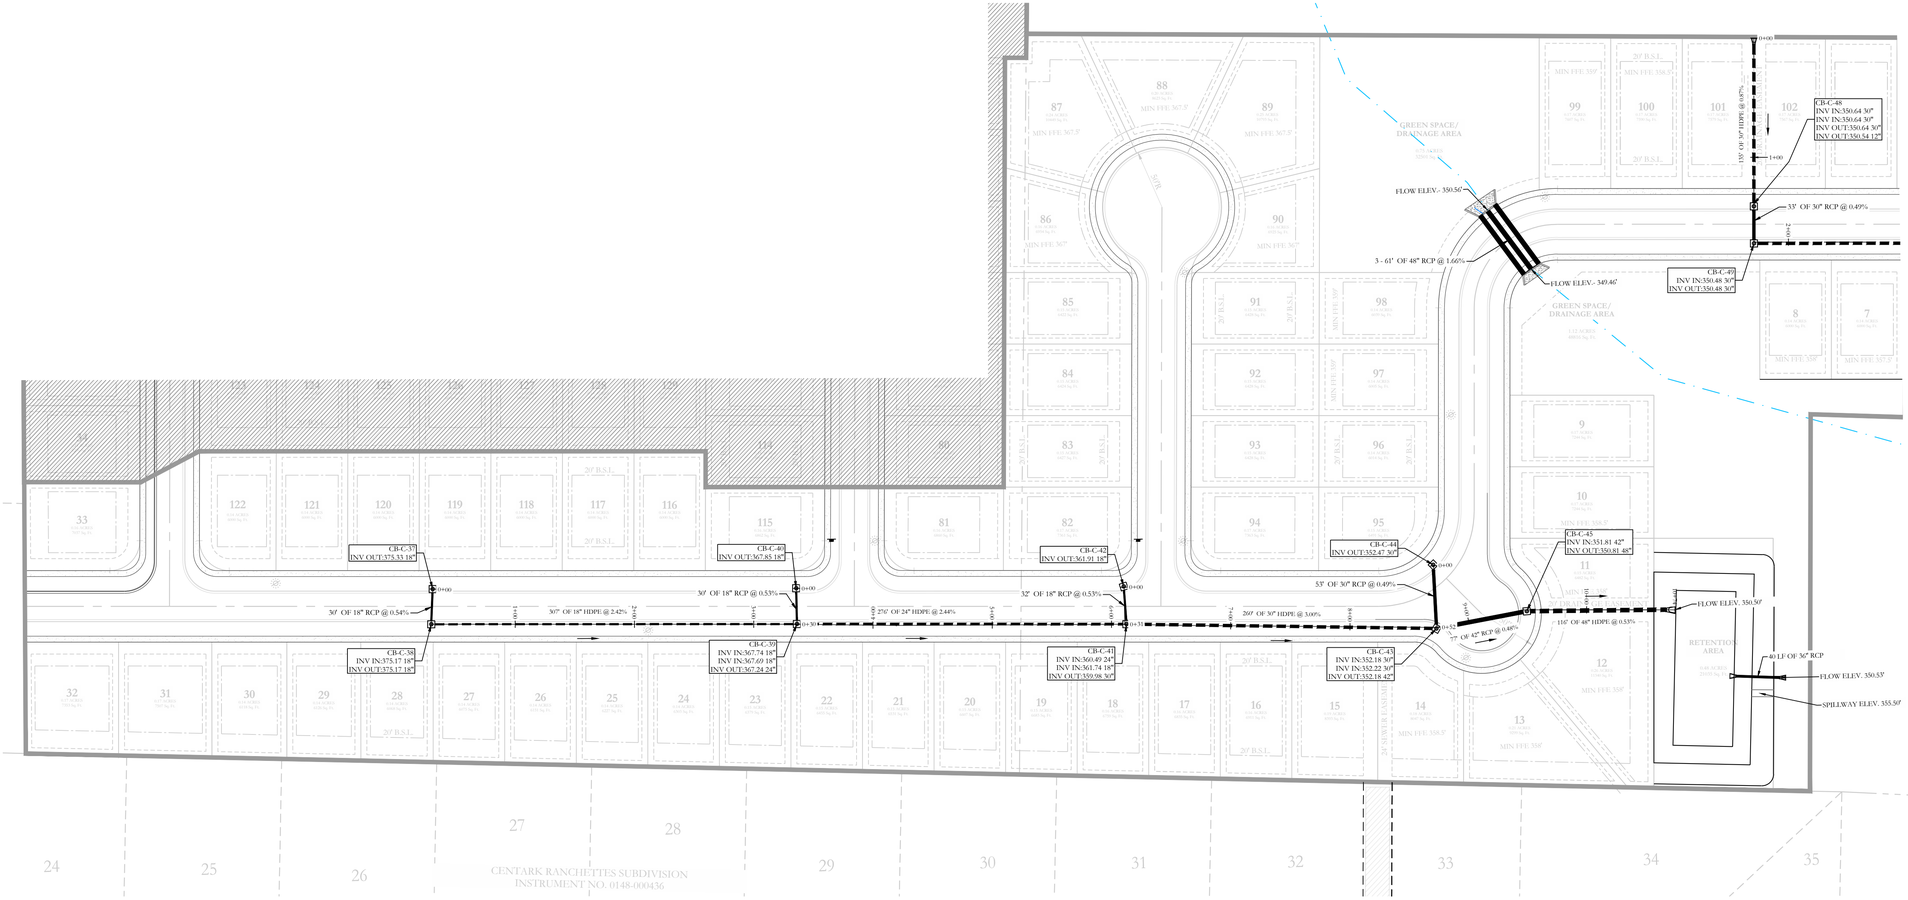

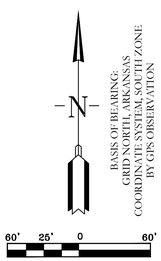HOPE CONSULTING
ENGINEERS - SURVEYORS
129 North Main Street,
Benton, Arkansas 72015
PH. (501)315-2626
FAX (501) 315-0024
www.hopeconsulting.com


FOR USE AND BENEFIT OF:

**HAVEN'S DEVELOPMENT, LLC**

**MIDLAND ROAD ESTATES**

DRAINAGE AS-BUILTS

IN THE CITY OF BRYANT, SALINE COUNTY, ARKANSAS

| | | | |
|---|---|---|---|
| DATE: 12/13/2024 | C.A.D. BY: | | DRAWING NUMBER: |
| REVISED: | CHECKED BY: | | 23-0024 |
| SHEET: | SCALE: 1" = 60' | | |
| 500 | | 0 | |


© Hope Consulting, LLC. ENGINEERS - SURVEYORS