

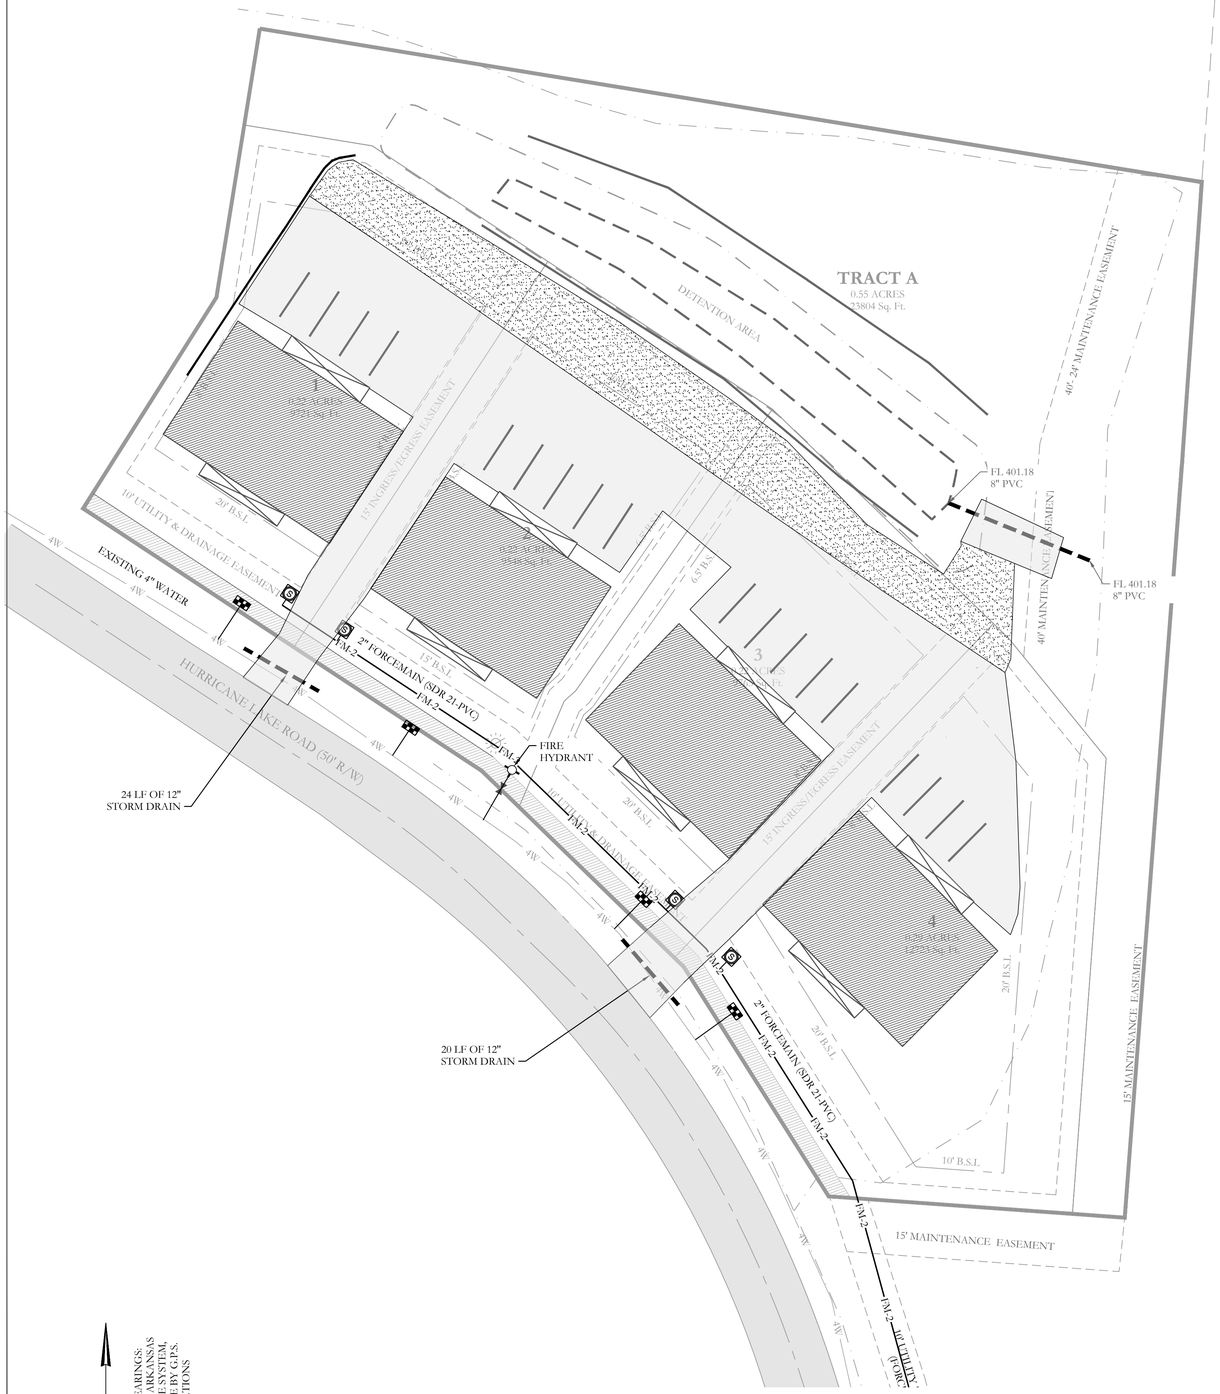


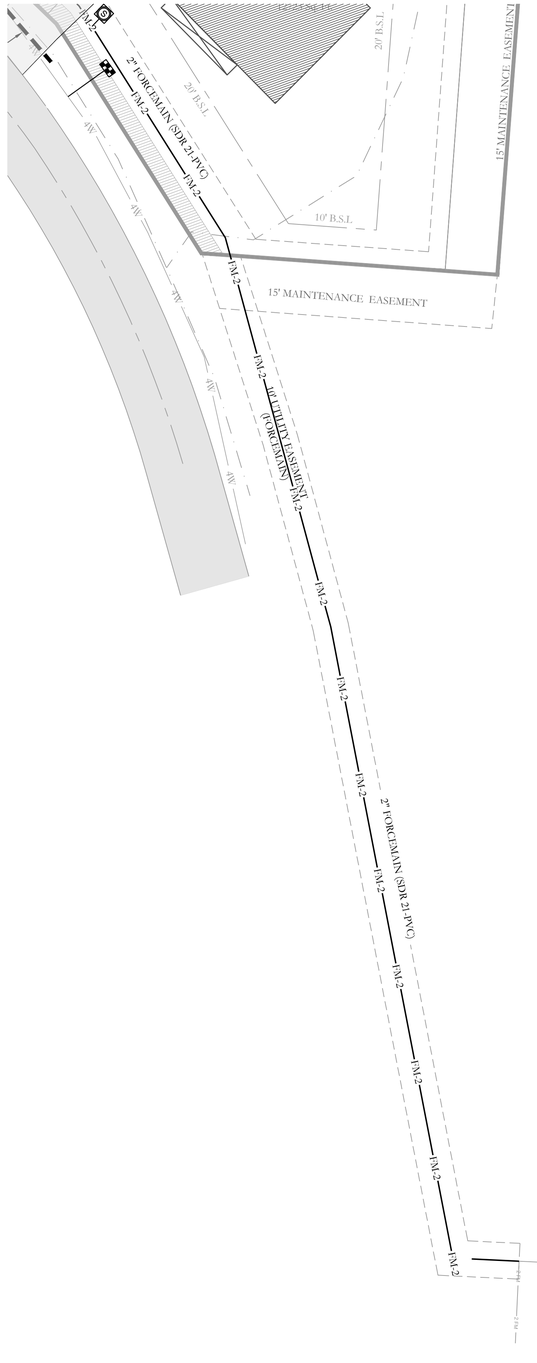

VICINITY MAP:

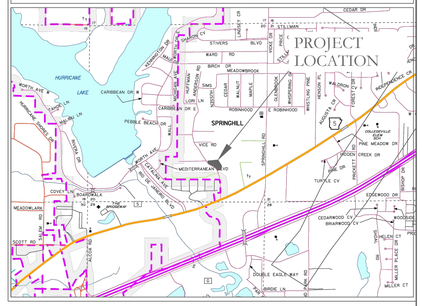


BASIS OF BEARINGS:
GRID NORTH, ARKANSAS
COORDINATE SYSTEM,
SOUTH ZONE BY G.P.S.
OBSERVATIONS

20' 10' 0 20'

WATER LEGEND:	
	2" BLOW OFF
WATER MAIN — WV	GATE VALVE
	REDUCER
FH	FIRE HYDRANT
	DOUBLE WATER SERVICE
	SINGLE WATER SERVICE

NOTE:
ALL FIRE HYDRANT LEADERS HAVE A GATE VALVE BETWEEN MAIN AND FIRE HYDRANT.

TYPICAL FIRE HYDRANT:

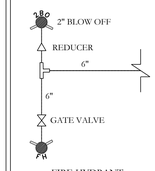

FIRE HYDRANT
(2 TO 6 FEET FROM
EDGE OF PAVEMENT)

SEWER LEGEND:

GRINDER PUMP — 2" SEWER MAIN FM-2

Know what's below. Call before you dig.

HOPE CONSULTING
ENGINEERS - SURVEYORS
129 N. Main Street,
Benton, Arkansas 72015
PH. (501)315-2626
FAX (501) 315-0024
www.hopeconsulting.com

FOR USE AND BENEFIT OF:
SKY BLUE, LLC.

SANITARY SEWER & WATER AS-BUILTS
SKY BLUE DUPLEXES
CITY OF BRYANT, SALINE COUNTY, ARKANSAS

DATE:	06-23-2025	C.A.D. BY:	DRAWING NUMBER:
REVISED:	06-30-2025	CHECKED BY:	19-0066
SHEET:		SCALE:	

K:\LAND PROJECTS 2004\SUBDIVISIONS\2019\19-0066 PRESIDENT DUPLEXES\DWGS\AS-BUILTS\19-0066-AS-BUILT.DWG