

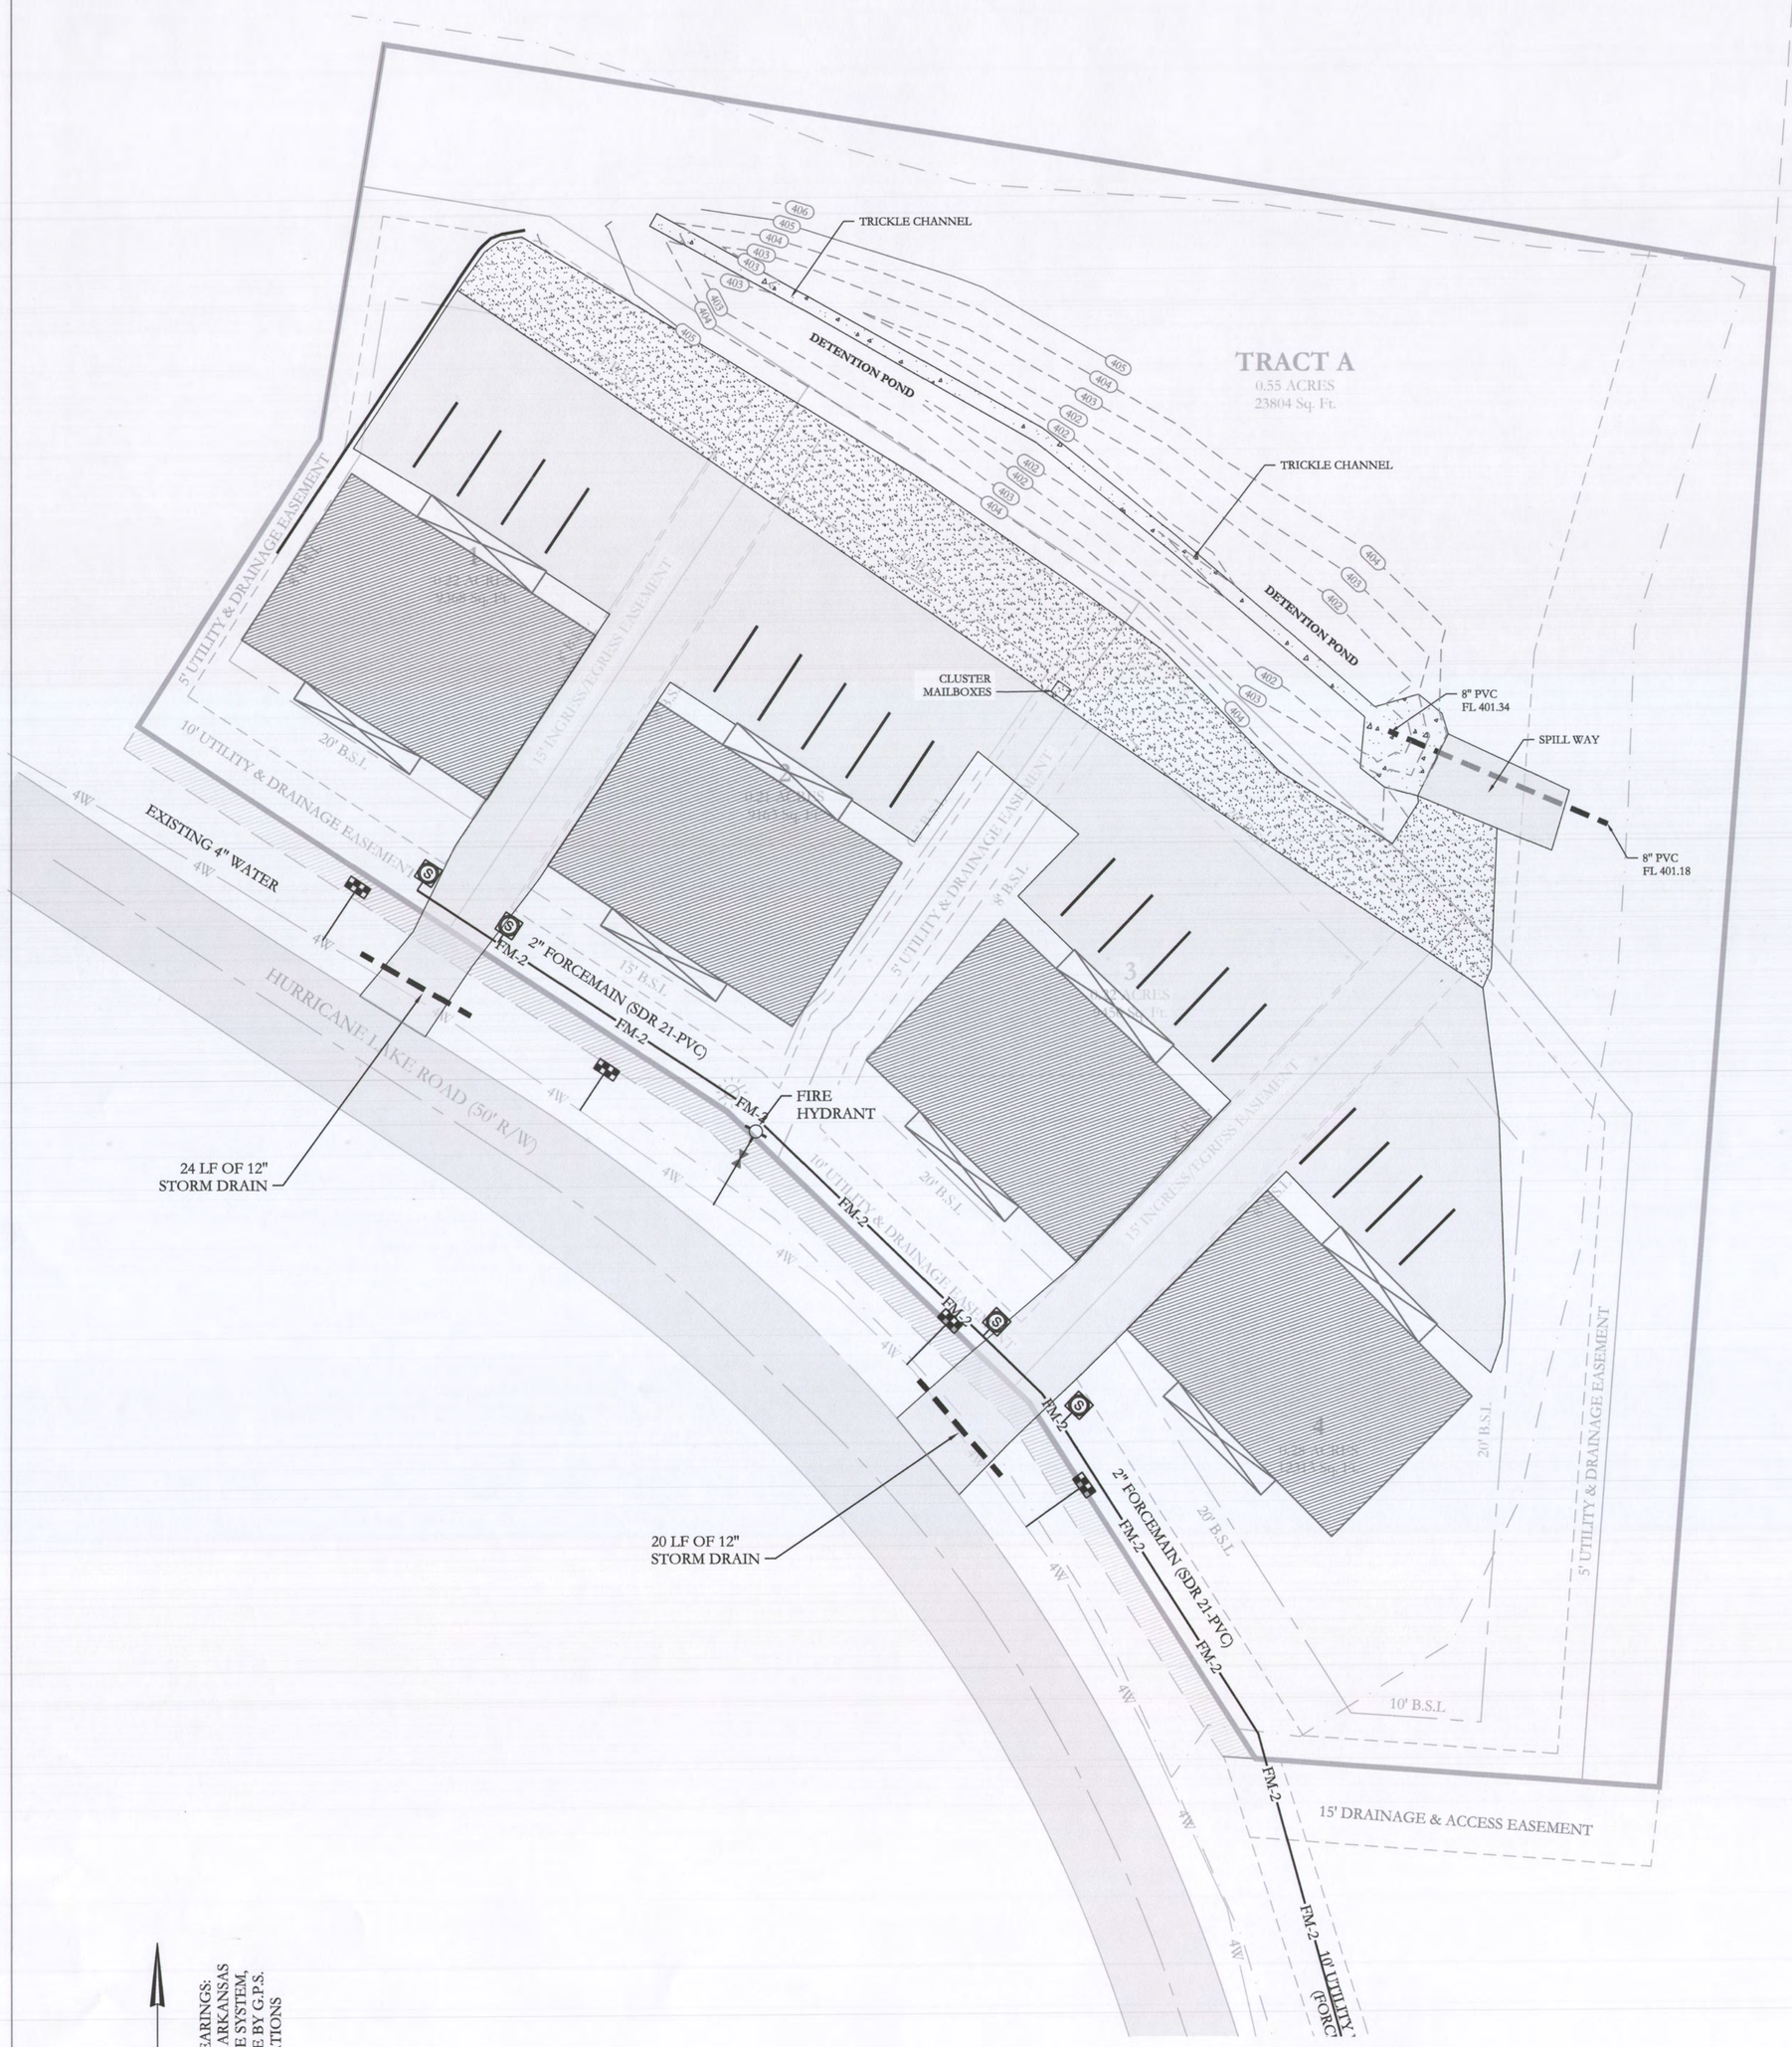


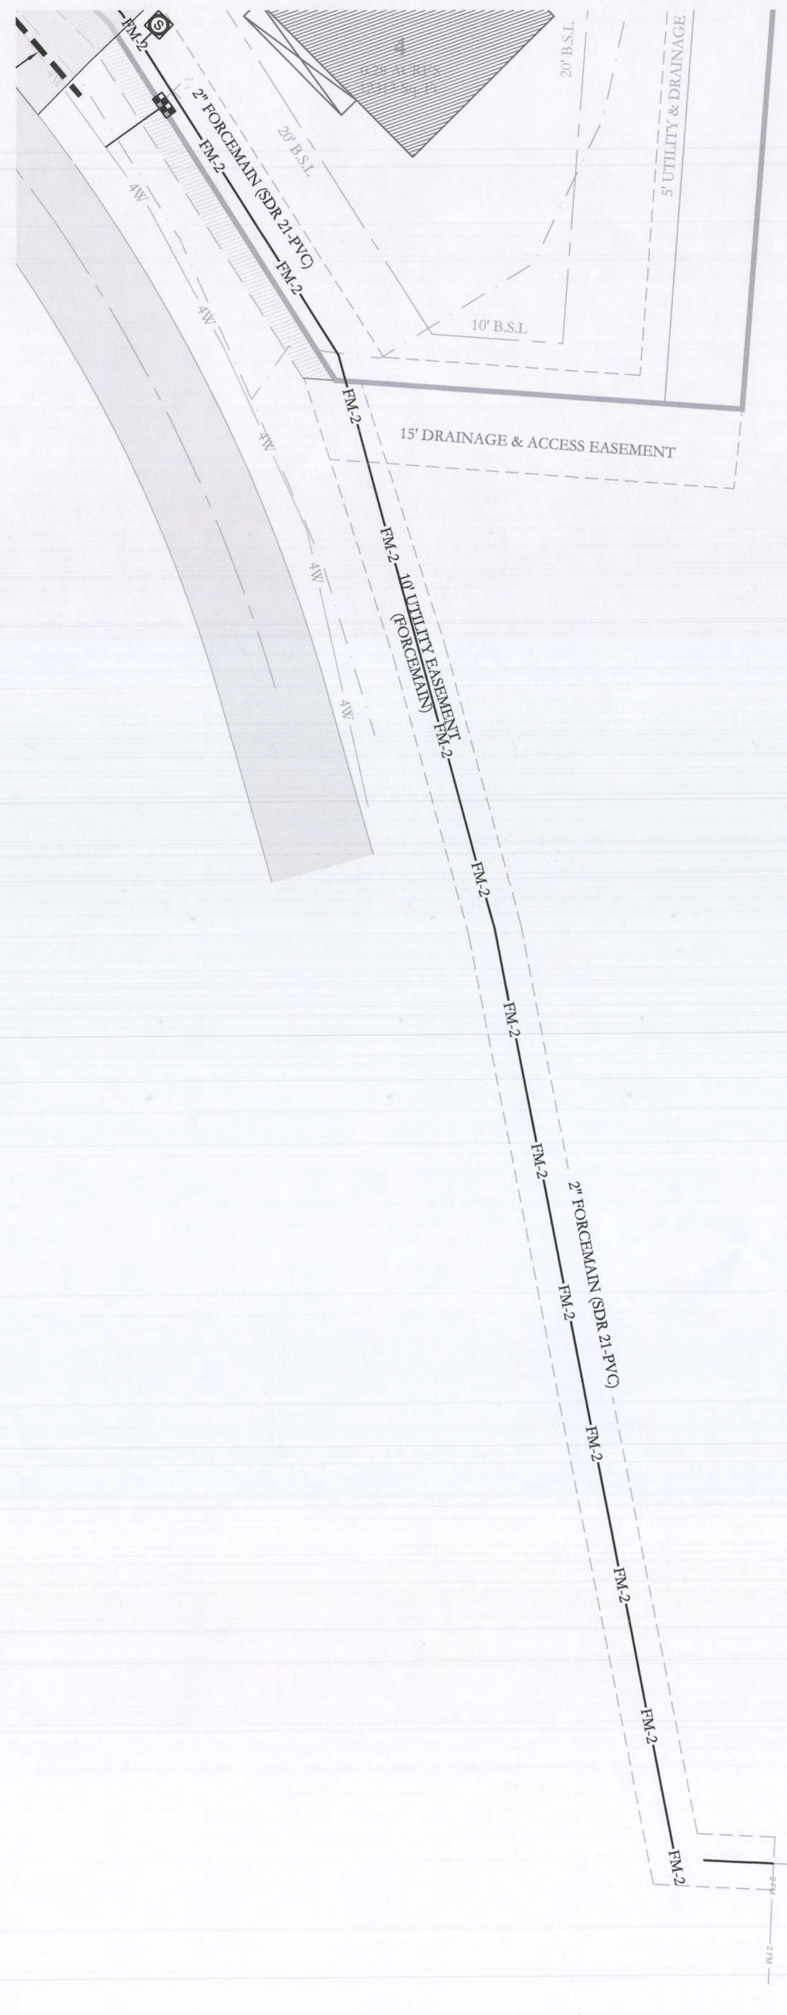

VICINITY MAP:

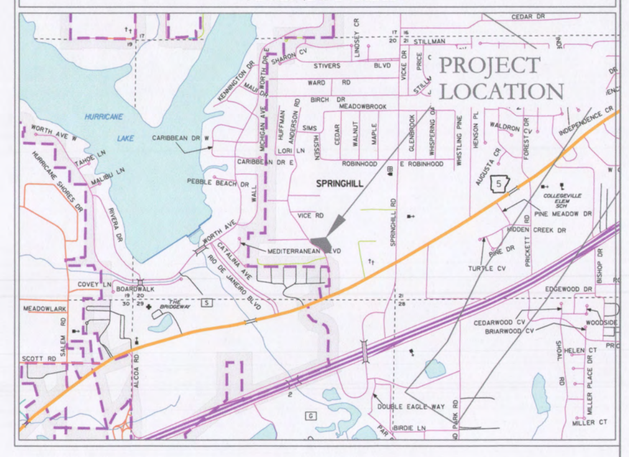

WATER LEGEND:		TYPICAL FIRE HYDRANT:
WATER MAIN	2" BLOW OFF	2" BLOW OFF
	GATE VALVE	REDUCER 6"
	REDUCER	6"
	FIRE HYDRANT	GATE VALVE
	DOUBLE WATER SERVICE	FIRE HYDRANT (2 TO 6 FEET FROM EDGE OF PAVEMENT)
	SINGLE WATER SERVICE	

NOTE:
ALL FIRE HYDRANT LEADERS HAVE A GATE VALVE BETWEEN MAIN AND FIRE HYDRANT.

SEWER LEGEND:

GRINDER PUMP — 2" SEWER MAIN FM-2

STATE OF ARKANSAS
LICENSED PROFESSIONAL ENGINEER
No. 20876
MATTHEW D. MANZIDUL
07/30/25

811 Know what's below. Call before you dig.

HOPE CONSULTING
ENGINEERS - SURVEYORS
129 N. Main Street,
Benton, Arkansas 72015
PH. (501)315-2626
FAX (501) 315-0024
www.hopeconsulting.com

FOR USE AND BENEFIT OF:
SKY BLUE, LLC.

SANITARY SEWER & WATER AS-BUILTS
SKY BLUE DUPLEXES
CITY OF BRYANT, SALINE COUNTY, ARKANSAS

DATE:	06-23-2025	C.A.D. BY:	DRAWING NUMBER:
REVISED:	07-30-2025	CHECKED BY:	19-0066
SHEET:		SCALE:	

K:\LAND PROJECTS 2004\SUBDIVISIONS 2019\19-0066 BISSENET DUPLEXES (SWO)\AS-BUILTS\19-0066-AS-BUILTS.DWG