

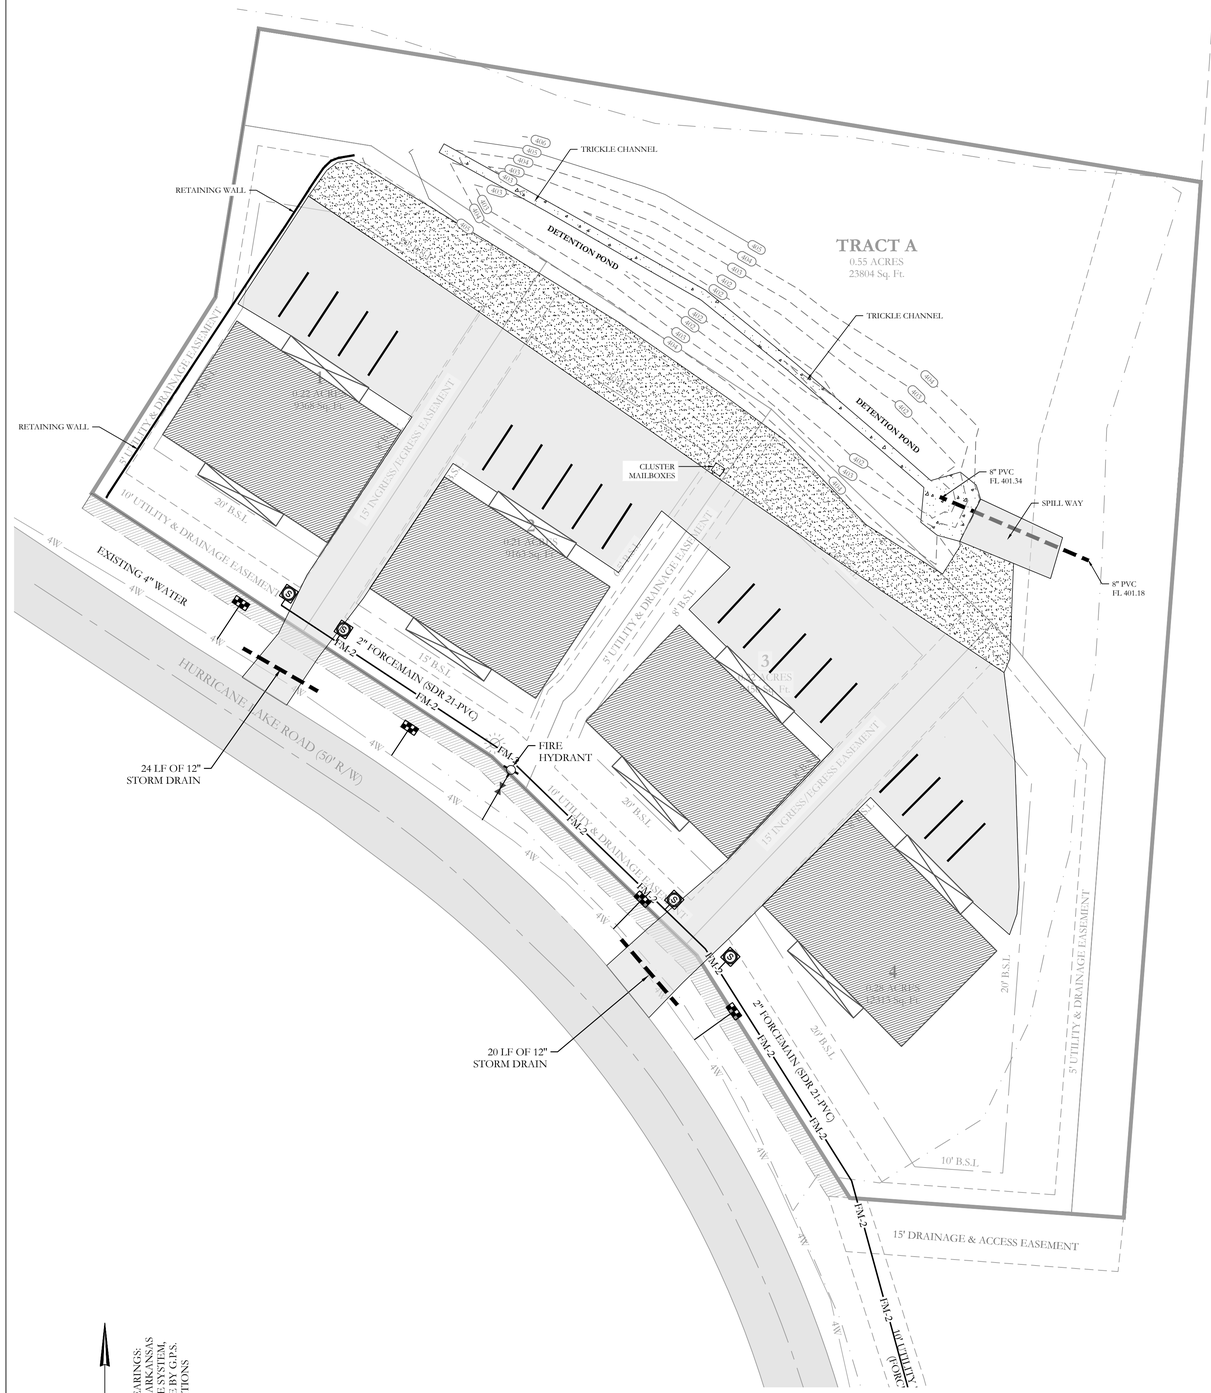


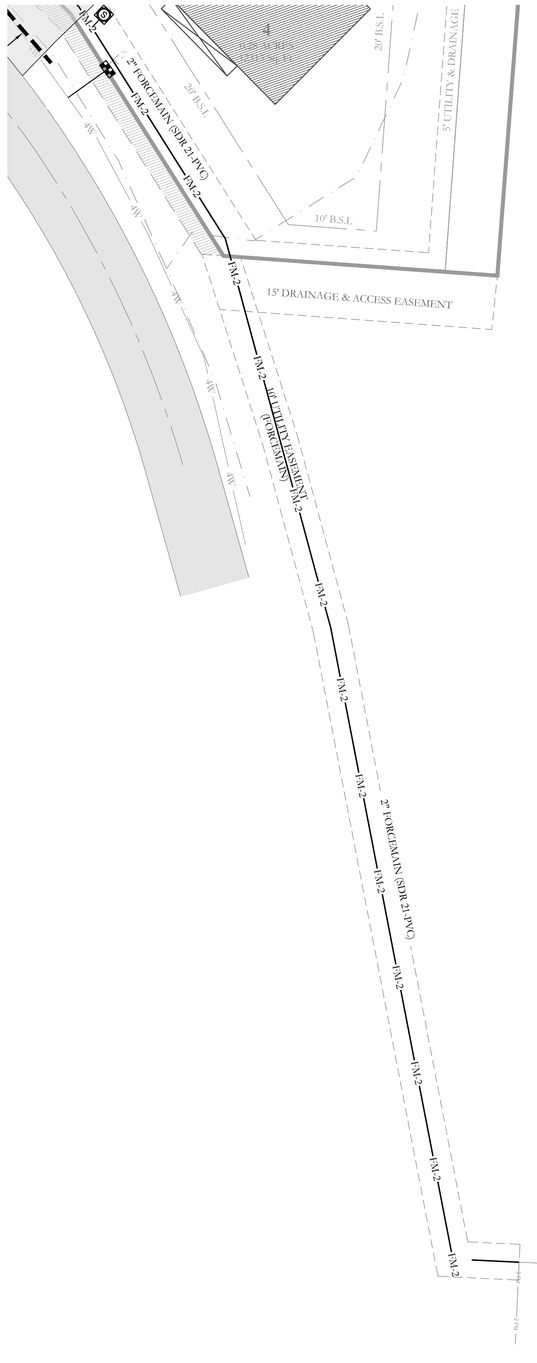

VICINITY MAP:

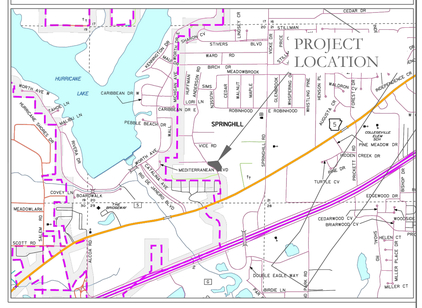

WATER LEGEND:	TYPICAL FIRE HYDRANT:
2" BLOW OFF WATER MAIN — WV — GATE VALVE REDUCER FIRE HYDRANT DOUBLE WATER SERVICE SINGLE WATER SERVICE NOTE: ALL FIRE HYDRANT LEADERS HAVE A GATE VALVE BETWEEN MAIN AND FIRE HYDRANT.	2" BLOW OFF REDUCER 6" 6" GATE VALVE FH FIRE HYDRANT (2 TO 6 FEET FROM EDGE OF PAVEMENT)

SEWER LEGEND:

GRINDER PUMP — 2" SEWER MAIN — FM-2

BASIS OF BEARINGS:
GRID NORTH, ARKANSAS
COORDINATE SYSTEM,
SOUTH ZONE BY G.P.S.
OBSERVATIONS

20' 10' 0 20'

HOPE CONSULTING
ENGINEERS - SURVEYORS
129 N. Main Street,
Benton, Arkansas 72015
PH. (501)315-2626
FAX (501) 315-0024
www.hopeconsulting.com

STATE OF ARKANSAS
LICENSED PROFESSIONAL ENGINEER
NO. 20870
TIMOTHY D. HOPE
08-11-2025

Know what's below. Call before you dig.

FOR USE AND BENEFIT OF:
SKY BLUE, LLC.

SANITARY SEWER & WATER AS-BUILTS
SKY BLUE DUPLEXES
CITY OF BRYANT, SALINE COUNTY, ARKANSAS

DATE:	06-23-2025	C.A.D. BY:	DRAWING NUMBER:
REVISED:	08-11-2025	CHECKED BY:	19-0066
SHEET:		SCALE:	

K:\LAND PROJECTS 2004\SUBDIVISIONS\2019\19-0066 BESSENT DUPLEXES\DWG\AS-BUILTS\19-0066-AS-BUILTS.DWG