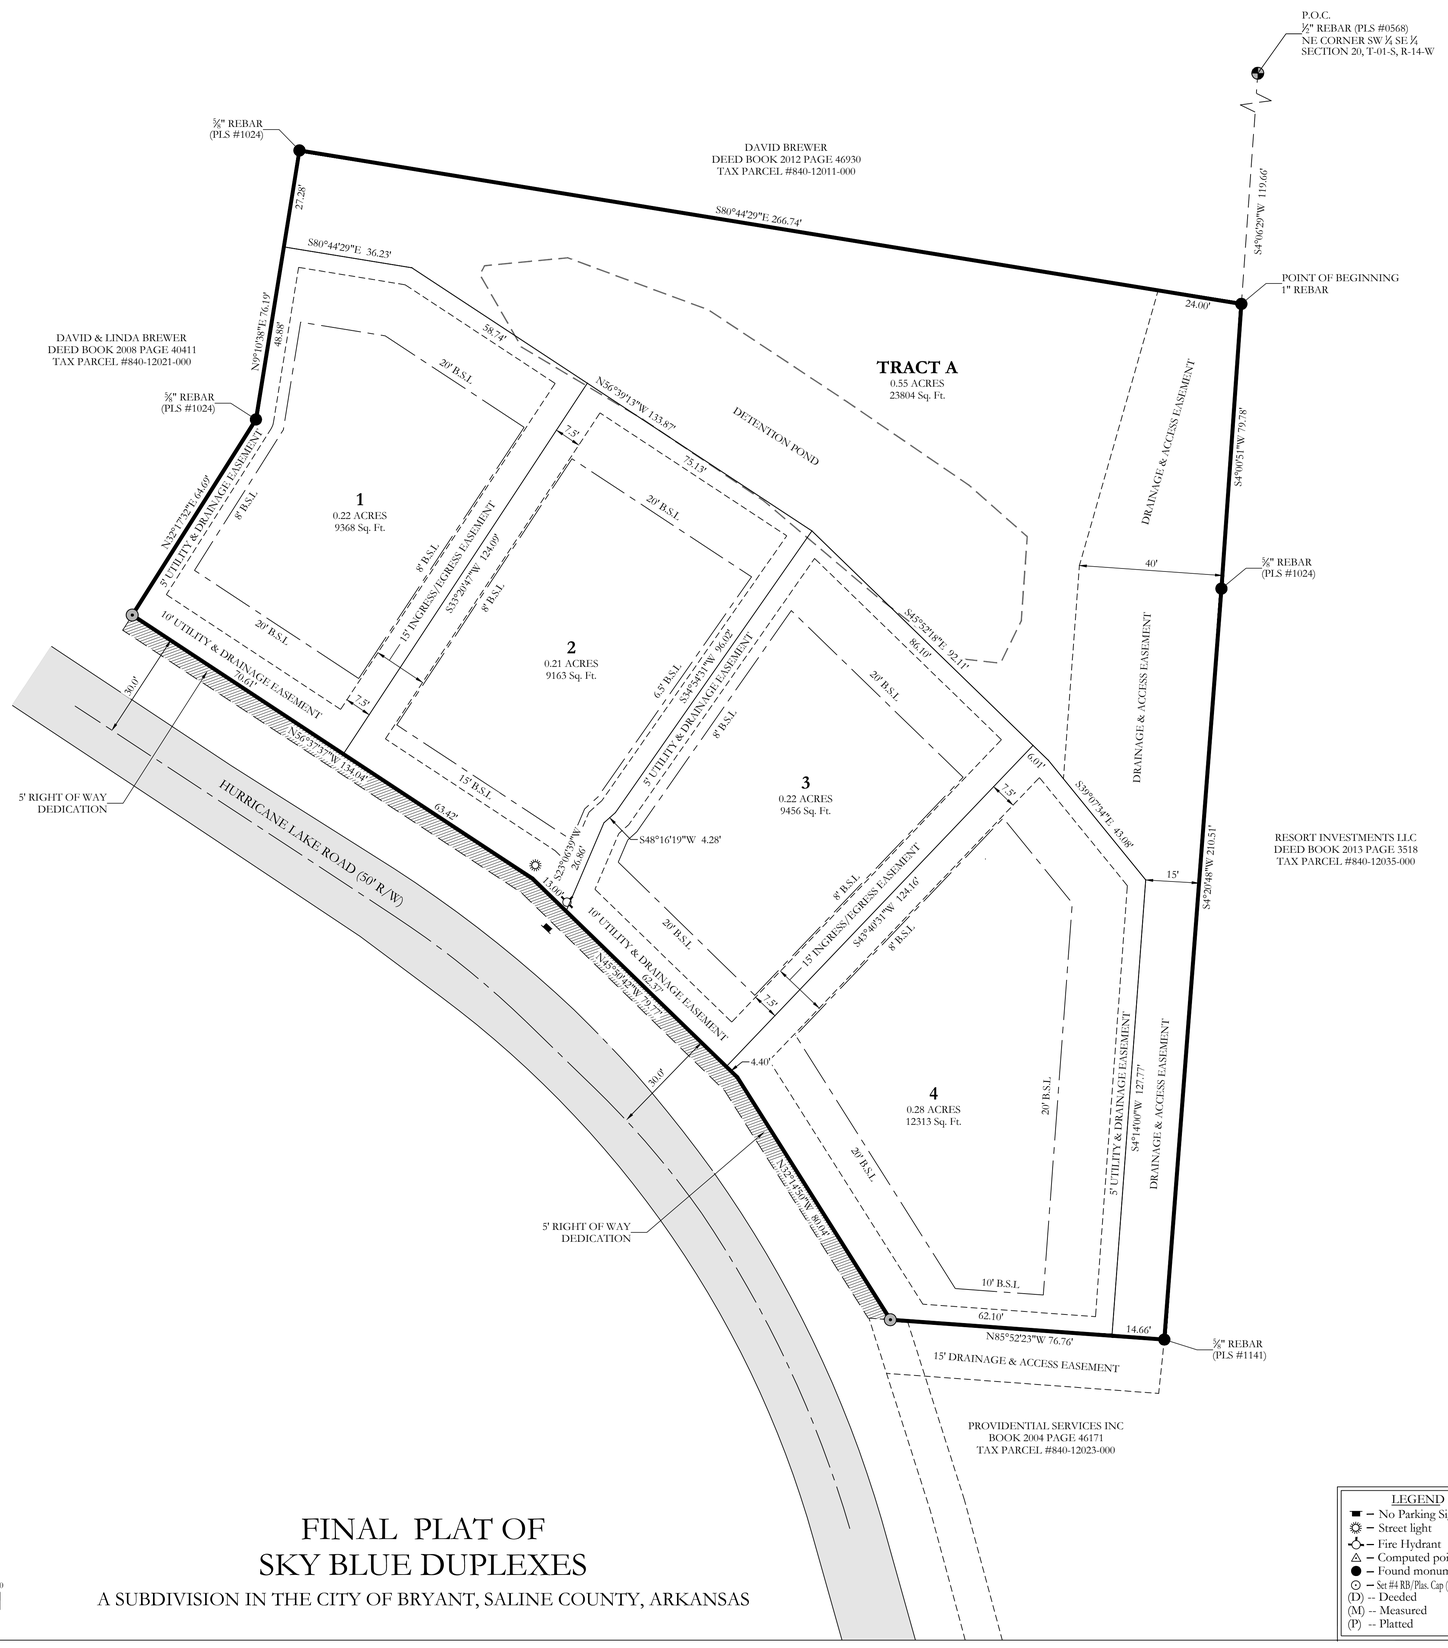


FINAL PLAT OF SKY BLUE DUPLEXES

A SUBDIVISION IN THE CITY OF BRYANT, SALINE COUNTY, ARKANSAS

CERTIFICATIONS:

OWNER:

Name: FAIT ROAD II, LLC
Address: P.O. BOX 10
BRYANT, AR 72022

DEVELOPER:

Name: FAIT ROAD II, LLC
Address: P.O. BOX 10
BRYANT, AR 72022

CERTIFICATE OF OWNER:

We, the undersigned, owners of the real estate shown and described herein do hereby certify that we have laid off, platted and subdivided, and do hereby lay off, plat and subdivide said real estate in accordance with the within plat.

Date of Execution

Name:

Source of Title: 2015-7766

CERTIFICATE OF SURVEYING ACCURACY:

I, Corbitt R. Shoffner,, hereby certify that this plat correctly represents a survey and a plan made by me or under my supervision; that all monuments shown hereon actually exist and their location, size, type and material are correctly shown; and that all interior lot lines have been adjusted to "as built conditions" and are accurately described on the plat and identified on the ground in terms of length and direction of the property side as required in accord with the City of Bryant Subdivision Regulation Ordinance.

8/11/2025
Date of Execution

Corbitt R. Shoffner
Registered Professional
Land Surveyor No. 1664
Arkansas

CERTIFICATE OF FINAL ENGINEERING ACCURACY:

I, Kazi Tamzidual Islam, hereby certify that this plat correctly represents a plat made by me, and that the engineering requirements of the City of Bryant Subdivision Rules and Regulations have been followed.

08-11-2025
Date of Execution

Kazi Tamzidual Islam
Registered Professional
Engineer, No. 20876
Arkansas

CERTIFICATE OF FINAL APPROVAL:

Pursuant to the City of Bryant Subdivision Rules and Regulations, this document was given approval by the Bryant Planning Commission at a meeting held _____, 20 ____. All of the document is hereby accepted, and this certificate executed under the authority of said rules and regulations.

Date of Execution

Lance Penfield,
Bryant Planning Commission

STATE OF ARKANSAS
CORBITT R. SHOFFNER
1664
REGISTERED
PROFESSIONAL LAND SURVEYOR
8/11/25

STATE OF ARKANSAS
LICENSED PROFESSIONAL ENGINEER
KAZI TAMZIDUL ISLAM
NO. 20876
08-11-2025

By affixing my seal and signature, I Corbit R. Shoffner No, 1664, hereby certify that this drawing correctly depicts a survey compiled under my supervision.

NOTE: This survey was based on legal descriptions and title work furnished by others and does not represent a title search.

No portion of the property described hereon lies within the 100 year floodplain, according to the Federal Insurance Rate Map, panel #05125C0360E; Dated: 06/05/2020


AS-SURVEYED DESCRIPTION:

PART OF THE SOUTHWEST QUARTER OF THE SOUTHEAST QUARTER (SW ¼ SE ¼) OF SECTION 20, TOWNSHIP 01 SOUTH, RANGE 14 WEST, SALINE COUNTY, ARKANSAS; MORE PARTICULARLY DESCRIBED AS COMMENCING AT THE NORTHEAST CORNER OF SAID SW ¼ SE ¼ OF SECTION 20; THENCE S04°06'29"W, A DISTANCE OF 119.66 FEET TO THE POINT OF BEGINNING;
THENCE S04°00'51"W, A DISTANCE OF 79.78 FEET;
THENCE S04°20'48"W, A DISTANCE OF 210.51 FEET;
THENCE N85°52'23"W, A DISTANCE OF 76.76 FEET TO A POINT ON THE EAST RIGHT OF WAY LINE OF HURRICANE LAKE ROAD;
THENCE ALONG SAID EAST RIGHT OF WAY LINE OF HURRICANE LAKE ROAD THE FOLLOWING COURSES:
THENCE N32°14'50"W, A DISTANCE OF 80.04 FEET;
THENCE N45°50'42"W, A DISTANCE OF 79.77 FEET;
THENCE N56°37'37"W, A DISTANCE OF 134.04 FEET;
THENCE LEAVING SAID RIGHT OF WAY, N32°17'32"E, A DISTANCE OF 64.69 FEET;
THENCE N09°10'38"E, A DISTANCE OF 76.19 FEET;
THENCE S80°44'29"E, A DISTANCE OF 266.74 FEET TO THE POINT OF BEGINNING.
CONTAINING 64,104 SQUARE FEET, OR 1.47 ACRES, MORE OR LESS.

NOTE:

1. TRACT A WILL BE UTILIZED AS DRAINAGE AND UTILITY EASEMENTS MAINTAINED BY THE PROPERTY OWNERS ASSOCIATION.
2. NO FENCES SHALL BE CONSTRUCTED IN THE DRAINAGE EASEMENT WHERE OPEN DITCHES ARE CONSTRUCTED.
3. THE VARIANCE ON THE FRONT SETBACK FOR LOT 2 WAS APPROVED BY THE BZA ON APRIL 14, 2025. THE VARIANCE ON THE SIDE SETBACK FOR LOT 2 WAS APPROVED BY AN ADMINISTRATIVE VARIANCE GIVEN ON MARCH 11TH, 2025.

VICINITY MAP

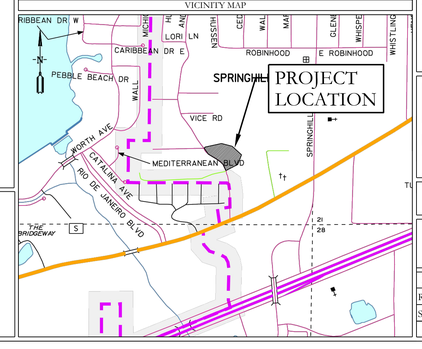

LEGEND
- No Parking Sign
- Street light
- Fire Hydrant
- Computed point
- Found monument
- Set #4 RB/Plas. Cap (SIP)
- (D) -- Deeded
- (M) -- Measured
- (P) -- Platted

PROPERTY SPECIFICATIONS:

OWNER: FAIT ROAD II LLC, PO BOX 10, BRYANT, AR 72022
DEVELOPER/ SUBDIVIDER: FAIT ROAD II LLC, PO BOX 10, BRYANT, AR 72022
ENGINEERS: HOPE CONSULTING INC. 117 S. MARKET STREET BENTON, AR 72015
NAME OF SUBDIVISION: SKY BLUE DUPLEXES
INSTRUMENT # 2015-7766
ZONING: R-M

AVERAGE LOT SIZE: 10,075 SQ. FT.
MINIMUM LOT SIZE: 6,000 SQ. FT.
NUMBER OF LOTS: 4

SOURCE OF WATER: WATER USERS
SOURCE OF SEWER: CITY OF BRYANT
SOURCE OF ELECTRIC: ENTERGY

BUILDING SETBACKS:
FRONT-20' OR AS SHOWN
REAR-20' OR AS SHOWN
SIDE-6' OR AS SHOWN

UTILITY & DRAINAGE EASEMENTS:
FRONT-10' OR AS SHOWN
REAR - 5' OR AS SHOWN
SIDE - 5' OR AS SHOWN

HOPE CONSULTING
ENGINEERS - SURVEYORS
129 N. Main Street,
Benton, Arkansas 72015
PH. (501)315-2626
FAX (501) 315-0024
www.hopeconsulting.com

FOR USE AND BENEFIT OF:
FAIT ROAD II, LLC

FINAL PLAT
SKY BLUE DUPLEXES
A SUBDIVISION IN THE CITY OF BRYANT, SALINE COUNTY, ARKANSAS

DATE:	06-23-2025	C.A.D. BY: B.JOHNSON	DRAWING NUMBER:
REVISED:	08-11-2025	CHECKED BY:	19-0066
SHEET:		SCALE: 1"=20'	

500	01S	14W	0	20	230	62	1664

© 2025 HOPE CONSULTING ENGINEERS - SURVEYORS. ALL RIGHTS RESERVED. THIS PLAT AND ITS CONTENTS ARE THE PROPERTY OF HOPE CONSULTING ENGINEERS - SURVEYORS AND SHALL NOT BE REPRODUCED, COPIED, OR USED IN ANY MANNER WITHOUT WRITTEN PERMISSION.