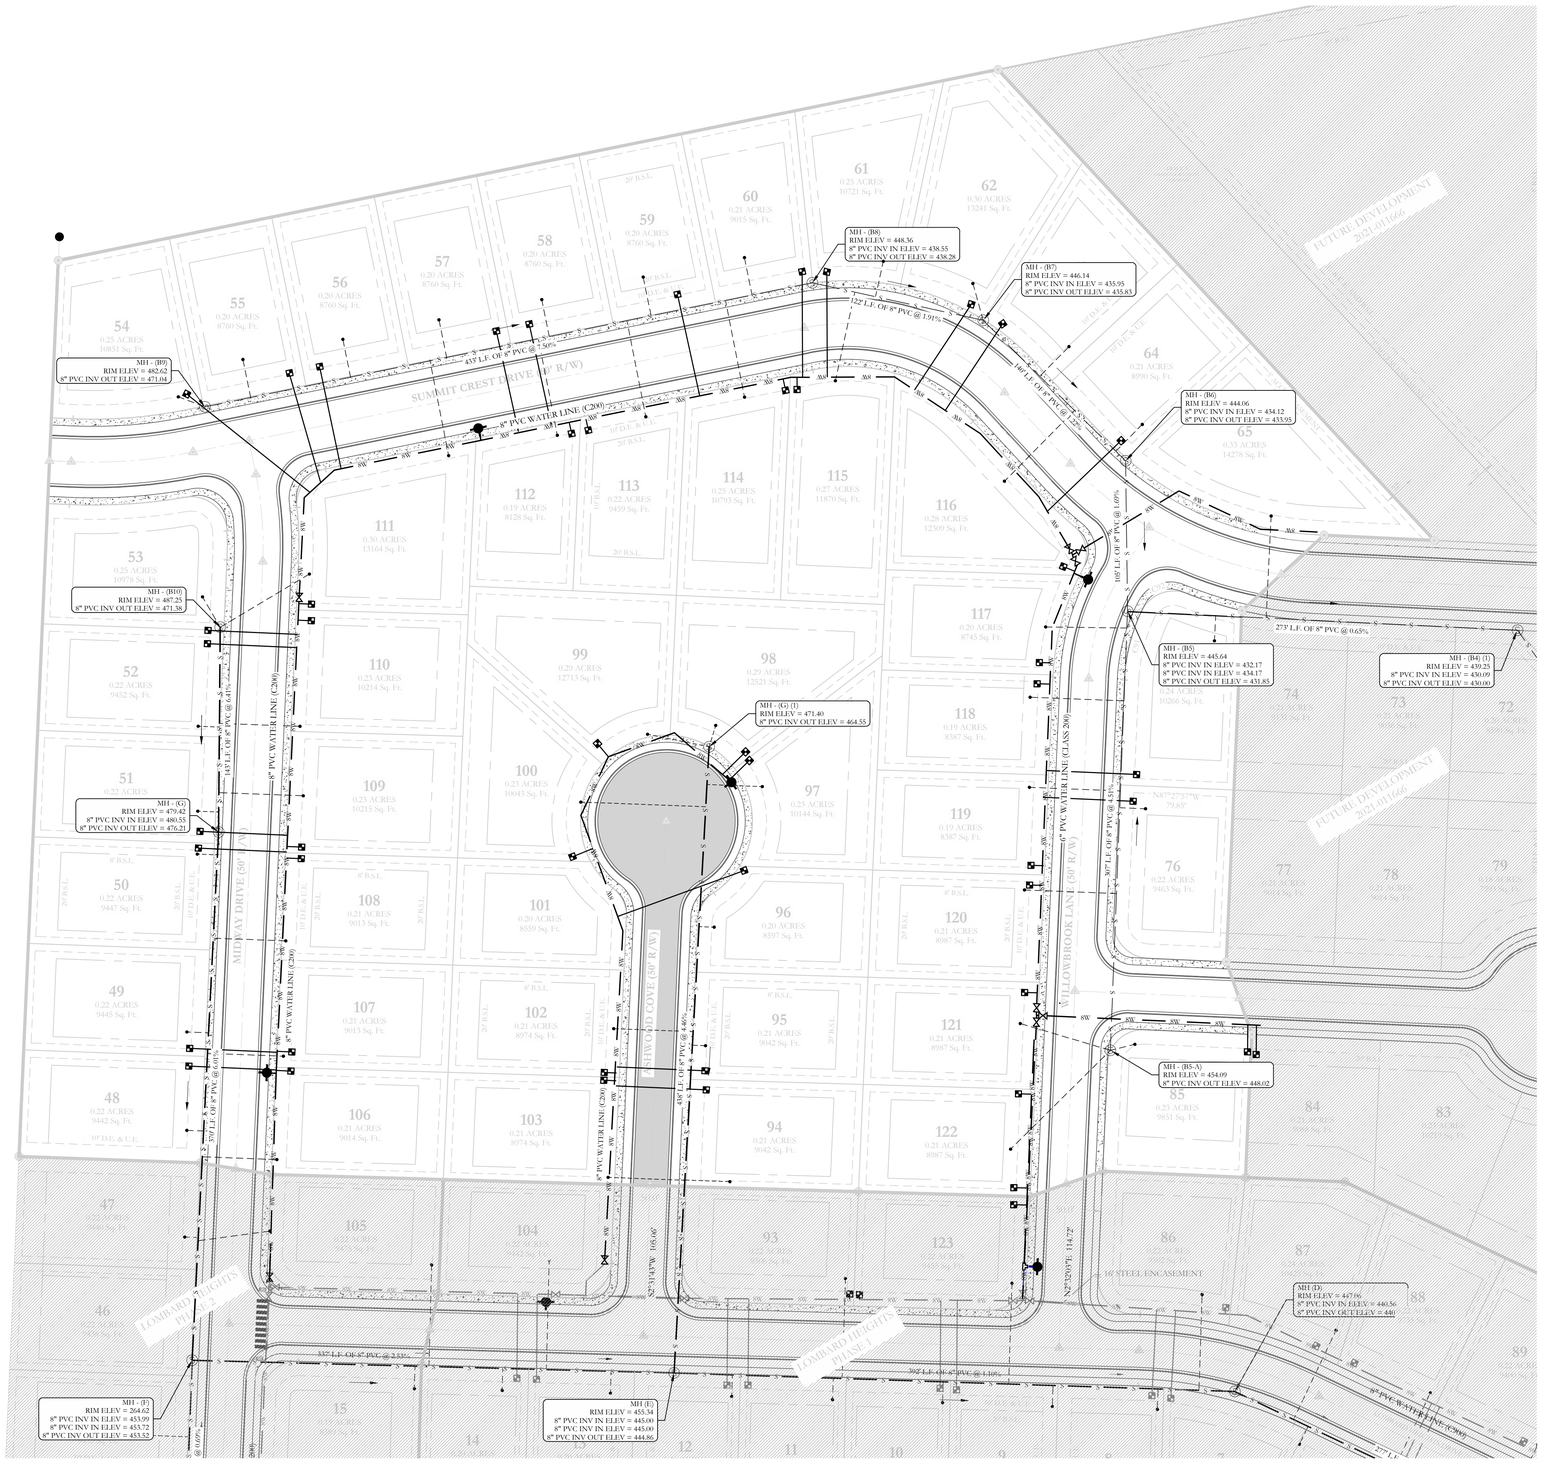


WATER LEGEND:	TYPICAL FIRE HYDRANT:
2" BLOW OFF WATER MAIN — GATE VALVE REDUCER FIRE HYDRANT DOUBLE WATER SERVICE SINGLE WATER SERVICE NOTE: ALL FIRE HYDRANT LEADERS HAVE A GATE VALVE BETWEEN MAIN AND FIRE HYDRANT.	2" BLOW OFF REDUCER 6" 6" GATE VALVE FIRE HYDRANT (2 TO 6 FEET FROM EDGE OF PAVEMENT)

SEWER LEGEND:

SEWER SERVICE
SEWER MAIN — S — S — SEWER MANHOLE

NOTE:
USE SDR-26 PVC SEWER PIPE EXCEPT WHERE DUCTILE IRON PIPE REQUIRED FOR COVER. USE DUCTILE IRON PIPE WHERE 3' MINIMUM COVE CANNOT BE MAINTAINED.

CONTRACTOR IS RESPONSIBLE FOR LOCATING ALL BURIED UTILITIES PRIOR TO CONSTRUCTION.

HOPE CONSULTING
ENGINEERS - SURVEYORS
117 S. Market Street,
Benton, Arkansas 72015
PH. (501)315-2626
FAX (501) 315-0024
www.hopeconsulting.com

FOR USE AND BENEFIT OF:

LOMBARD HEIGHTS

WATER & SEWER AS-BUILTS
LOMBARD HEIGHTS, PHASE 3

A SUBDIVISION IN THE CITY OF BRYANT, SALINE COUNTY, ARKANSAS

DATE: 08/20/2025	C.A.D. BY: BJOHNSON	DRAWING NUMBER:
REVISED:	CHECKED BY:	20-1388
SHEET:	SCALE: AS SHOWN	

K:\Land Dev Jobs\2020\20-1388 Lombard Heights Phase 3\Dwg\20-1388 AS BUILTS.dwg, 8/20/2025 8:47:13 AM, Brad Johnson