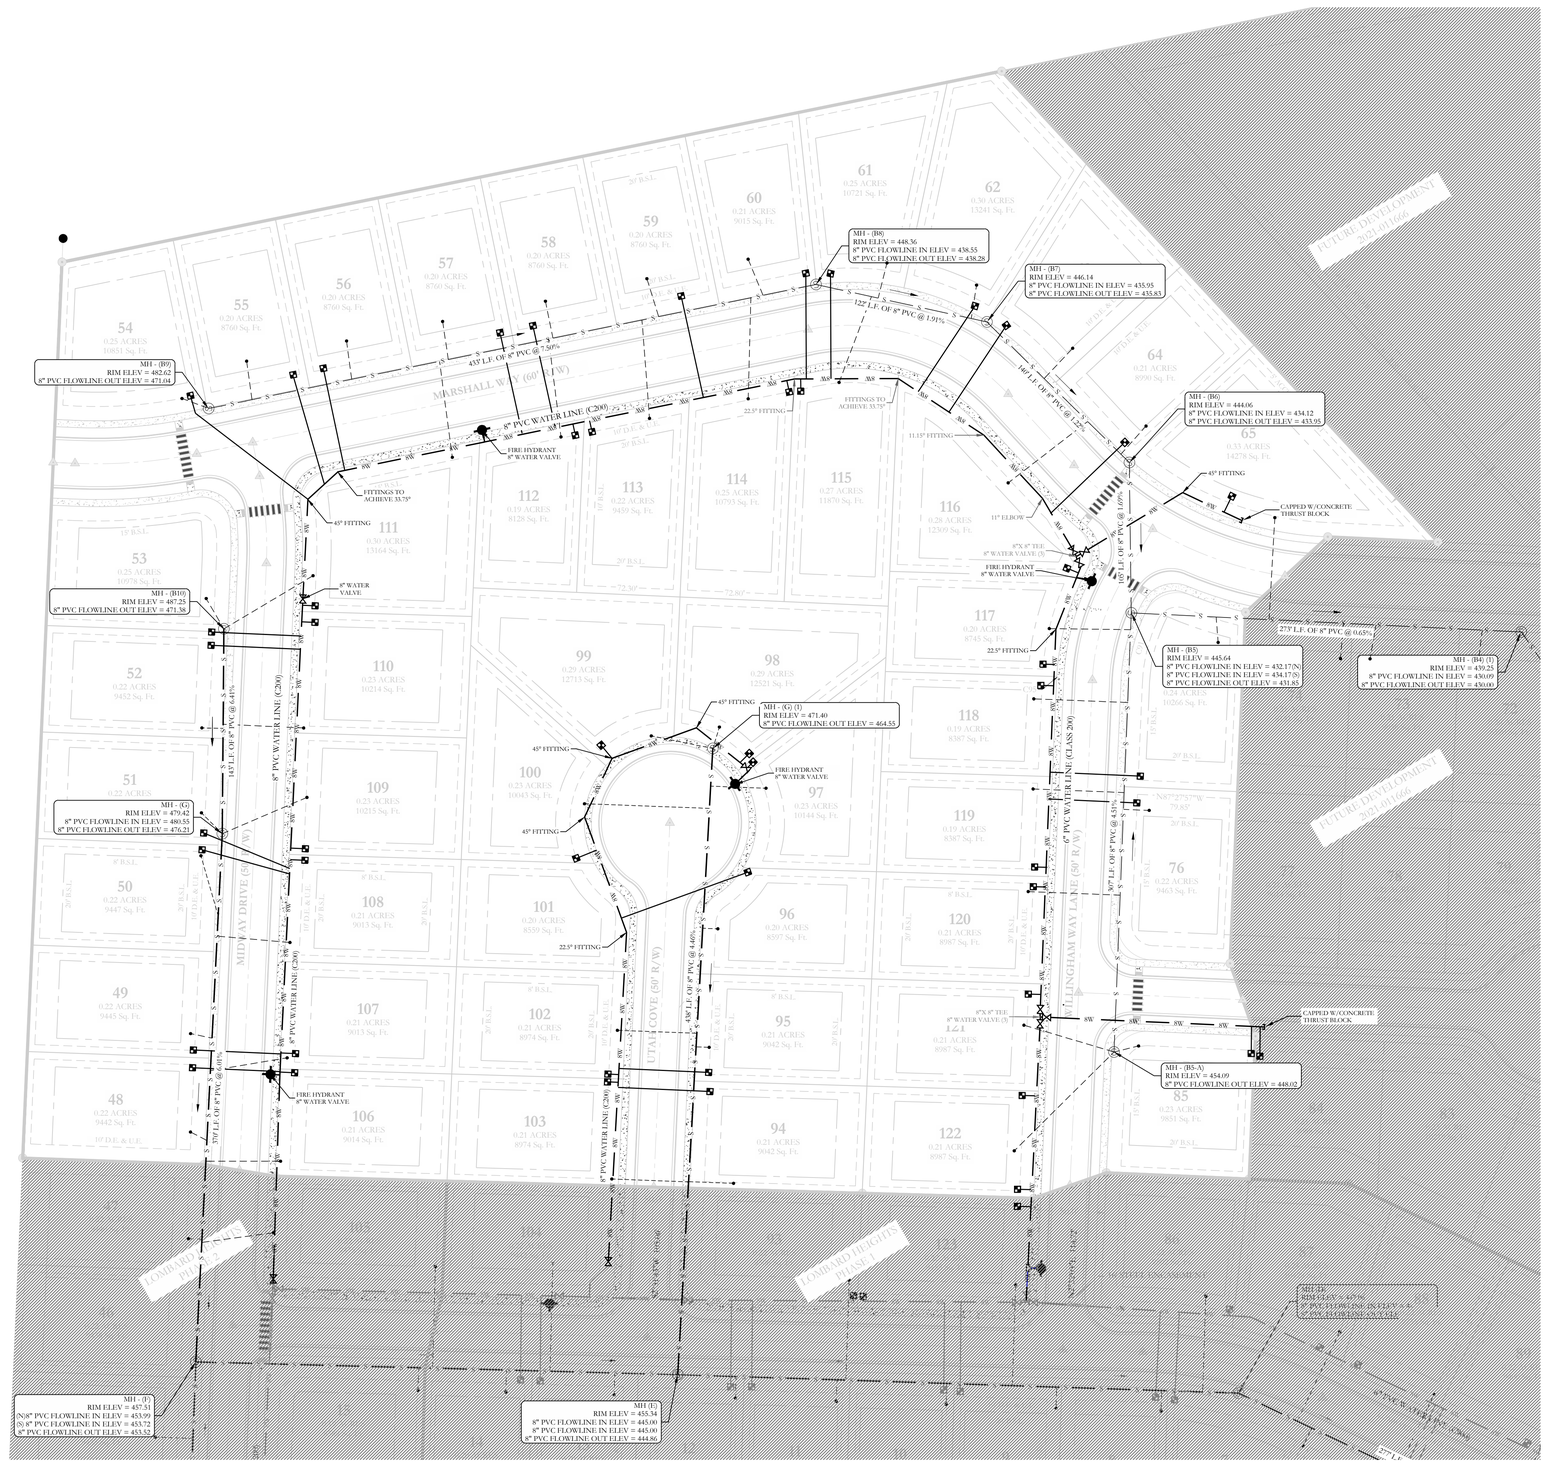


WATER LEGEND:	TYPICAL FIRE HYDRANT:
2" BLOW OFF WATER MAIN — GATE VALVE REDUCER FIRE HYDRANT DOUBLE WATER SERVICE SINGLE WATER SERVICE	2" BLOW OFF REDUCER 6" 6" GATE VALVE FIRE HYDRANT (2 TO 6 FEET FROM EDGE OF PAVEMENT)

NOTE:
SET FIRE HYDRANT LEADERS HAVE A GATE VALVE BETWEEN MAIN AND FIRE HYDRANT.

SEWER LEGEND:

SEWER SERVICE — SEWER MAIN — SEWER MANHOLE

NOTE:
USE SDR-26 PVC SEWER PIPE EXCEPT WHERE DUCTILE IRON PIPE REQUIRED FOR COVER. USE DUCTILE IRON PIPE WHERE 3' MINIMUM COVE CANNOT BE MAINTAINED.

CONTRACTOR IS RESPONSIBLE FOR LOCATING ALL BURIED UTILITIES PRIOR TO CONSTRUCTION.


HOPE CONSULTING
ENGINEERS - SURVEYORS
117 S. Market Street,
Benton, Arkansas 72015
PH. (501)315-2626
FAX (501) 315-0024
www.hopeconsulting.com

FOR USE AND BENEFIT OF:
LOMBARD HEIGHTS

WATER & SEWER AS-BUILTS
LOMBARD HEIGHTS, PHASE 3
A SUBDIVISION IN THE CITY OF BRYANT, SALINE COUNTY, ARKANSAS

DATE:	09/29/2025	C.A.D. BY:	B.JOHNSON	DRAWING NUMBER:
REVISED:	10/20/2025	CHECKED BY:		20-1388
SHEET:		SCALE:	AS SHOWN	

© 2025 Hope Consulting, Inc. This drawing is the property of Hope Consulting, Inc. and is not to be used in any way without the prior written permission of Hope Consulting, Inc.

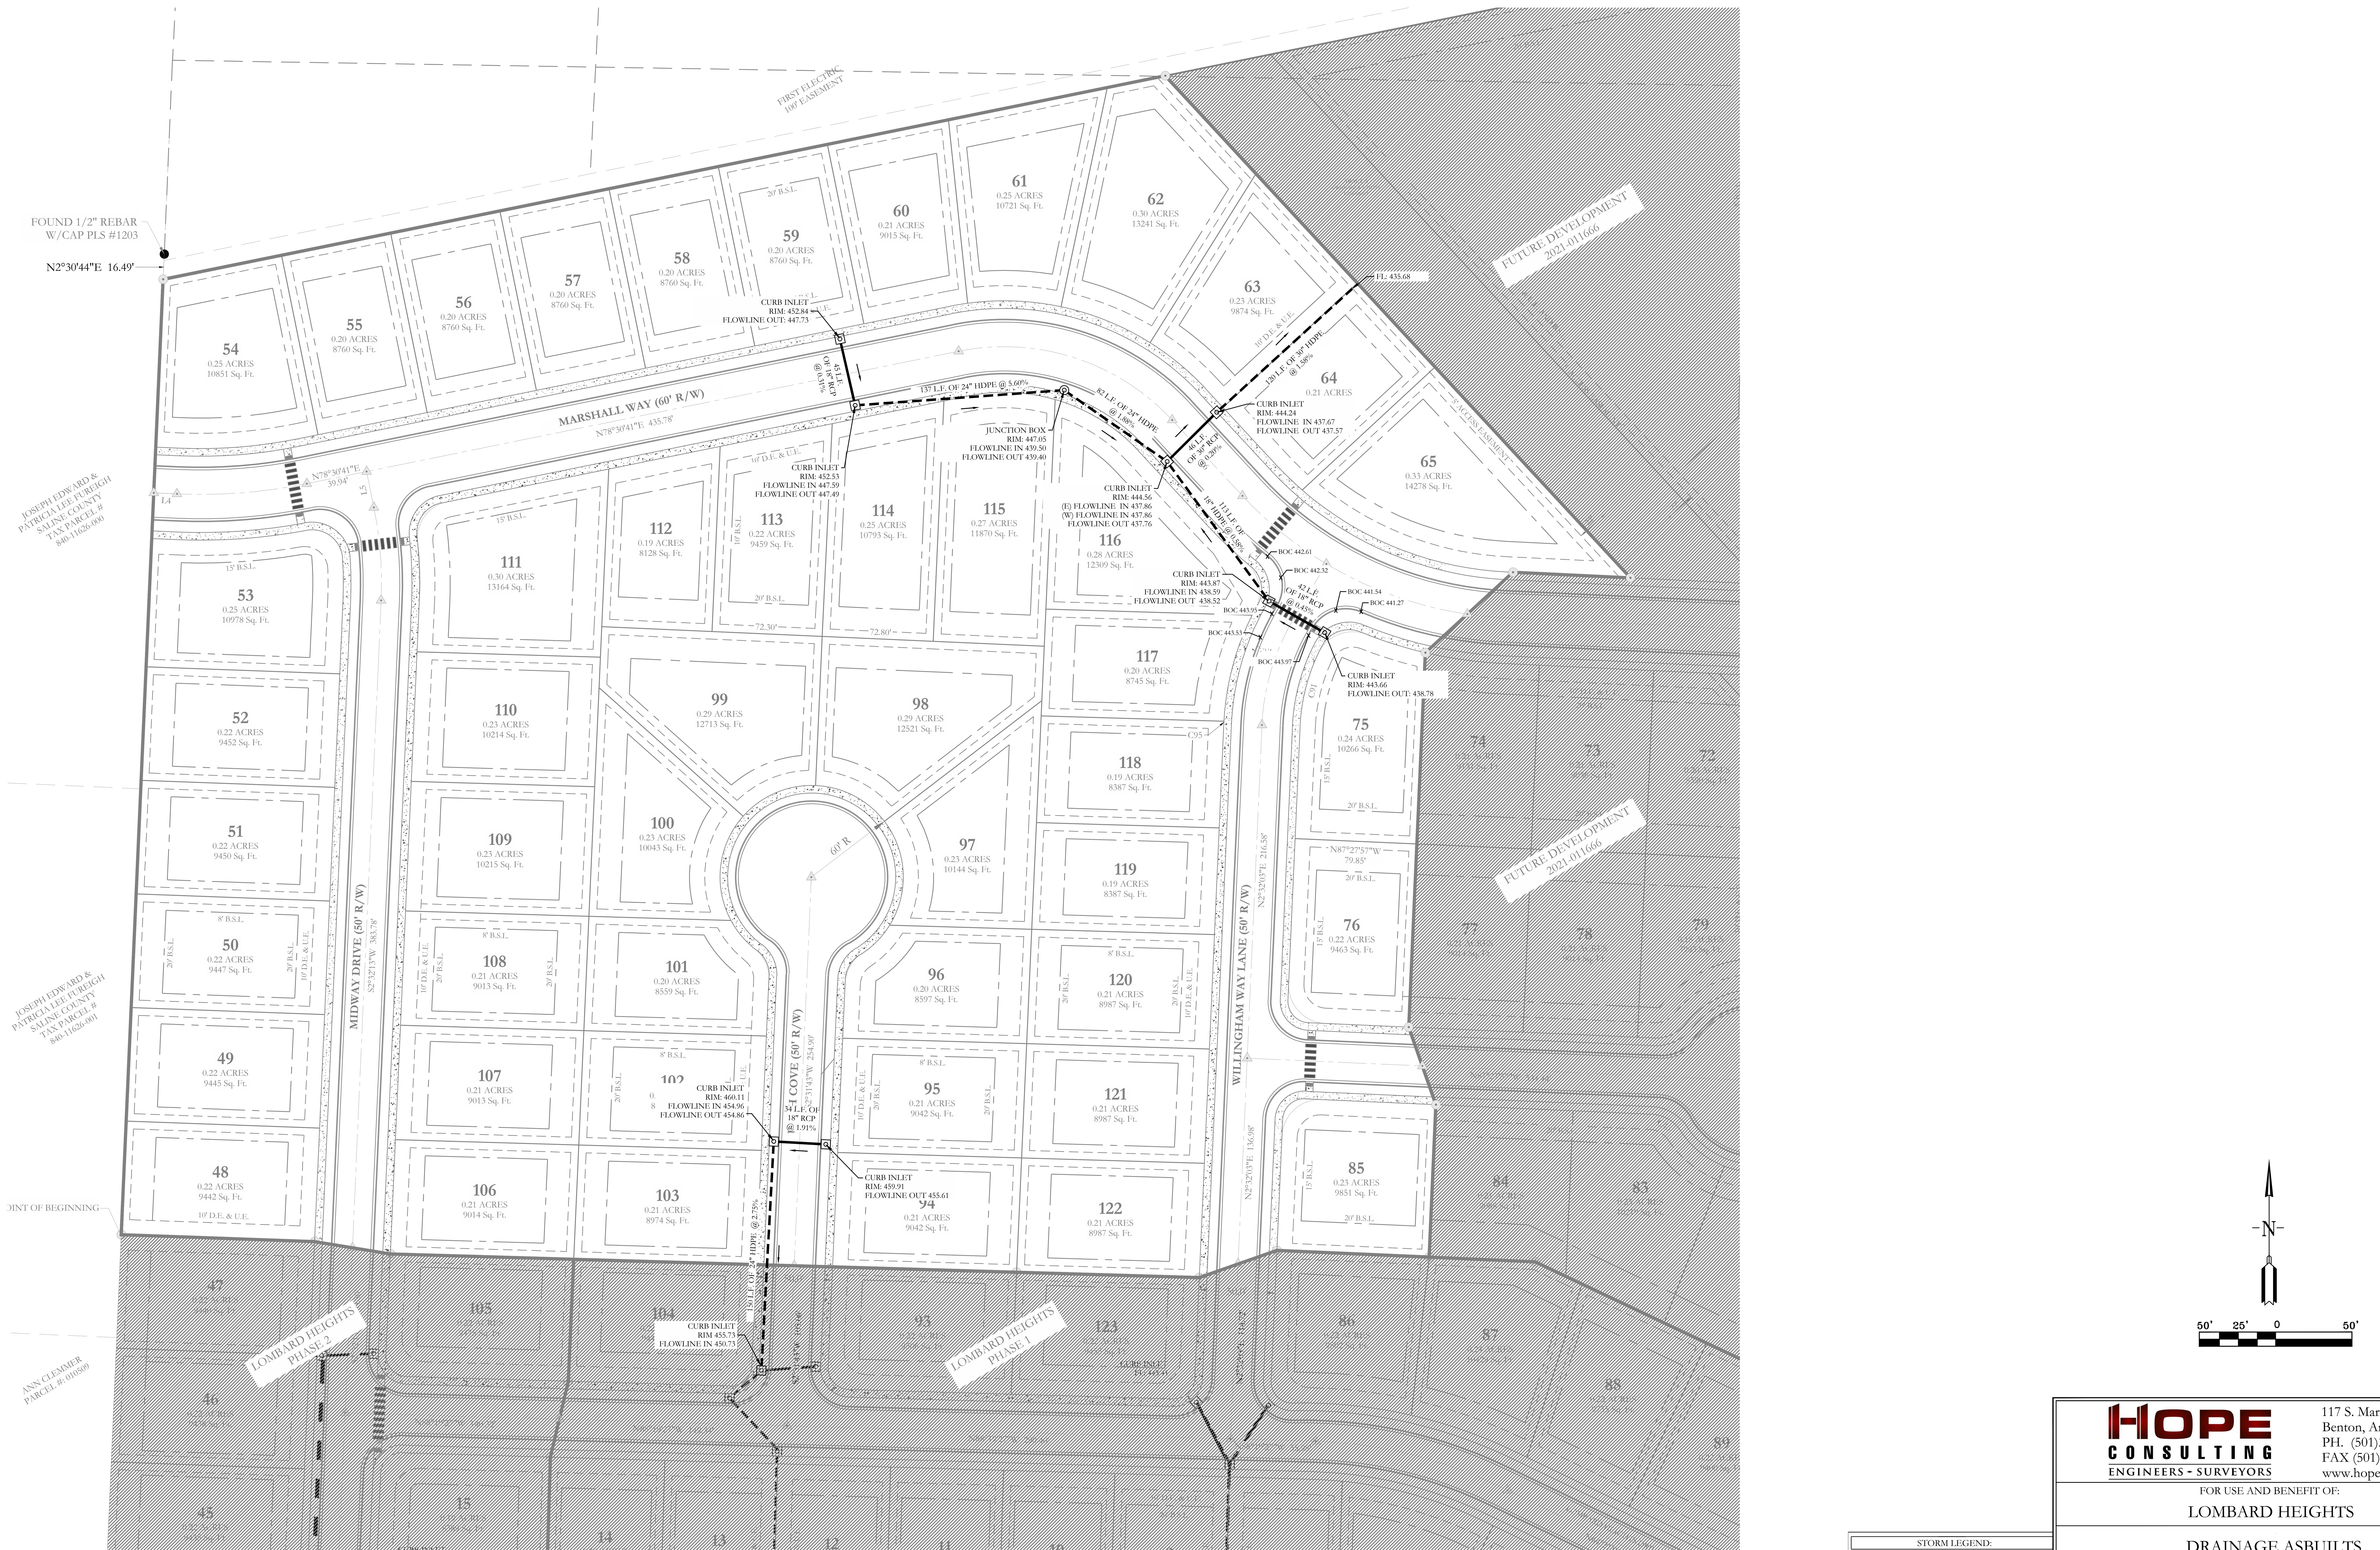

STORM LEGEND:

- RCP
- HDPE
- CURB INLET
- JUNCTION BOX

HOPE CONSULTING
ENGINEERS - SURVEYORS
117 S. Market Street,
Benton, Arkansas 72015
PH. (501)315-2626
FAX (501) 315-0024
www.hopeconsulting.com

FOR USE AND BENEFIT OF:

LOMBARD HEIGHTS

DRAINAGE ASBUILTS
LOMBARD HEIGHTS, PHASE 3

A SUBDIVISION IN THE CITY OF BRYANT, SALINE COUNTY, ARKANSAS

DATE: 09/29/2025	C.A.D. BY: B.JOHNSON	DRAWING NUMBER: 20-1388	
REVISED: 10/20/2025	CHECKED BY:		
SHEET:	SCALE: AS SHOWN		

K:\Land Projects 2004\Subdivisions\2020\20-1388 Lombard Heights\Phase 3\20-1388-AB-P3-10-16-2025.dwg