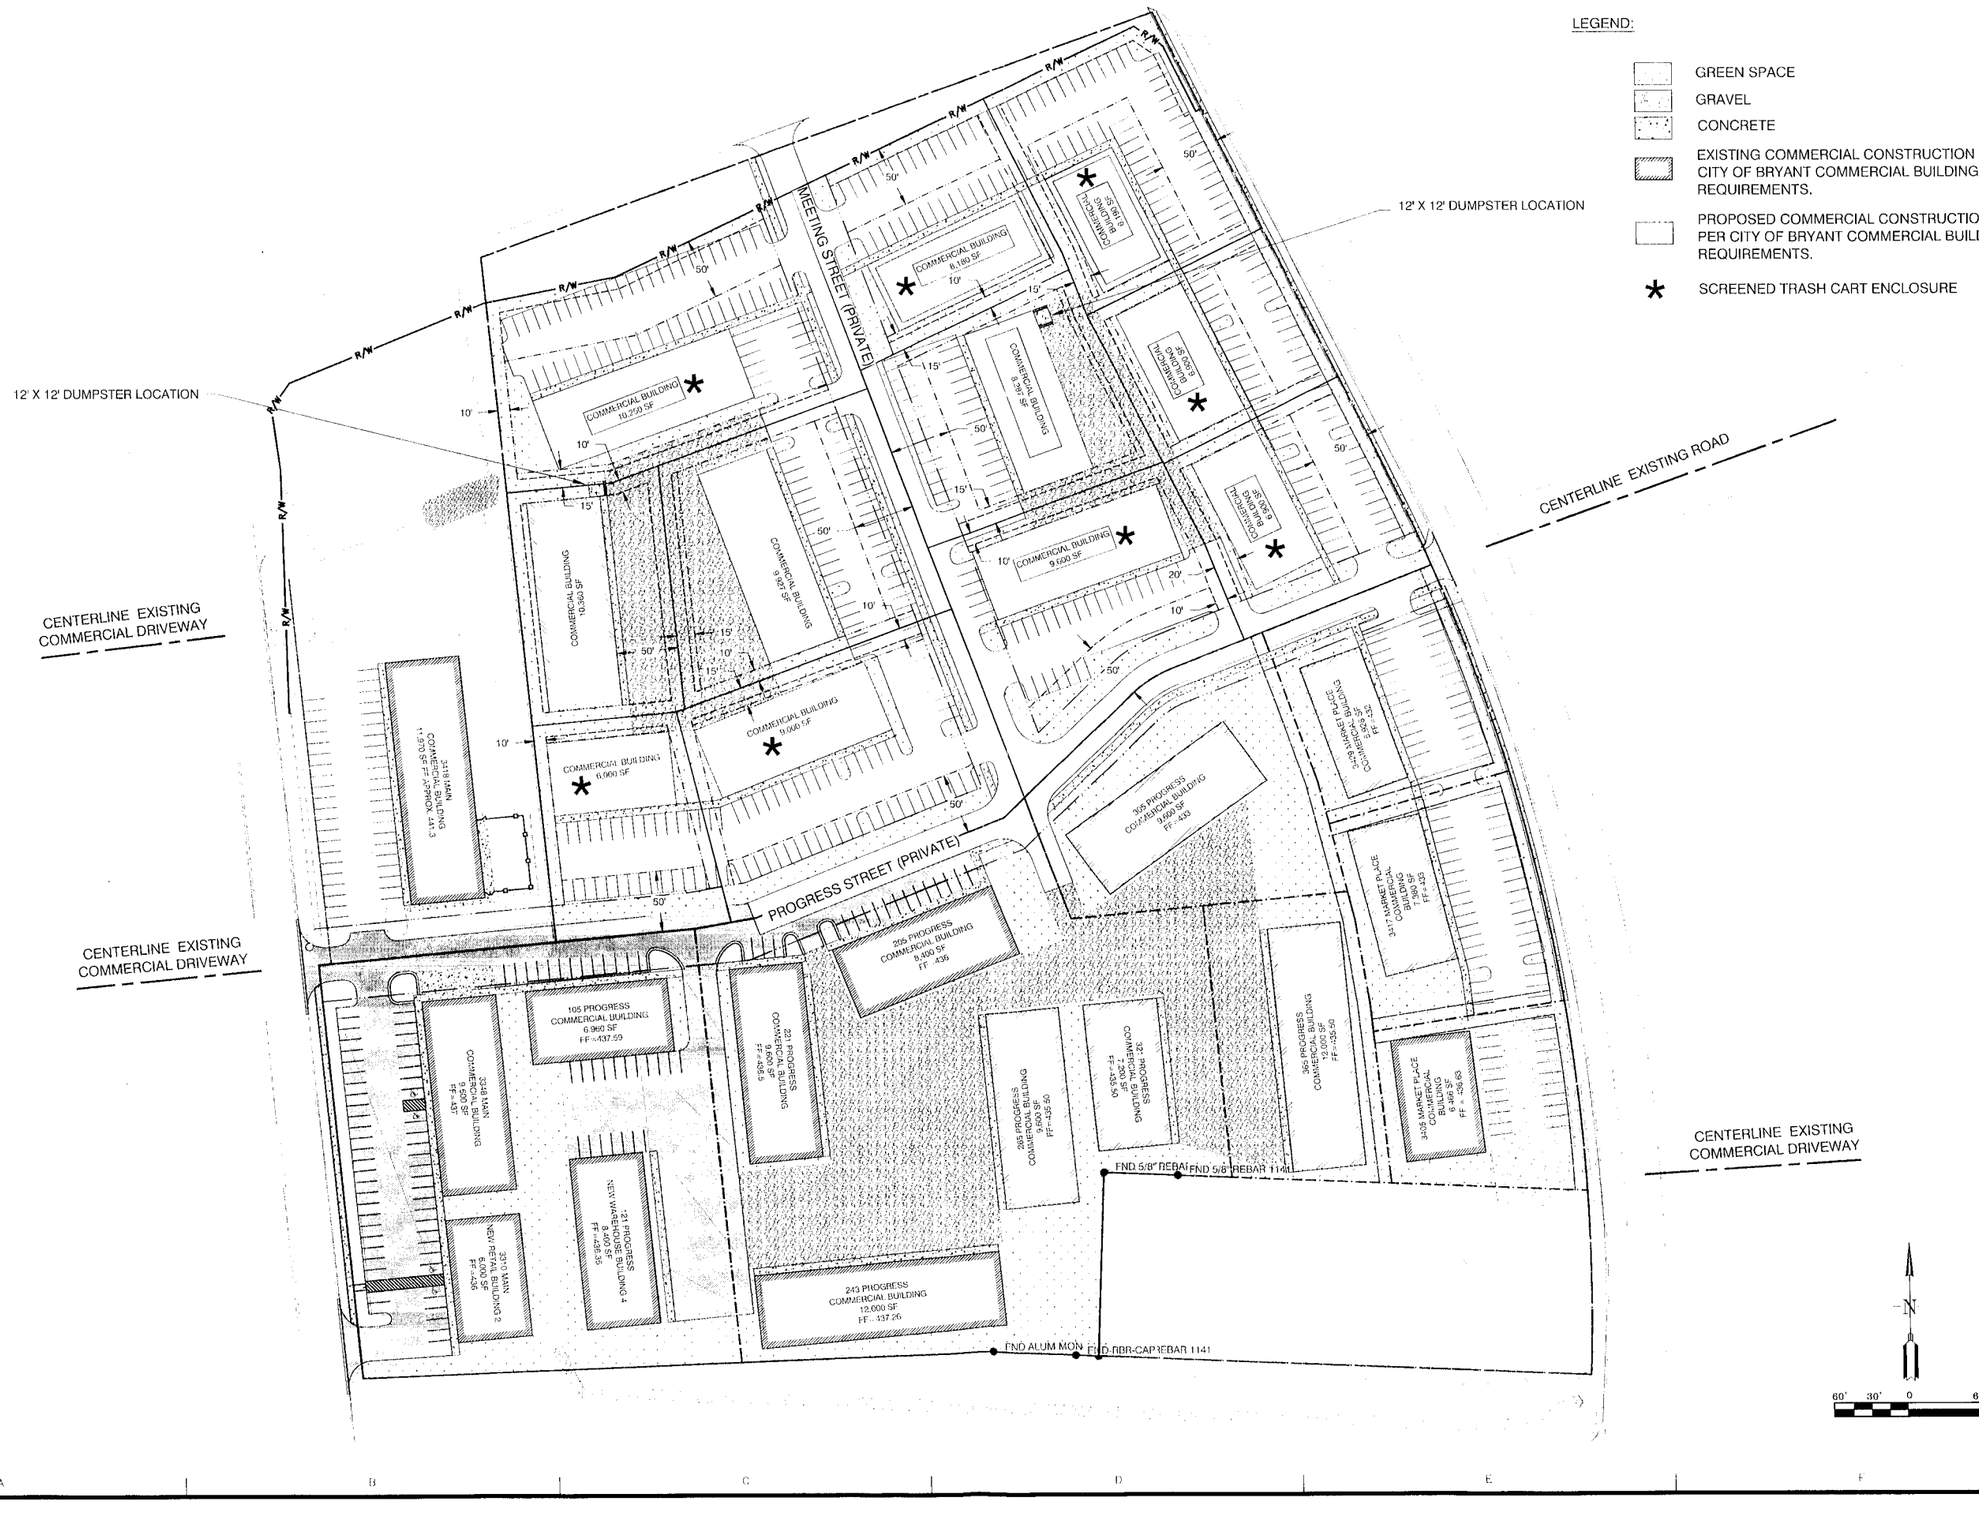


DATE	REVISION	BY
01-25-22	REVISED PER AS-BUILT	GPW

GNE Designing our client's success

GarNat Engineering, LLC
P.O. Box 116
Benton, AR 72018
3825 Mt Carmel Rd
Bryant, AR 72022
garnatengineering@gmail.com
Ph (501) 408-4650

MARKET PLACE CENTER
CITY OF BRYANT
SALINE COUNTY, ARKANSAS

STATE OF ARKANSAS
KEVIN W. WILLIAMS
REGISTERED PROFESSIONAL ENGINEER
NO. 9551

10-27-2022

CONTENTS:
SCHEMATIC PLAN

PROJECT NO: 18087

DATE: OCTOBER 2022

SHEET NO: C3.0

Project 2018 Projects\2018 SPI Projects - Market Place Center Drawings\CAD\Dwgs\C3.0 - SCHEMATIC - 08-17-2018 1:47 PM