
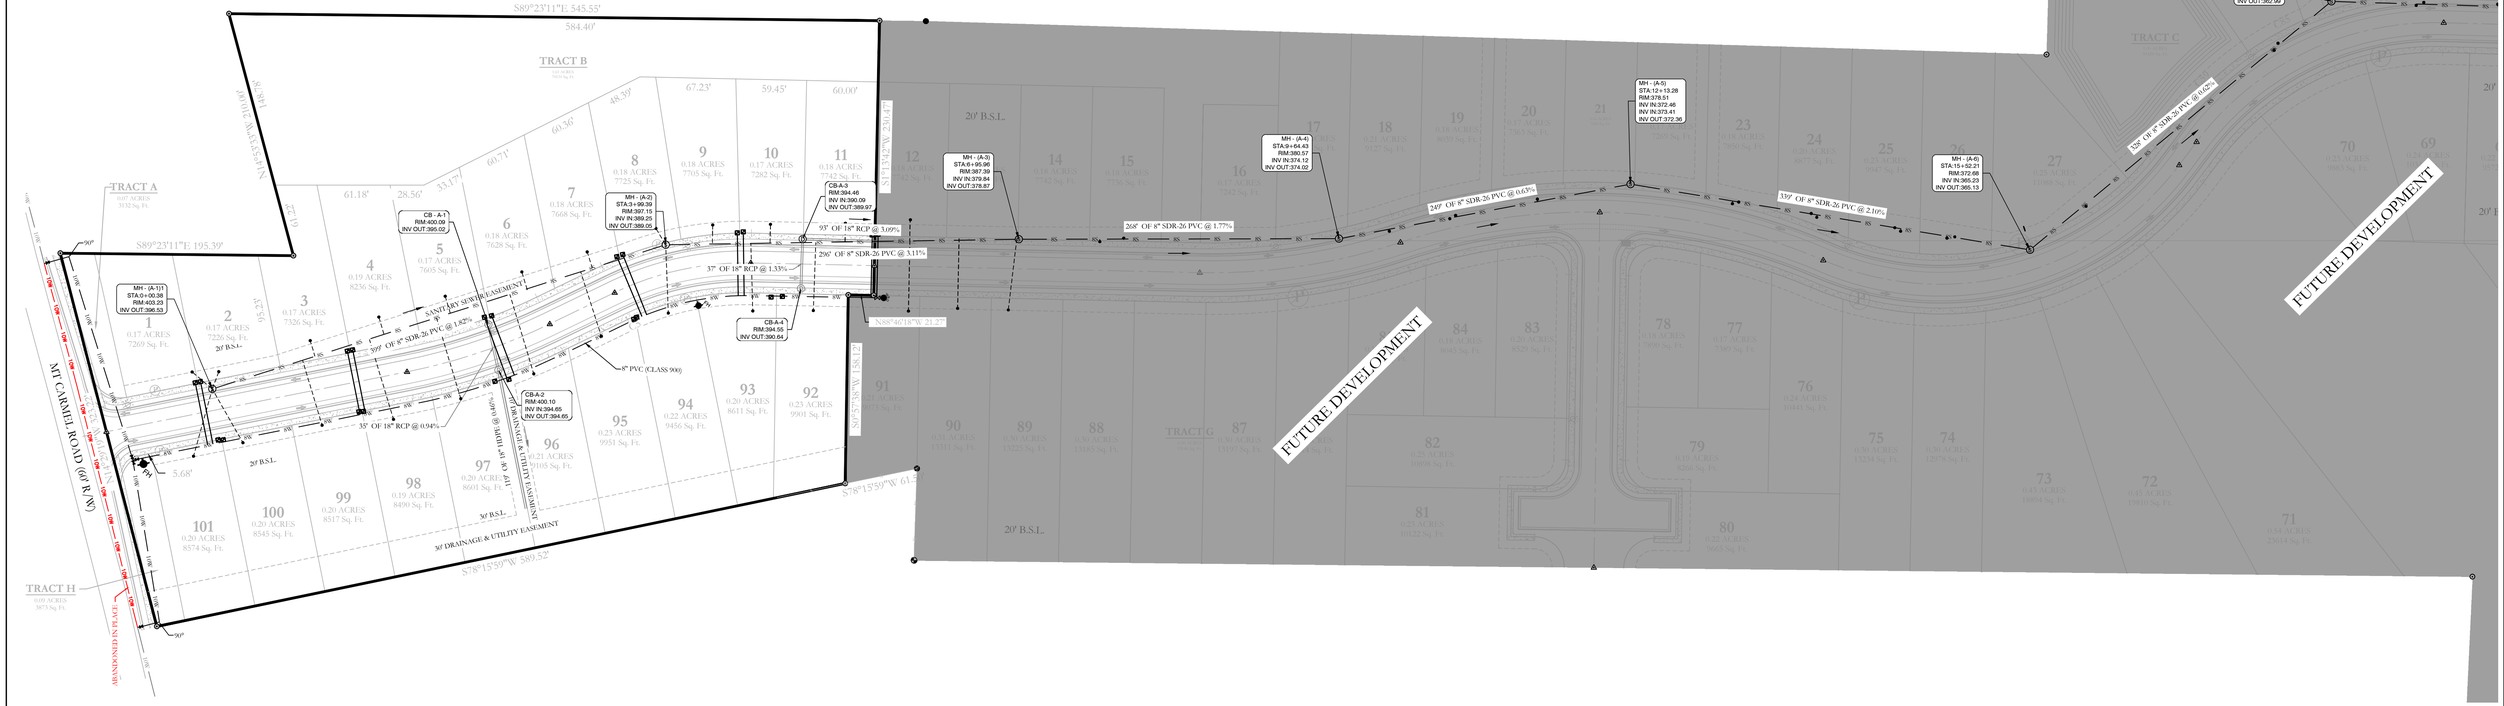


VICINITY MAP:

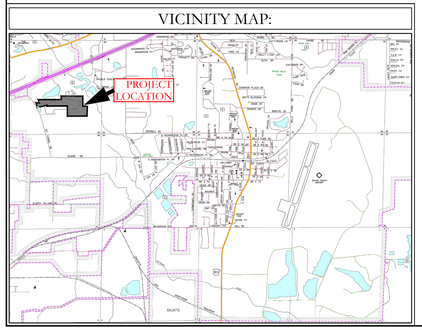

BASIS OF BEARING:
GRID NORTH, ARKANSAS
COORDINATE SYSTEM, SOUTH ZONE BY
GPS OBSERVATION

60' 30' 0 30'

SEWER LEGEND:

SEWER SERVICE
SEWER MAIN
SEWER MANHOLE

NOTE:
USE SDR-26 PVC SEWER PIPE EXCEPT WHERE DUCTILE IRON PIPE REQUIRED FOR COVER. USE DUCTILE IRON PIPE WHERE 3' MINIMUM COVER CANNOT BE MAINTAINED.

CONTRACTOR IS RESPONSIBLE FOR LOCATING ALL BURIED UTILITIES PRIOR TO CONSTRUCTION.

WATER LEGEND:

- DUAL WATER METERS
- SINGLE WATER METER
- GATE VALVE
- 45º FITTING
- 90º FITTING
- TEE FITTING
- CROSS FITTING
- FH — FIRE HYDRANT

HOPE CONSULTING
ENGINEERS - SURVEYORS
117 S. Market Street,
Benton, Arkansas 72015
PH. (501)315-2626
FAX (501) 315-0024
www.hopeconsulting.com

FOR USE AND BENEFIT OF:
TITAN GENERAL CONTRACTORS, LLC

THE VILLAGES AT MAGNOLIA LANE, PHASE 1
SANITARY SEWER, WATER & DRAINAGE AS-BUILTS

A SUBDIVISION IN CITY OF BRYANT, SALINE COUNTY, ARKANSAS

DATE:	1/7/2022	C.A.D. BY:	DRAWING NUMBER:
REVISED:		CHECKED BY:	19-0238
SHEET:		SCALE:	

500	1S	15W	0	34	230	62	1807

K:\LAND PROJECTS 2004\SUBDIVISIONS\2019\19-0238 STARLIGHT VILLAGE\19-0238-PLAR.DWG