Use table below to enter information regarding each sign for approval. Please use each letter to reference each sign rendering in packet.

SIGN	**Type** (Façade, Pole, Monument, other)	**Dimensions** (Height, Length, Width)	**Sqft** (Measurement standards found on Pg.7 of Sign Code)	**Façade Width** (Linear Ft of building façade where wall sign is being installed)	**Height**	
					To Top	To Bottom
A	Canopy	23"h x 219.5"l x 16"d	35.056 sq ft	40ft 6in	14ft 5in	12ft 6in
B	Canopy	23"h x 206"l x 16"d	32.9 sq ft	76ft	14ft 5in	12ft 6in
C	Wall	79.3"h x 56.8"l x 5"d	31.7 sq ft	76ft	8ft	1ft 5in
D						
E						
F						

FRONTELEVATION

1 CHANNEL LETTERS-DETAILS
SCALE: 1/4"=1'

Quantity: 1

A

18' 3-1/2"

~~19' 5 1/8"~~

23"

~~23"~~

GOOD DAY FARM

DAY/NIGHT PERFORATED VINYL

ELECTRICAL TARGET
ON CENTER


ATTACHMENT TO BE CONFIRMED PRIOR TO PRODUCTION

FRONT-LIT CHANNEL LETTERS	
FACE MATERIAL:	3/16" WHITE ACRYLIC
RETURN COLOR:	BLACK
TRIMCAP COLOR:	1" BLACK
ILLUMINATION:	LED WHT INT. ILLUM.
MOUNTING:	AWNING RACEWAY
DEPTH:	5"

~~40.47 SqFt~~

NEEDS TO BE UNDER 36 SF

35.056 SqFt

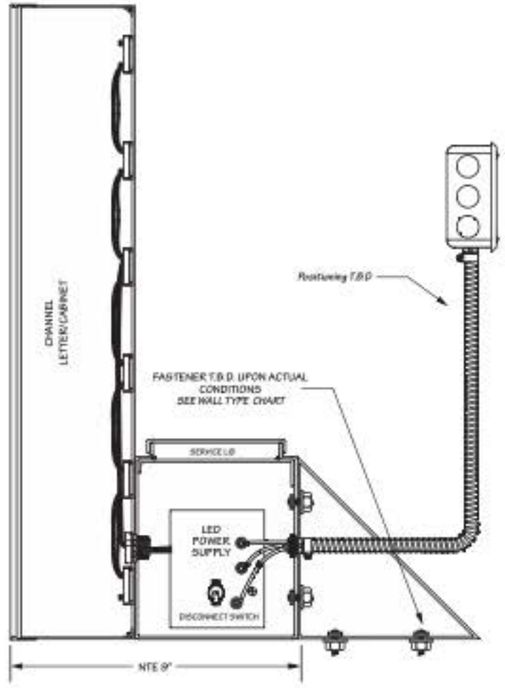





22 ATTACHMENT POINTS

2 CHANNEL LETTERS-DETAILS

SCALE: 1/4"=1'

Quantity: 1

B




FRONT-LIT CHANNEL LETTERS	
FACE MATERIAL:	3/16" WHITE ACRYLIC
RETURN COLOR:	BLACK
TRIMCAP COLOR:	1" BLACK
ILLUMINATION:	LED WHT INT. ILLUM.
MOUNTING:	AWNING RACEWAY
DEPTH:	5"

~~39.08 SqFt~~

NEEDS TO BE UNDER 36 SF

32.9 SqFt

SIDE ELEVATION

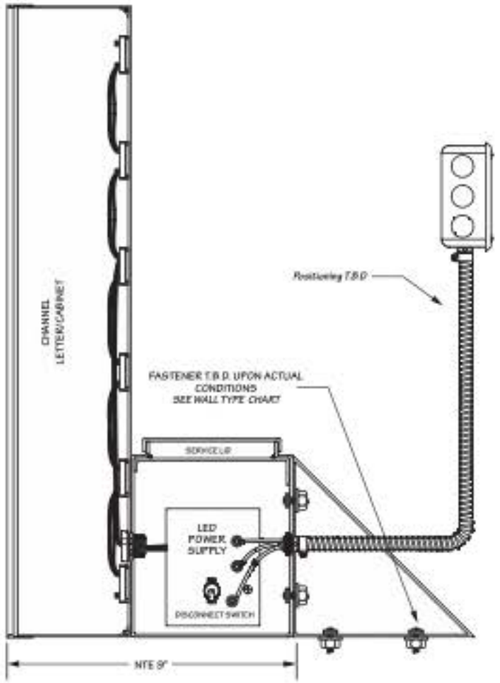





3 REVERSE CHANNEL LETTERS-DETAILS

SCALE: 1/2"=1'

Quantity: 1

C




HALO-LIT REVERSE CHANNEL LETTERS	
FACE MATERIAL:	ALUMINUM
RETURN COLOR:	BLACK
TRIMCAP COLOR:	N/A
ILLUMINATION:	HALO ILLUM.
MOUNTING:	STUD MOUNTED
DEPTH:	5"


31.27 SqFt






SIDEELEVATION

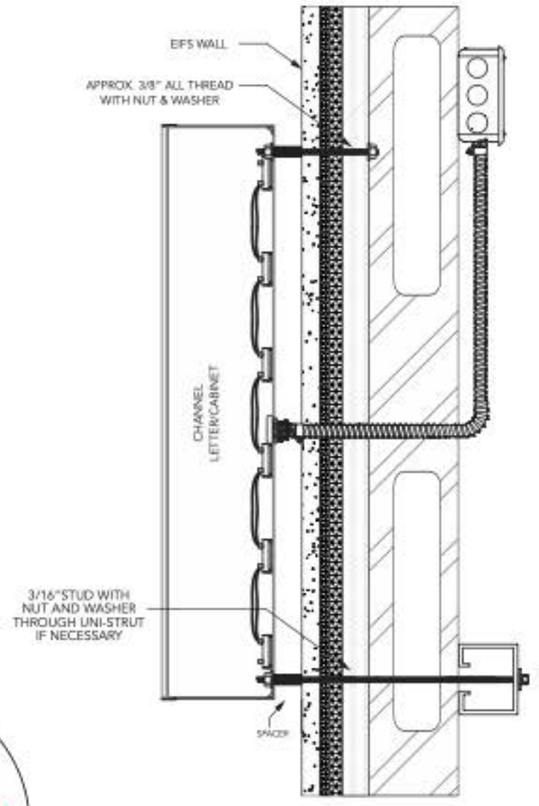

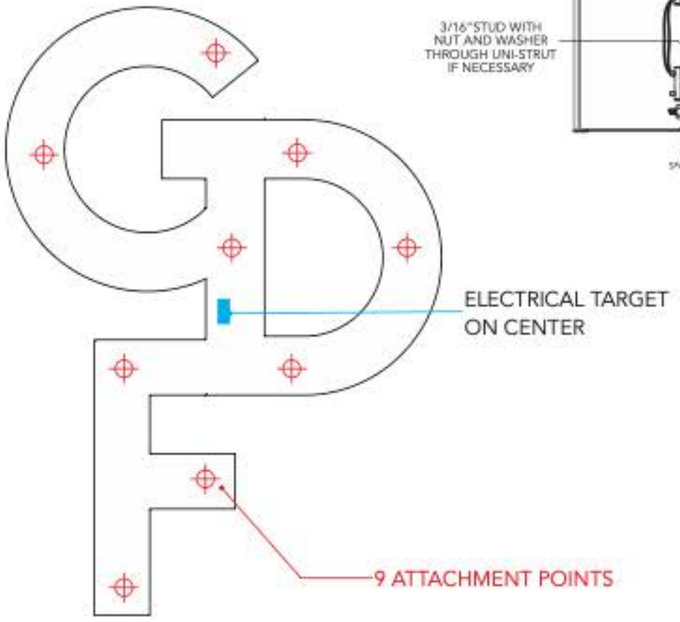

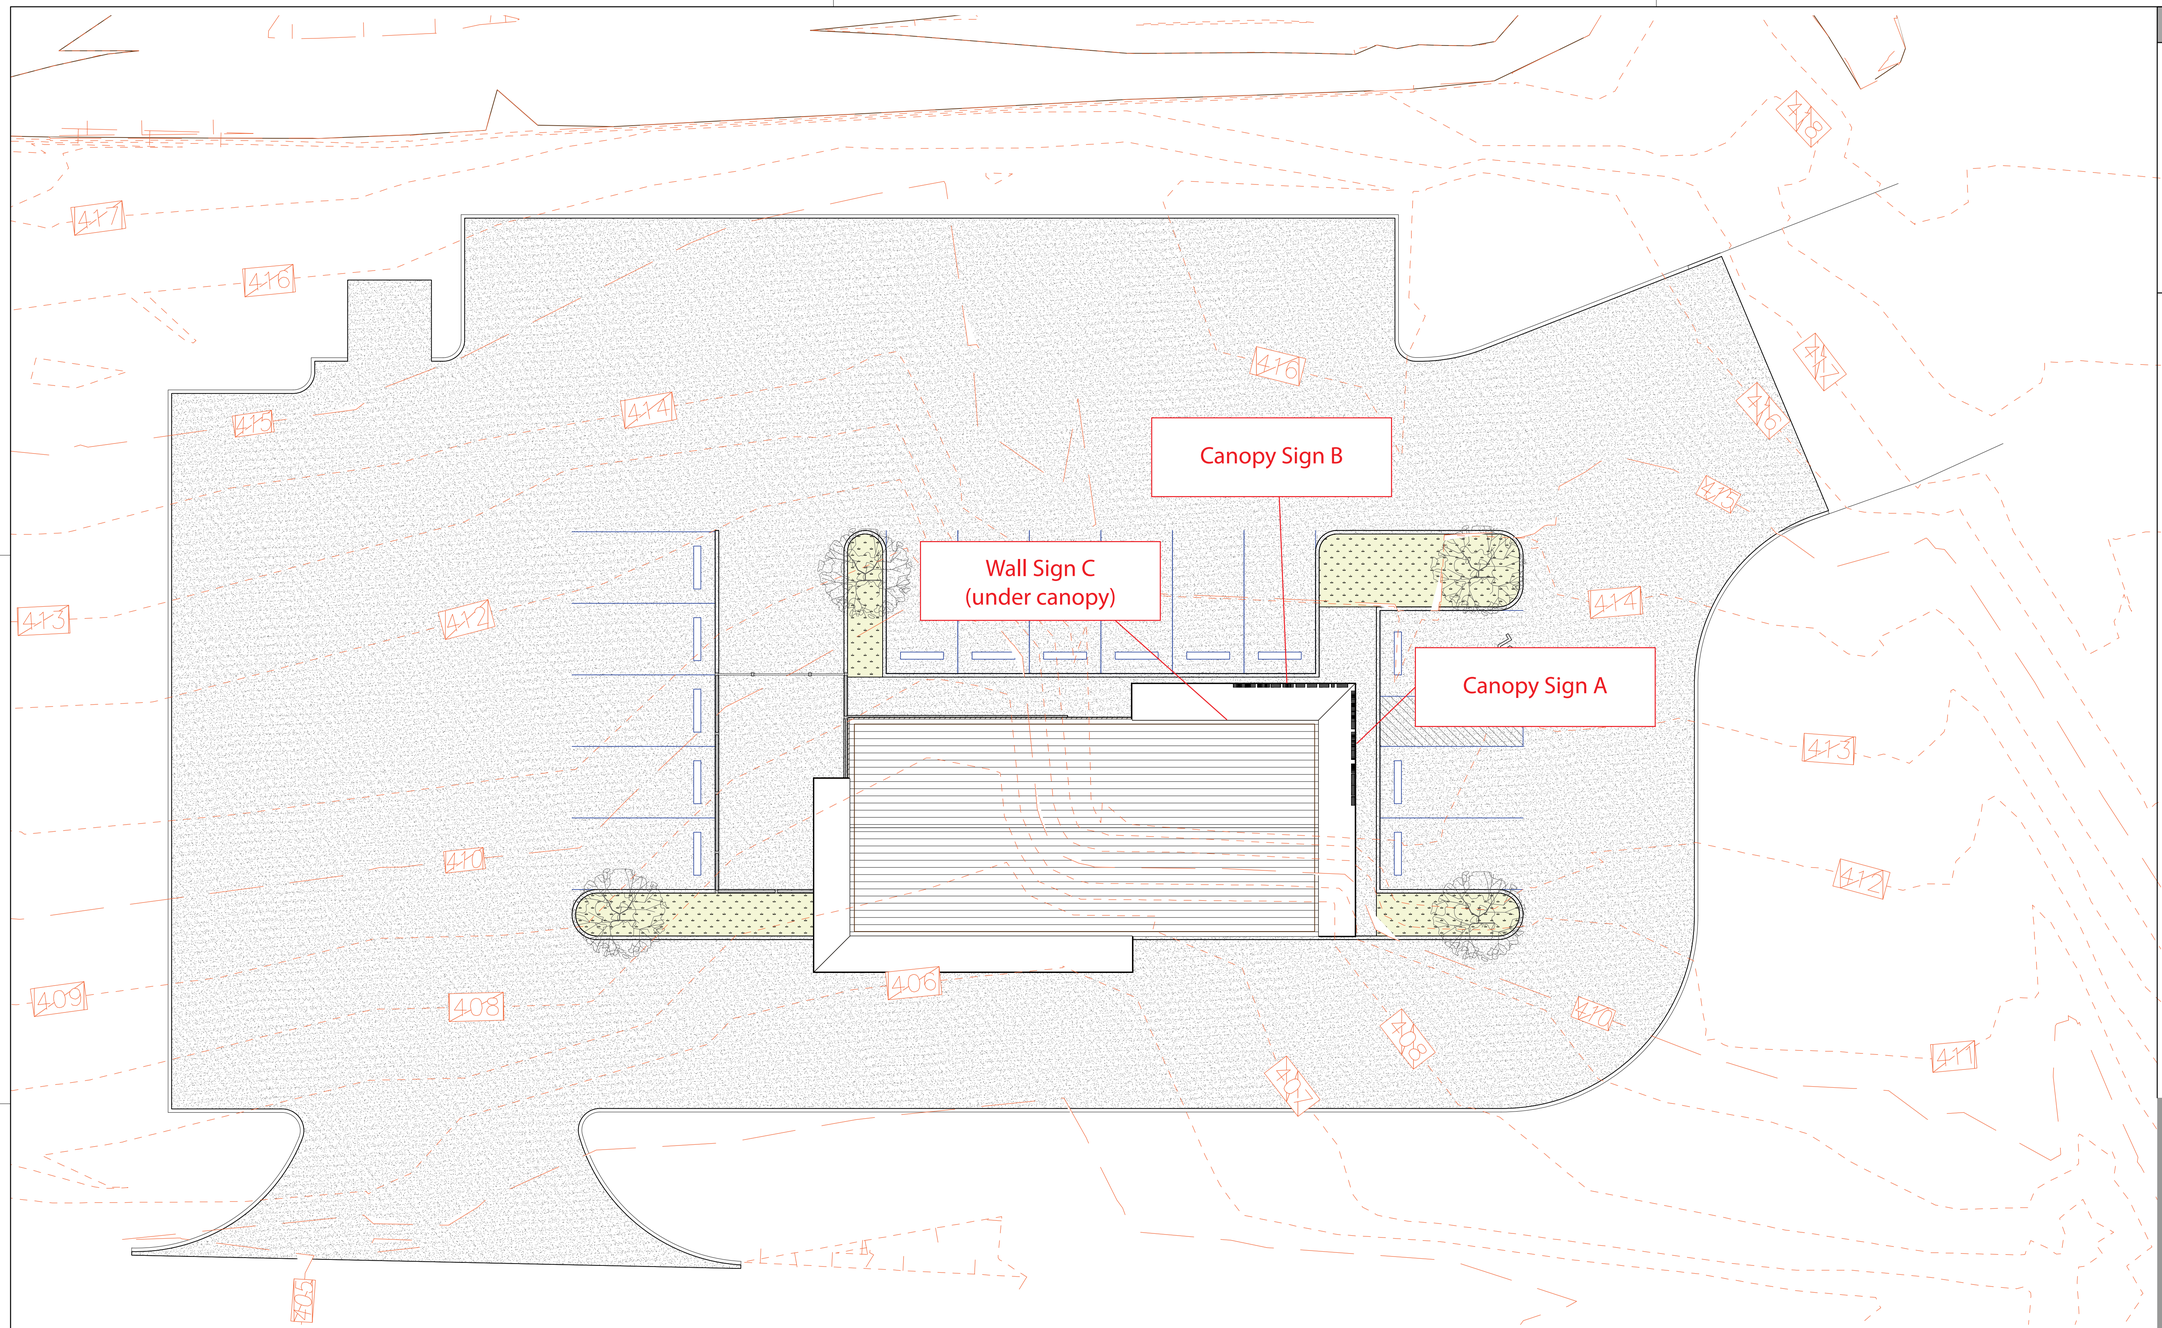

1 FLOOR PLAN
Scale: 1" = 10'-0"

CERTIFICATION:

A1.2

ROGUE Architecture PLLC
300 S Spring Street
Suite 720
Little Rock, Arkansas 72201
[p] 501.365.1576
[w] www.roguearch.com

ROGUE architecture

GOOD DAY FARM
DISPENSARY
3205 HIGHWAY 5 N
Bryant, Arkansas 72019

ARCHITECTURAL SITE PLAN

Issue Date: 2025.10.14

Revisions

CERTIFICATE OF AUTHORIZATION
ROGUE ARCHITECTURE PLLC
COA-01162
ARKANSAS

SIGN A ELEVATION



1 SOUTH ELEVATION
Scale: 1/4" = 1'-0"



2 WEST ELEVATION
Scale: 1/4" = 1'-0"

CERTIFICATION:

A4.3

ROGUE Architecture PLLC
300 S Spring Street
Suite 720
Little Rock, Arkansas 72201
[p] 501.365.1576
[w] www.roguearch.com

EXTERIOR ELEVATIONS


Issue Date: 2025.10.14


Revisions

GOOD DAY FARM DISPENSARY

3205 HIGHWAY 5 N
Bryant, Arkansas 72019

ROGUE architecture

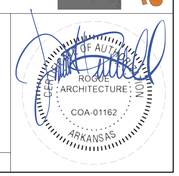

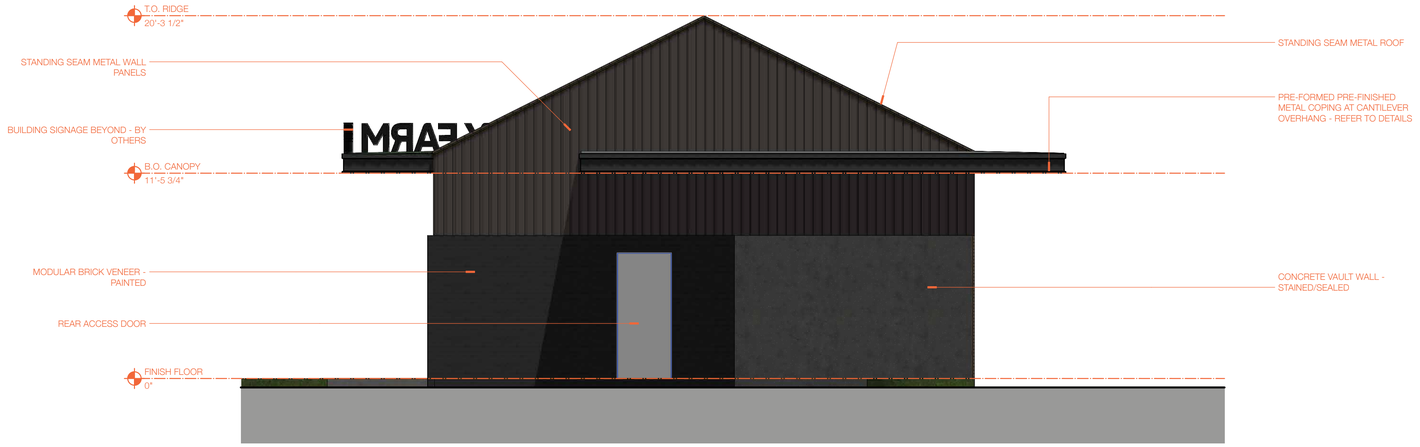

1 NORTH ELEVATION
Scale: 1/4" = 1'-0"

SIGN B & C ELEVATION



2 EAST ELEVATION
Scale: 1/4" = 1'-0"

CERTIFICATION:

A4.4

ROGUE Architecture PLLC
300 S Spring Street
Suite 720
Little Rock, Arkansas 72201
[p] 501.365.1576
[w] www.roguearch.com

EXTERIOR ELEVATIONS

Issue Date: 2025.10.14

Revisions

GOOD DAY FARM
DISPENSARY
3205 HIGHWAY 5 N
Bryant, Arkansas 72019

ROGUE architecture

STATE OF ARKANSAS
ROGUE ARCHITECTURE
COA-01162
REGISTERED
ARKANSAS