APPROVED 1 Sign,
All Others are Existing Cabinet Face Changes. CL 2/10/2022

City of Bryant, Arkansas
Community Development
210 SW 3rd Street Bryant, AR 72022
501-943-0943

SIGN PERMIT APPLICATION

Applicants are advised to read the Sign Ordinance prior to completing and signing this form. The Sign Ordinance is available at www.cityofbryant.com under the Planning and Community Development tab.

Note: Electrical Permits may be Required, Please contact the Community Development Office for more information.

Date: 01/28/2022

Sign Co. or Sign Owner

Name Condray Signs
Address 1107 E. Harding
City, State, Zip Pine Bluff AR 71601
Phone 870-534-5210
Email Address emma@condraysigns.com

Property Owner

Name Casey's Marketing Co
Address 1 SE Convenience Blvd
City, State, Zip Ankeny, IA 50021
Phone 515-965-6100
Email Address jacob.clark@casey's.com

GENERAL INFORMATION

Name of Business Casey's
Address/Location of sign 2301 N. Reynolds Rd
Zoning Classification C2

Please use following page to provide details on the signs requesting approval. Along with information provided on this application, **a Site Plan showing placement of sign(s) and any existing sign(s) on the property is required** to be submitted. **Renderings of the sign(s) showing the correct dimensions is also required** to be submitted with the application. A thirty-five dollar ($35) per sign payment will be collected at the time of permit issuance. According to the Sign Ordinance a fee for and sign variance or special sign permit request shall be one hundred dollars ($100). Additional documentation may be required by Sign Administrator.

READ CAREFULLY BEFORE SIGNING

I Keri Stewart, do hereby certify that all information contained within this application is true and correct. I fully understand that the terms of the Sign Ordinance supersede the Sign Administrator's approval and that all signs must fully comply with all terms of the Sign Ordinance regardless of approval. I further certify that the proposed sign is authorized by the owner of the property and that I am authorized by the property owner to make this application. I understand

that no sign may be placed in public right of way. I understand that I must comply with all Building and Electrical Codes and that it is my responsibility to obtain all necessary permits.

Use table below to enter information regarding each sign for approval. Please use each letter to reference each sign rendering.

SIGN	**Type** (Façade, Pole, Monument, other)	**Dimensions** (Height, Length, Width)	**Sqft** (Measured in whole as rectangle)	**Height of Sign** (Measured from lot surface)		Column for Admin Certifying Approval
				Top of Sign	Bottom of Sign	
A	wall	4'-10"x12'	58	208"	145"	CL 2/10/22
B	road	5'-10"x8'-1"	47			Face Change
C	road	3'-10"x8-1"	31			Face Change
E	road	5'-10"x8-1"	47			Face Change
F	road	3'-10"x8-1"	31			Face Change
G	pole	3'-1"x16'-1"	18.7			Face Change

face A

face B

face A

face B

(B-F) Road Signs = face replacements

(G) Truck entrance = face replacements

(H) Auto Exit = face replacements

(I) High rise face replacements

(J) face replacements

(K) face replacements

that no sign may be placed in public right of way. I understand that I must comply with all Building and Electrical Codes and that it is my responsibility to obtain all necessary permits.

Use table below to enter information regarding each sign for approval. Please use each letter to reference each sign rendering.

	SIGN	**Type** (Façade, Pole, Monument, other)	**Dimensions** (Height, Length, Width)	**Sqft** (Measured in whole as rectangle)	**Height of Sign** (Measured from lot surface)		Column for Admin Certifying Approval
					Top of Sign	Bottom of Sign	
H		pole	1'-10"x2'-10"	5			Face Change
I		high rise	8-3"x 27'	223	71'	63'	Face Change
J		high rise	6'x6"	36	60	54	Face Change
K		high rise	6'x6'	36	60	54	Face Change
L		canopy	24"x6'2"	12	23'	19'	Face Change
M		canopy	24"x74"	12	23'	19'	Face Change
N		canopy	24"x74"	12	23'	19'	Face Change




EXISTING
4'-0" x 13'-0 1/2" BACKER PANEL SIZE



BUILDING TRIM PAINTED CASEY'S RED
BUILDING AWNINGS REMOVED

PROPOSED

"A"

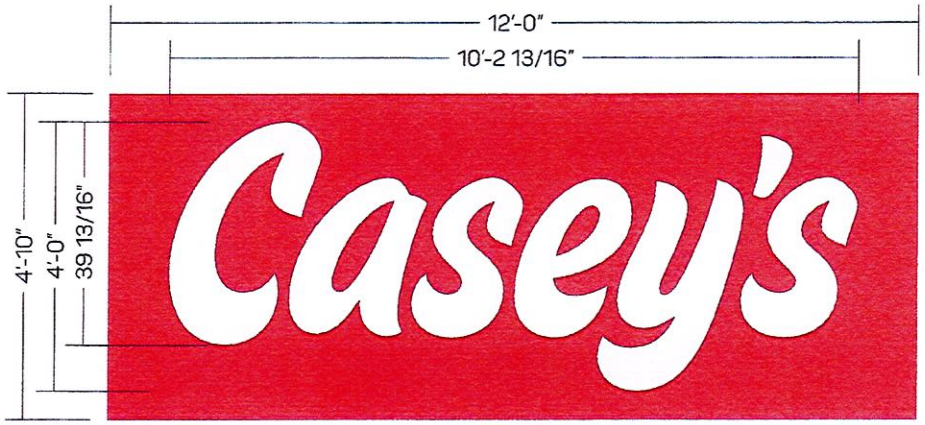

SIGN 1 CHANNEL LETTER ON BACKER DETAIL
SCALE: 3/8" = 1'-0"


SIGN 2
'DELI' WALL SIGN REMOVED
NOT REPLACED

APPROVAL BOX - PLEASE INITIAL		
CUSTOMER APPROVAL		Date

Customer: CASEY'S	Date: 14JAN22	Prepared By: SC	Note: Color output may not be exact when viewing or printing this drawing. All colors used are PMS or the closest CMYK equivalent. If these colors are incorrect, please provide the correct PMS match and a revision to this drawing will be made.	persona SIGNS | LIGHTING | IMAGE
Location: BRYANT, AR	File Name: 318683 - R5 - SITE 4246 - BRYANT, AR		Eng: –	

DISTRIBUTED BY SIGN UP COMPANY
700 21st Street Southwest
PO Box 210
Watertown, SD 57201-0210
1.800.843.9888 - www.personasigns.com



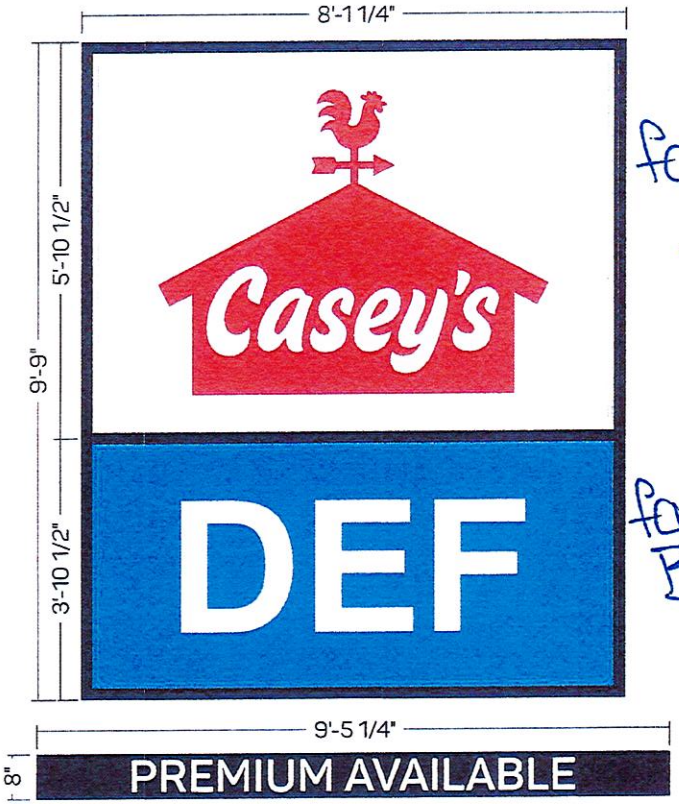




*NOTE VERTICAL DIVIDER BAR REMOVED FROM BOTTOM OF ID FRAME

EXISTING
9'-9" X 8'-1 1/4" PYLON SIGN

Move down so there is 9" between pricer and Premium Avalible sign.

PROPOSED

Road sign "B"

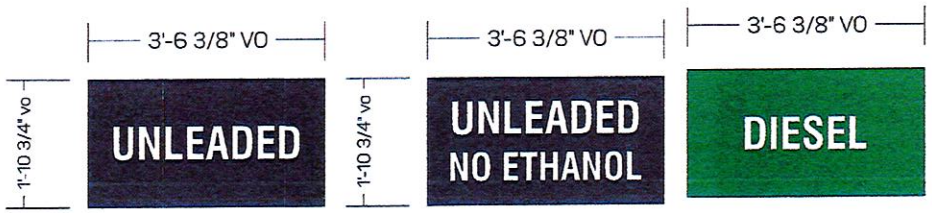


PYLON DETAIL
SCALE: 3/8" = 1'-0"
SIGN 6


APPROVAL BOX - PLEASE INITIAL		
CUSTOMER APPROVAL		Date

Customer: CASEY'S	Date: 01/25/22	Prepared By: SC/CM	Note: Color output may not be exact when viewing or printing this drawing. All colors used are PMS or the closest CMYK equivalent. If these colors are incorrect, please provide the correct PMS match and a revision to this drawing will be made.	persona SIGNS | LIGHTING | IMAGE
Location: BRYANT, AR	File Name: 318683 - R5 - SITE 4246 - BRYANT, AR		Eng: -	DISTRIBUTED BY SIGN UP COMPANY 700 21st Street Southwest PO Box 210 Watertown, SD 57201-0210 1.800.843.9888 · www.personasigns.com



EXISTING
9'-9" X 8'-1 1/4" PYLON SIGN

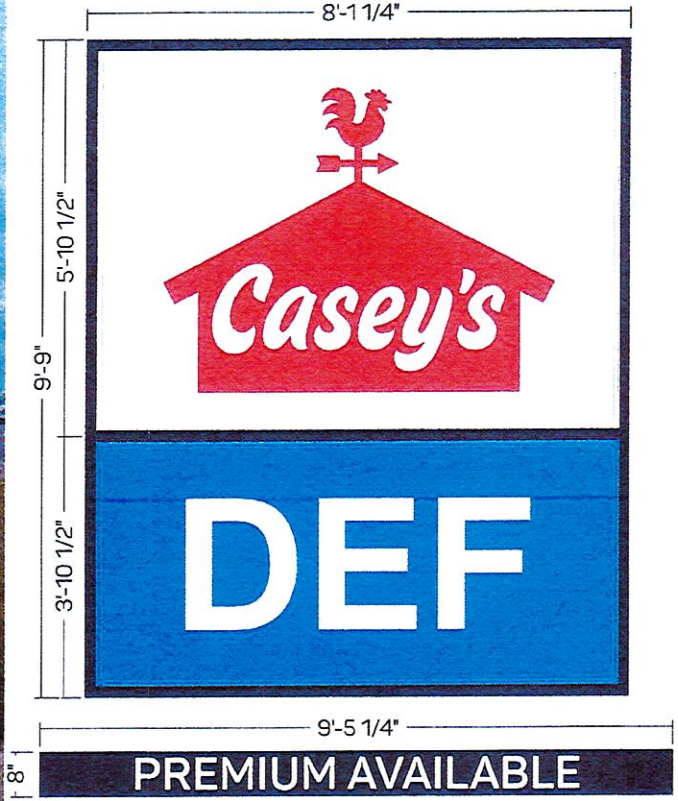


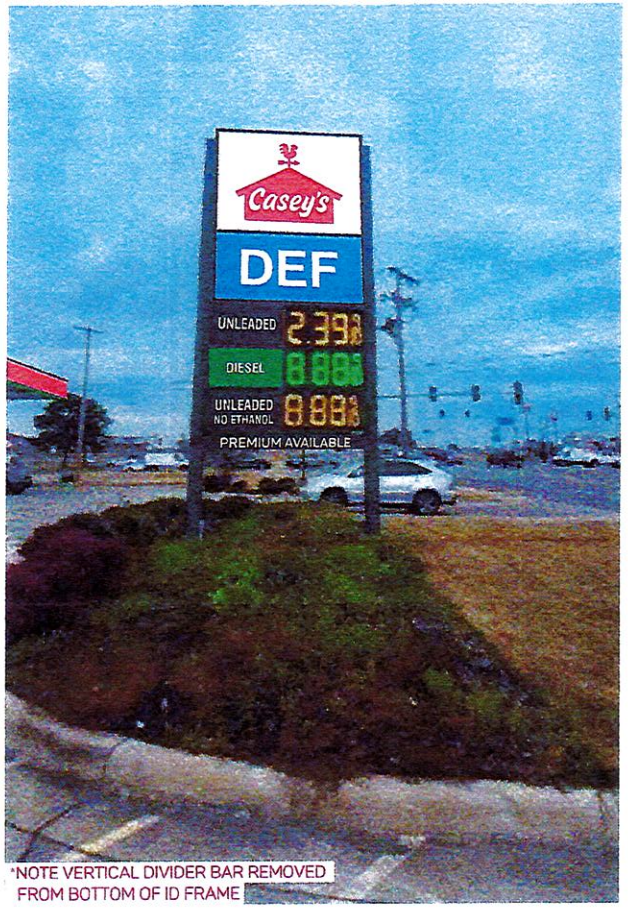

*NOTE VERTICAL DIVIDER BAR REMOVED FROM BOTTOM OF ID FRAME

PROPOSED

Move down so there is 9" between pricer and Premium Avalible sign.

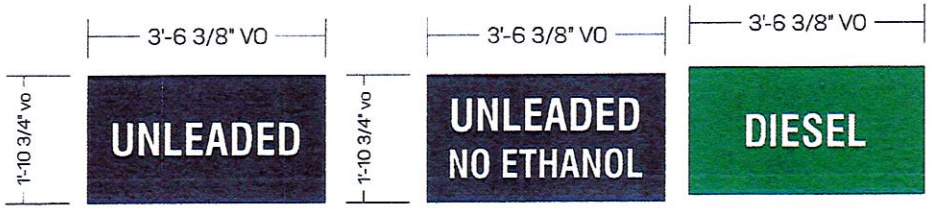

Road sign "E"

PYLON DETAIL
SCALE: 3/8" = 1'-0"
SIGN 7

APPROVAL BOX - PLEASE INITIAL		
CUSTOMER APPROVAL		Date

Customer:	Date:	Prepared By:	Note: Color output may not be exact when viewing or printing this drawing. All colors used are PMS or the closest CMYK equivalent. If these colors are incorrect, please provide the correct PMS match and a revision to this drawing will be made.	
CASEY'S	01/25/22	SC/CM		
Location:	File Name:			Eng:
BRYANT, AR	318683 - R5 - SITE 4246 - BRYANT, AR			–


persōna
SIGNS | LIGHTING | IMAGE
DISTRIBUTED BY SIGN UP COMPANY
700 21st Street Southwest
PO Box 210
Watertown, SD 57201-0210
1.800.843.9888 · www.personasigns.com



EXISTING
37 1/4" X 73 1/2"



PROPOSED

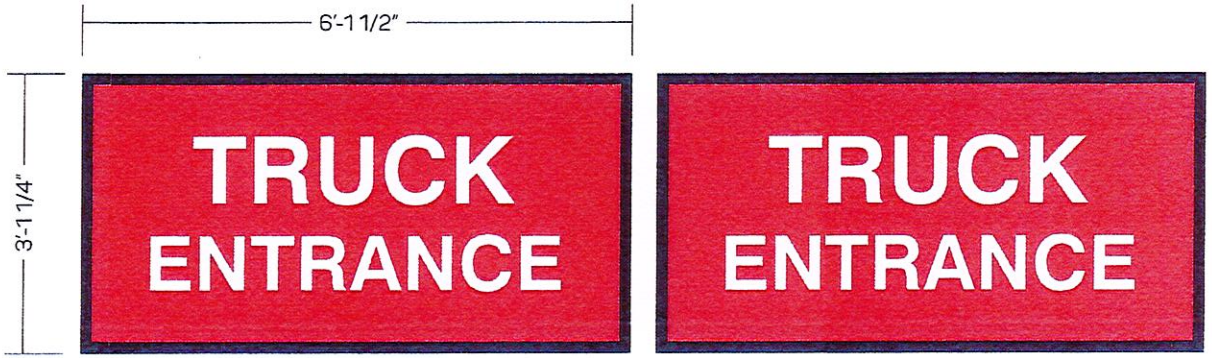

FACE REPLACEMENT DETAIL
SCALE: 1/2" = 1'-0"

SIGN 8

APPROVAL BOX - PLEASE INITIAL		
CUSTOMER APPROVAL		Date

Customer: **CASEY'S**	Date: **14JAN22**	Prepared By: **SC**	Note: Color output may not be exact when viewing or printing this drawing. All colors used are PMS or the closest CMYK equivalent. If these colors are incorrect, please provide the correct PMS match and a revision to this drawing will be made.	persona SIGNS | LIGHTING | IMAGE
Location: **BRYANT, AR**	File Name: **318683 - R5 - SITE 4246 - BRYANT, AR**		Eng: –	


DISTRIBUTED BY SIGN UP COMPANY
700 21st Street Southwest
PO Box 210
Watertown, SD 57201-0210
1.800.843.9888 • www.personasigns.com



EXISTING
22 1/4" X 34 1/2"



PROPOSED

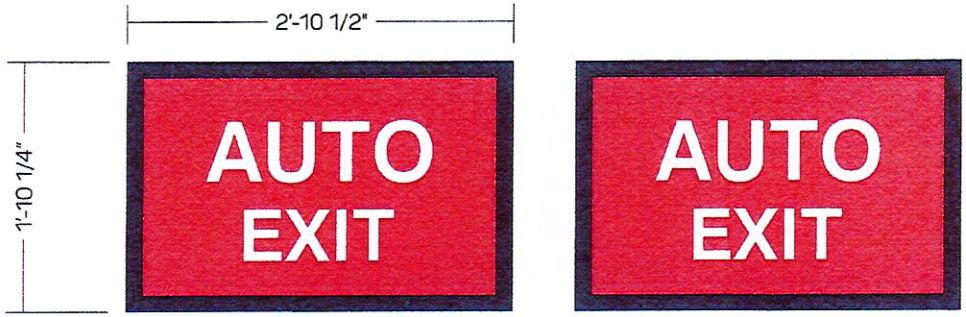

"H"

FACE REPLACEMENT DETAIL
SCALE: 3/4" = 1'-0"

SIGN 9

APPROVAL BOX - PLEASE INITIAL		
CUSTOMER APPROVAL		Date:

Customer: CASEY'S	Date: 14JAN22	Prepared By: SC	Note: Color output may not be exact when viewing or printing this drawing. All colors used are PMS or the closest CMYK equivalent. If these colors are incorrect, please provide the correct PMS match and a revision to this drawing will be made.	persona SIGNS | LIGHTING | IMAGE
Location: BRYANT, AR	File Name: 318683 - R5 - SITE 4246 - BRYANT, AR		Eng: -	

DISTRIBUTED BY SIGN UP COMPANY
700 21st Street Southwest
PO Box 210
Watertown, SD 57201-0210
1.800.843.9888 • www.personasigns.com



EXISTING
99 1/2" X 324" ID CABINET
W/ 4" RETAINER
72" X 72" 'OPEN' AND 'KRISP. KRUNCHY ' CABINETS
W/ 2" RETAINER



PROPOSED




FACE REPLACEMENT DETAIL
SCALE: 3/16" = 1'-0"

SIGN 10


APPROVAL BOX - PLEASE INITIAL		
CUSTOMER APPROVAL		Date

Customer:	Date:	Prepared By:	Note: Color output may not be exact when viewing or printing this drawing. All colors used are PMS or the closest CMYK equivalent. If these colors are incorrect, please provide the correct PMS match and a revision to this drawing will be made.	
CASEY'S	01/25/22	MW/CM		
Location:	File Name:			Eng:
BRYANT, AR	318683 - R5 - SITE 4246 - BRYANT, AR			–

persōna
SIGNS | LIGHTING | IMAGE
DISTRIBUTED BY SIGN UP COMPANY
700 21st Street Southwest
PO Box 210
Watertown, SD 57201-0210
1.800.843.9888 • www.personasigns.com

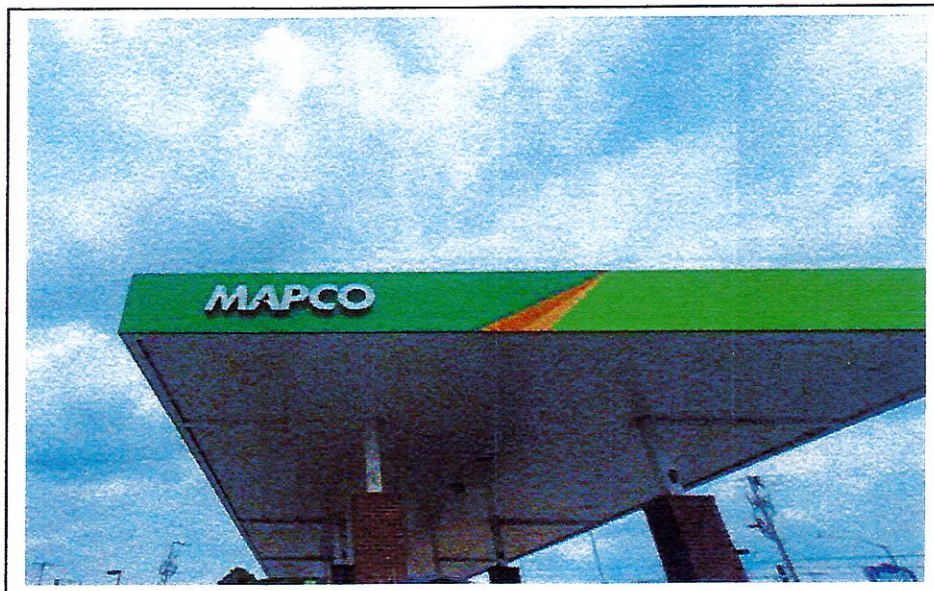


EXISTING
4'-0" x 46'-0"

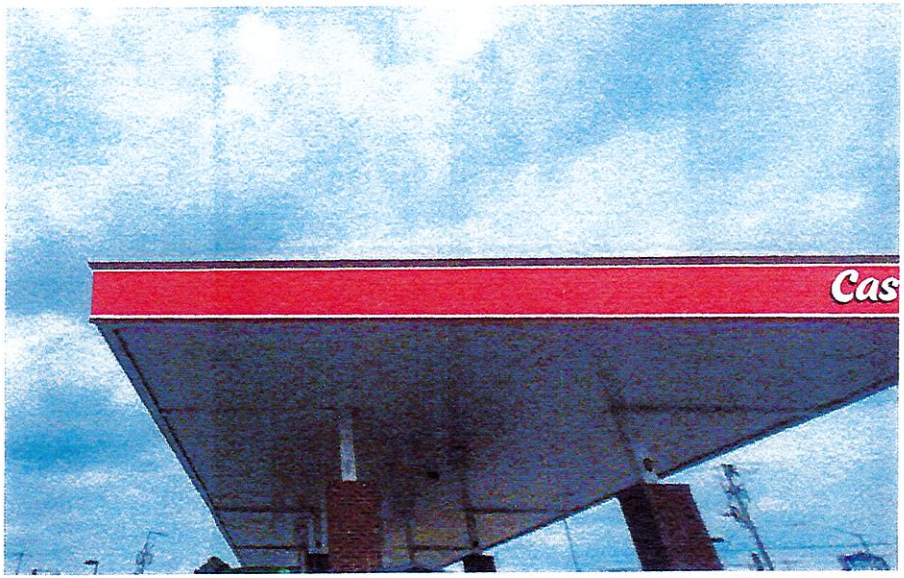


PROPOSED

NOTE: GAS CANOPIES BY OTHERS

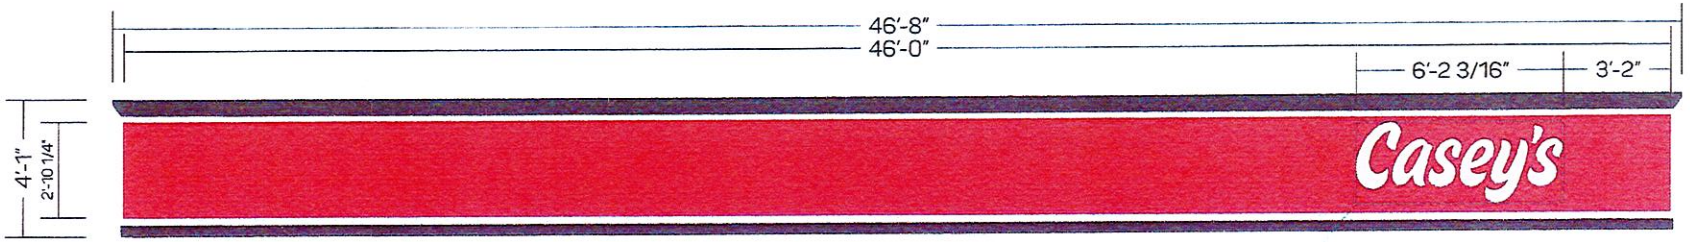

CANOPY DETAIL
SCALE: 3/16" = 1'-0"

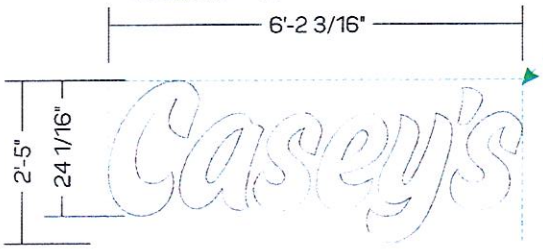

canopy

SIGN 4

CHANNEL LETTER DETAIL
SCALE: 3/8" = 1'-0"

APPROVAL BOX - PLEASE INITIAL		
CUSTOMER APPROVAL		Date

Customer: CASEY'S	Date: 14JAN22	Prepared By: SC	Note: Color output may not be exact when viewing or printing this drawing. All colors used are PMS or the closest CMYK equivalent. If these colors are incorrect, please provide the correct PMS match and a revision to this drawing will be made.	persona SIGNS | LIGHTING | IMAGE
Location: BRYANT, AR	File Name: 318683 - R5 - SITE 4246 - BRYANT, AR		Eng: –	

DISTRIBUTED BY SIGN UP COMPANY
700 21st Street Southwest
PO Box 210
Watertown, SD 57201-0210
1.800.843.9888 • www.personasigns.com




EXISTING
4'-0" X 120'-0"




NOTE: CANOPY BY OTHERS
NOTE: PUMPS UPDATED BY OTHERS

PROPOSED

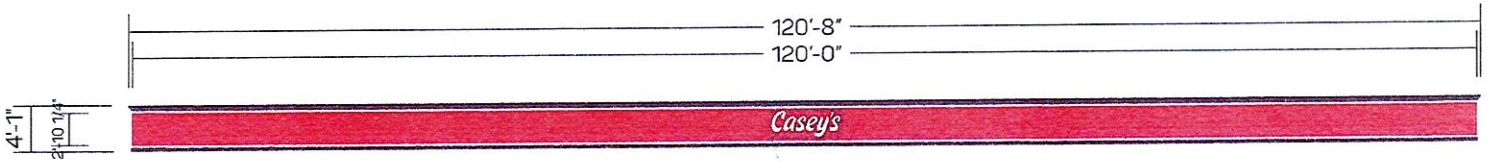

CANOPY DETAIL
SCALE: 1/16" = 1'-0"

m
canopy

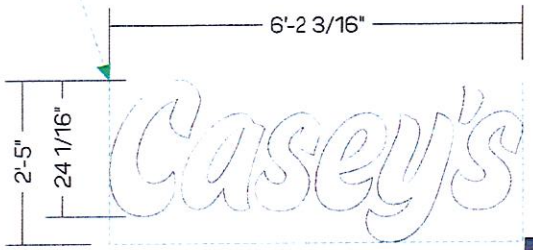


SIGN 3 CHANNEL LETTER DETAIL
SCALE: 3/8" = 1'-0"

APPROVAL BOX - PLEASE INITIAL		
CUSTOMER APPROVAL		Date

Customer: **CASEY'S**	Date: **01/25/22**	Prepared By: **SC/CM**	Note: Color output may not be exact when viewing or printing this drawing. All colors used are PMS or the closest CMYK equivalent. If these colors are incorrect, please provide the correct PMS match and a revision to this drawing will be made.	
Location: **BRYANT, AR**	File Name: **318683 - R5 - SITE 4246 - BRYANT, AR**			Eng: –


persona
SIGNS | LIGHTING | IMAGE
DISTRIBUTED BY SIGN UP COMPANY
700 21st Street Southwest
PO Box 210
Watertown, SD 57201-0210
1.800.843.9888 • www.personasigns.com

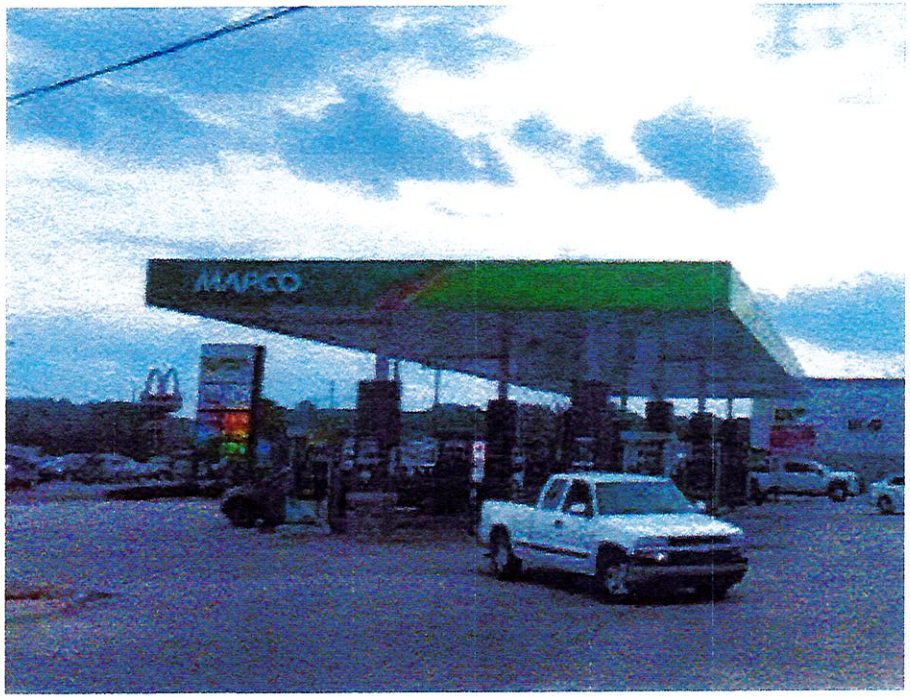



NOTE: GAS CANOPIES BY OTHERS


EXISTING
4'-0" X 46'-0"

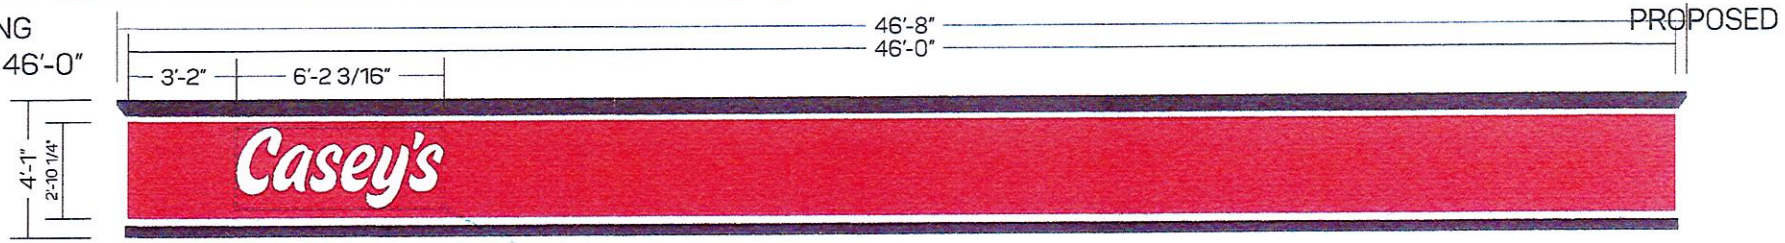

N

canopy

CANOPY DETAIL
SCALE: 3/16" = 1'-0"

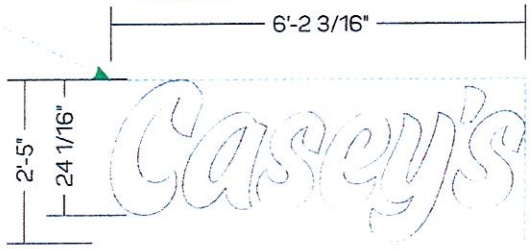

SIGN 5

CHANNEL LETTER DETAIL
SCALE: 3/8" = 1'-0"

APPROVAL BOX - PLEASE INITIAL		
CUSTOMER APPROVAL		Date

Customer: CASEY'S	Date: 01/25/22	Prepared By: SC/CM	Note: Color output may not be exact when viewing or printing this drawing. All colors used are PMS or the closest CMYK equivalent. If these colors are incorrect, please provide the correct PMS match and a revision to this drawing will be made.	
Location: BRYANT, AR	File Name: 318683 - R5 - SITE 4246 - BRYANT, AR			Eng: -

persona
SIGNS | LIGHTING | IMAGE
DISTRIBUTED BY SIGN UP COMPANY
700 21st Street Southwest
PO Box 210
Watertown, SD 57201-0210
1.800.843.9888 · www.personasigns.com