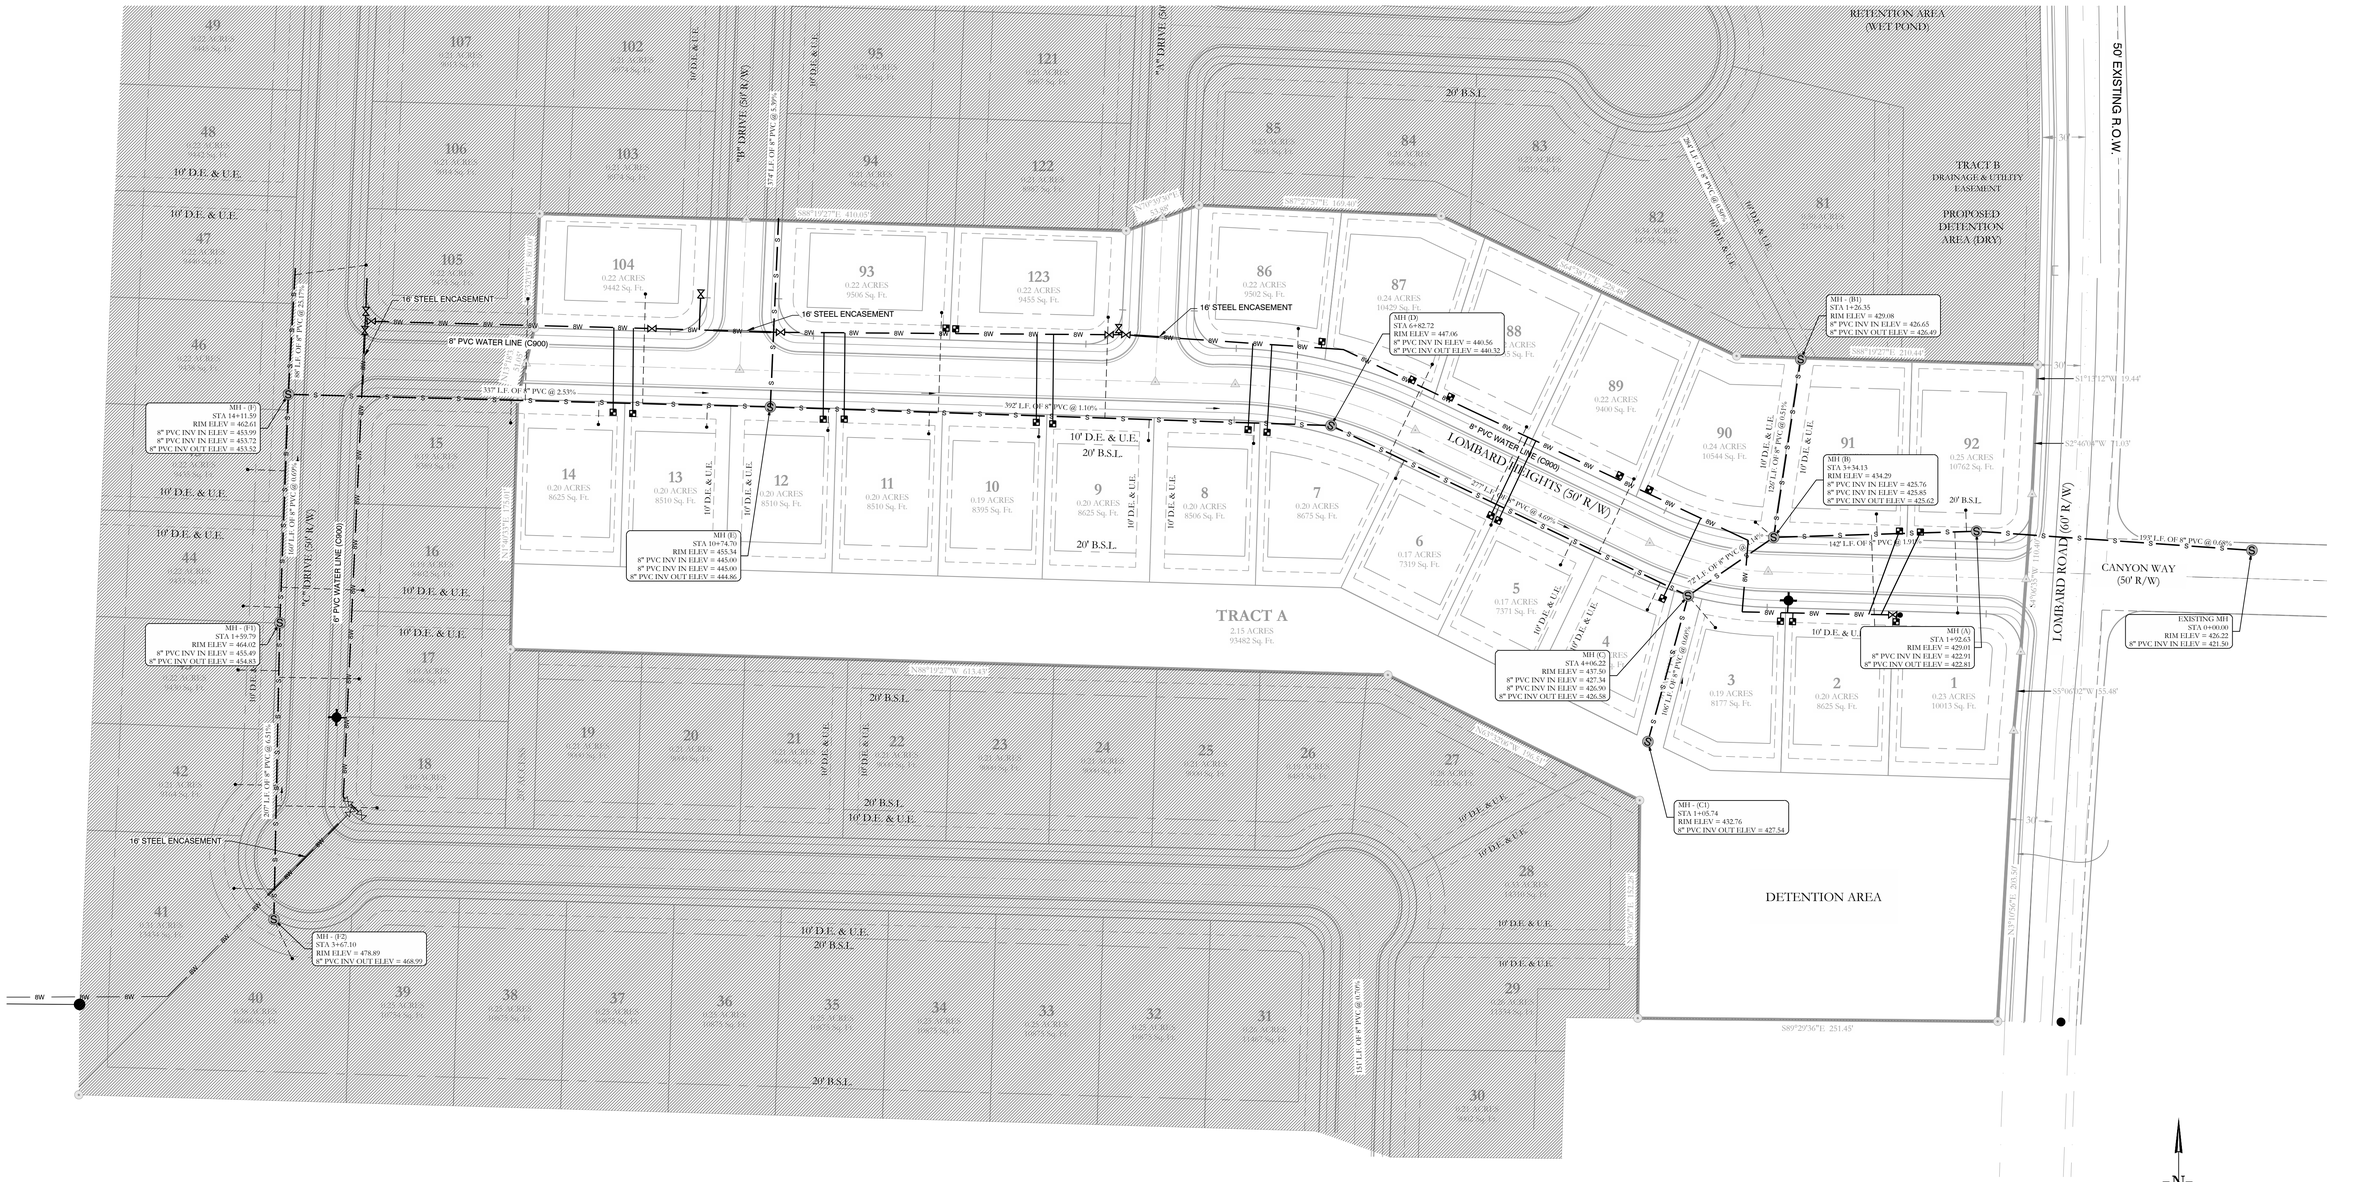



BRYANT WATER & WASTE WATER SEWER NOTES:

1. ALL PVC PIPE SHALL BE SDR-26 PIPE. SDR-35 SHALL NOT BE ALLOWED.

2. ALL MANHOLES INTERIORS SHALL BE COATED WITH A CORROSION-RESISTANT EPOXY LINER.

**WATER LEGEND:**

- 2" BLOW OFF
- GATE VALVE
- REDUCER
- FIRE HYDRANT
- DOUBLE WATER SERVICE
- SINGLE WATER SERVICE

NOTE:
ALL FIRE HYDRANT LEADERS HAVE A GATE VALVE BETWEEN MAIN AND FIRE HYDRANT.

**TYPICAL FIRE HYDRANT:**

2" BLOW OFF
REDUCER
6"
6"
GATE VALVE
FIRE HYDRANT
(2 TO 6 FEET FROM EDGE OF PAVEMENT)

**SEWER LEGEND:**

SEWER SERVICE
SEWER MAIN
SEWER MANHOLE

NOTE:
USE SDR-26 PVC SEWER PIPE EXCEPT WHERE DUCTILE IRON PIPE REQUIRED FOR COVER. USE DUCTILE IRON PIPE WHERE 3' MINIMUM COVE CANNOT BE MAINTAINED.

CONTRACTOR IS RESPONSIBLE FOR LOCATING ALL BURIED UTILITIES PRIOR TO CONSTRUCTION.


HOPE CONSULTING
ENGINEERS - SURVEYORS
117 S. Market Street,
Benton, Arkansas 72015
PH. (501)315-2626
FAX (501) 315-0024
www.hopeconsulting.com


FOR USE AND BENEFIT OF:
LOMBARD HEIGHTS

# WATER & SEWER ASBUILTS
## LOMBARD HEIGHTS, PHASE 1
A SUBDIVISION IN THE CITY OF BRYANT, SALINE COUNTY, ARKANSAS

| | | | |
|---|---|---|---|
| DATE: 07/13/2022 | C.A.D. BY: BJOHNSON | | DRAWING NUMBER: |
| REVISED: | CHECKED BY: = | | 20-1388 |
| SHEET: | SCALE: AS SHOWN | | |

| | | | | | | | |
|---|---|---|---|---|---|---|---|
| 500 | 01S | 14W | | 16 | 201 | 62 | 128 |

K:\Land Projects\2066 Subdivisions\2020\20-1388 Lombard Heights I\I-DGN\T-ASB PT.dwg