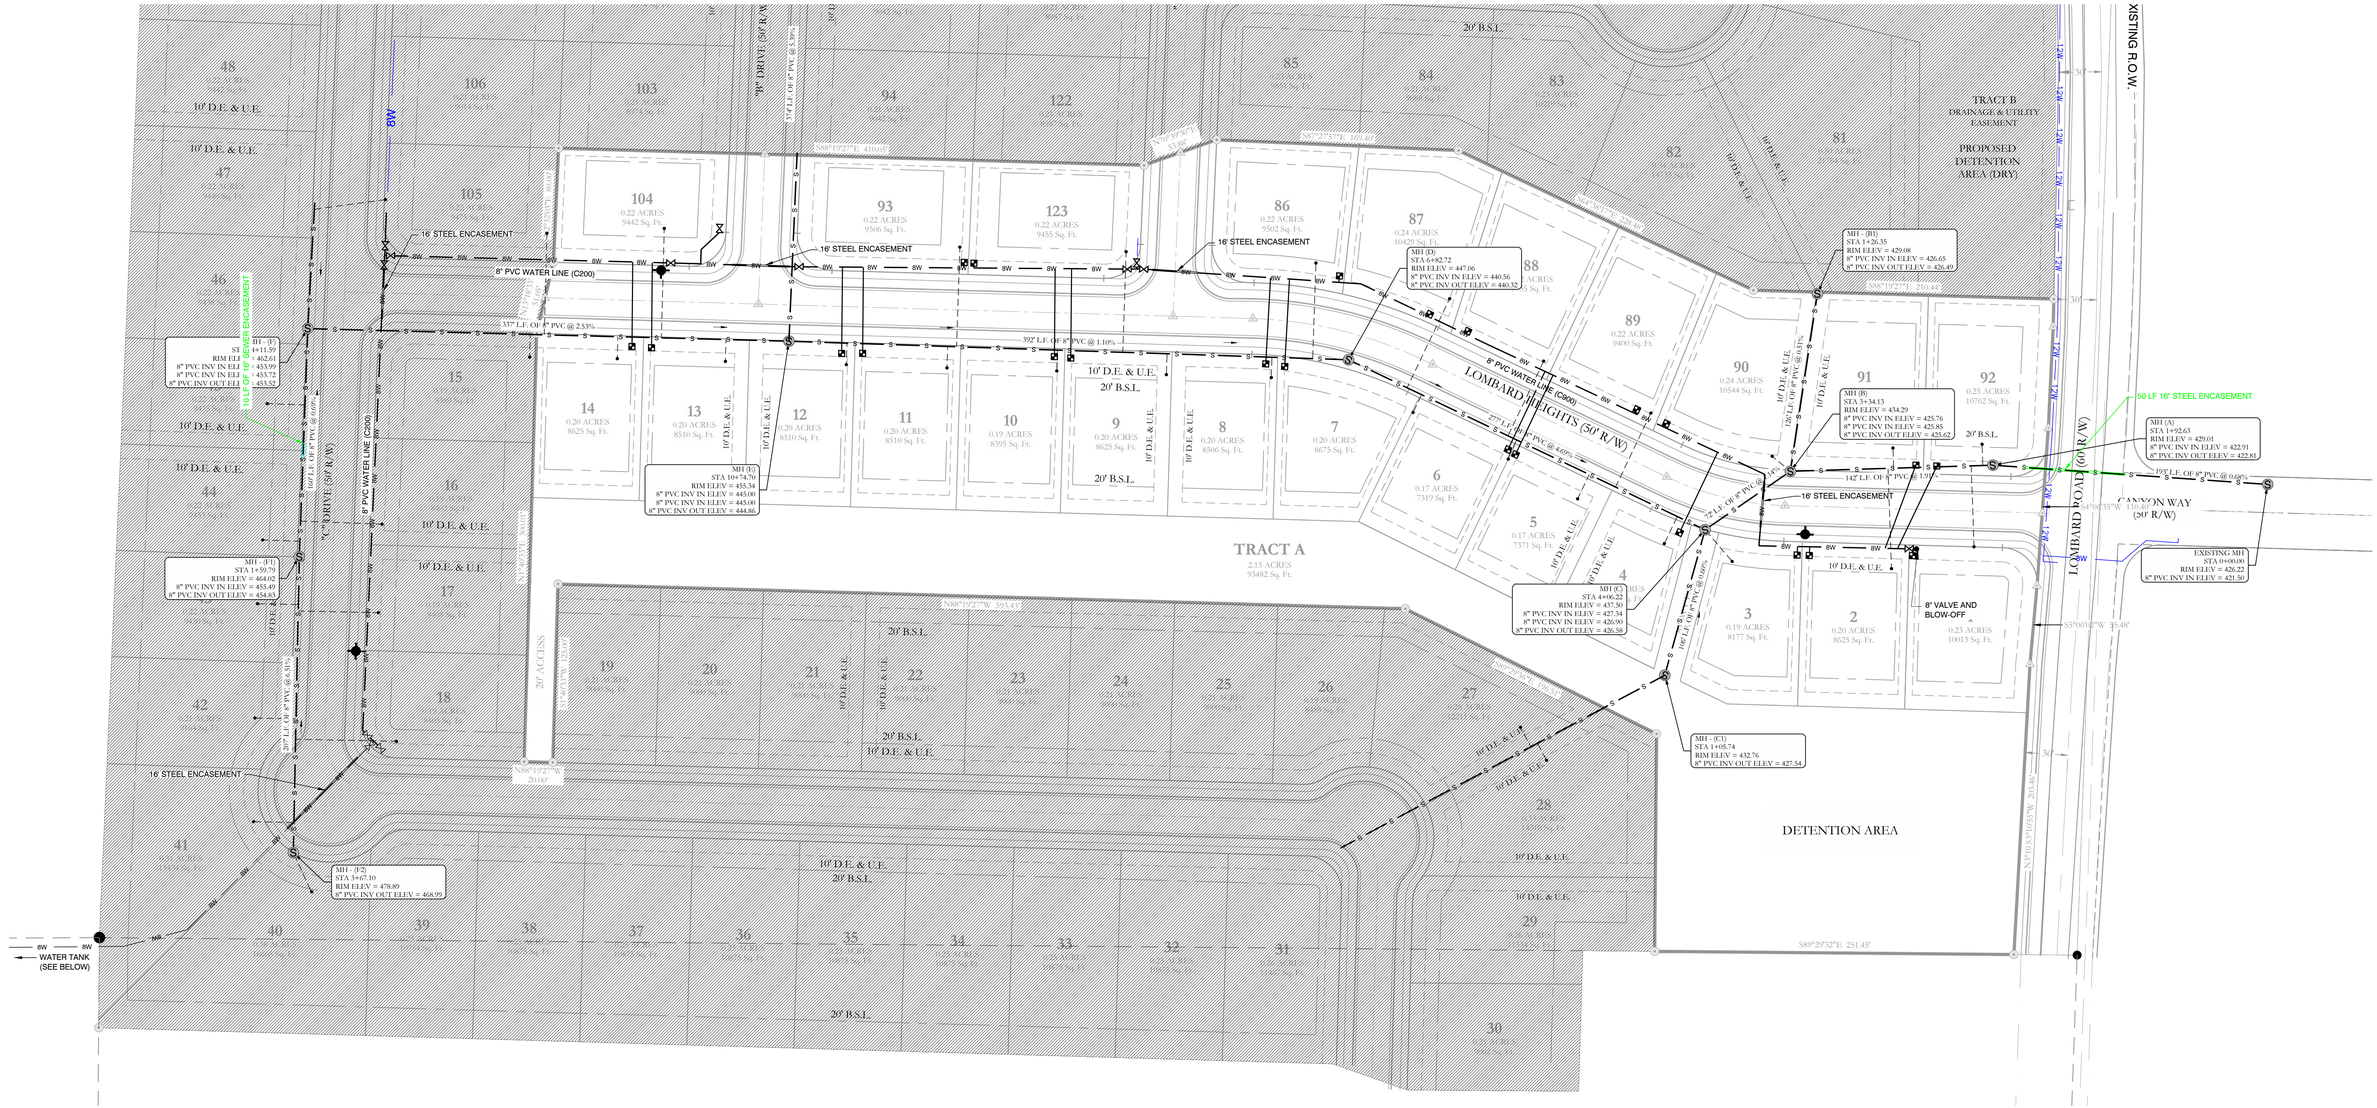


WATER LEGEND:	TYPICAL FIRE HYDRANT:	SEWER LEGEND:
2" BLOW OFF	2" BLOW OFF	SEWER SERVICE
WATER MAIN — GATE VALVE	REDUCER 6"	SEWER MAIN — S — S — SEWER MANHOLE
REDUCER	6"	
FIRE HYDRANT	GATE VALVE	
DOUBLE WATER SERVICE	FIRE HYDRANT (2 TO 6 FEET FROM EDGE OF PAVEMENT)	
SINGLE WATER SERVICE		

NOTE:
ALL FIRE HYDRANT LEADERS HAVE A GATE VALVE BETWEEN MAIN AND FIRE HYDRANT.

NOTE:
USE SDR-26 PVC SEWER PIPE EXCEPT WHERE DUCTILE IRON PIPE REQUIRED FOR COVER. USE DUCTILE IRON PIPE WHERE 3' MINIMUM COVE CANNOT BE MAINTAINED.

CONTRACTOR IS RESPONSIBLE FOR LOCATING ALL BURIED UTILITIES PRIOR TO CONSTRUCTION.

HOPE CONSULTING
ENGINEERS - SURVEYORS
117 S. Market Street,
Benton, Arkansas 72015
PH. (501)315-2626
FAX (501) 315-0024
www.hopeconsulting.com

FOR USE AND BENEFIT OF:
LOMBARD HEIGHTS

WATER & SEWER ASBUILTS
LOMBARD HEIGHTS, PHASE 1
A SUBDIVISION IN THE CITY OF BRYANT, SALINE COUNTY, ARKANSAS

DATE: 08/10/2022	C.A.D. BY: B.JOHNSON	DRAWING NUMBER:	
REVISED:	CHECKED BY:	20-1388	
SHEET:	SCALE: AS SHOWN		

500	01S	14W		16	201	62	128

© Land Projects 2020 Subdivisions/2020/20-1388 Lombard Heights/20-1388 FP.dwg



HOPE CONSULTING
ENGINEERS - SURVEYORS
117 S. Market Street,
Benton, Arkansas 72015
PH. (501)315-2626
FAX (501) 315-0024
www.hopeconsulting.com

FOR USE AND BENEFIT OF:

LOMBARD HEIGHTS

DRAINAGE ASBUILTS
LOMBARD HEIGHTS, PHASE 1

A SUBDIVISION IN THE CITY OF BRYANT, SALINE COUNTY, ARKANSAS

DATE: 08/10/2022	C.A.D. BY: B.JOHNSON	DRAWING NUMBER:	
REVISED:	CHECKED BY: =	20-1388	
SHEET:	SCALE: AS SHOWN		

500	01S	14W		16	201	62	128

Land Projects/2020/20-1388 Lombard Heights PH 1/20-1388 ASP.dwg