


VICINITY MAP:

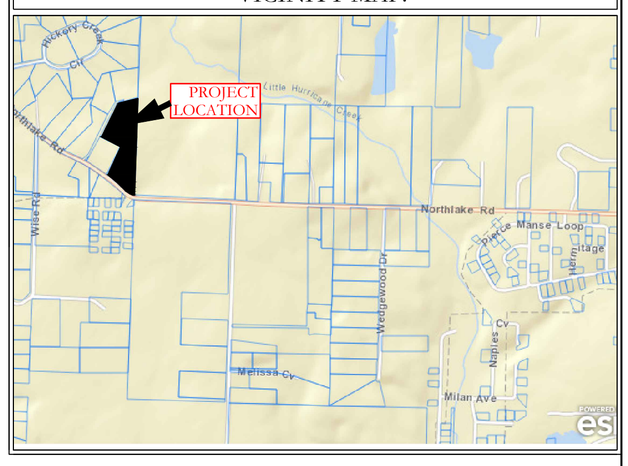

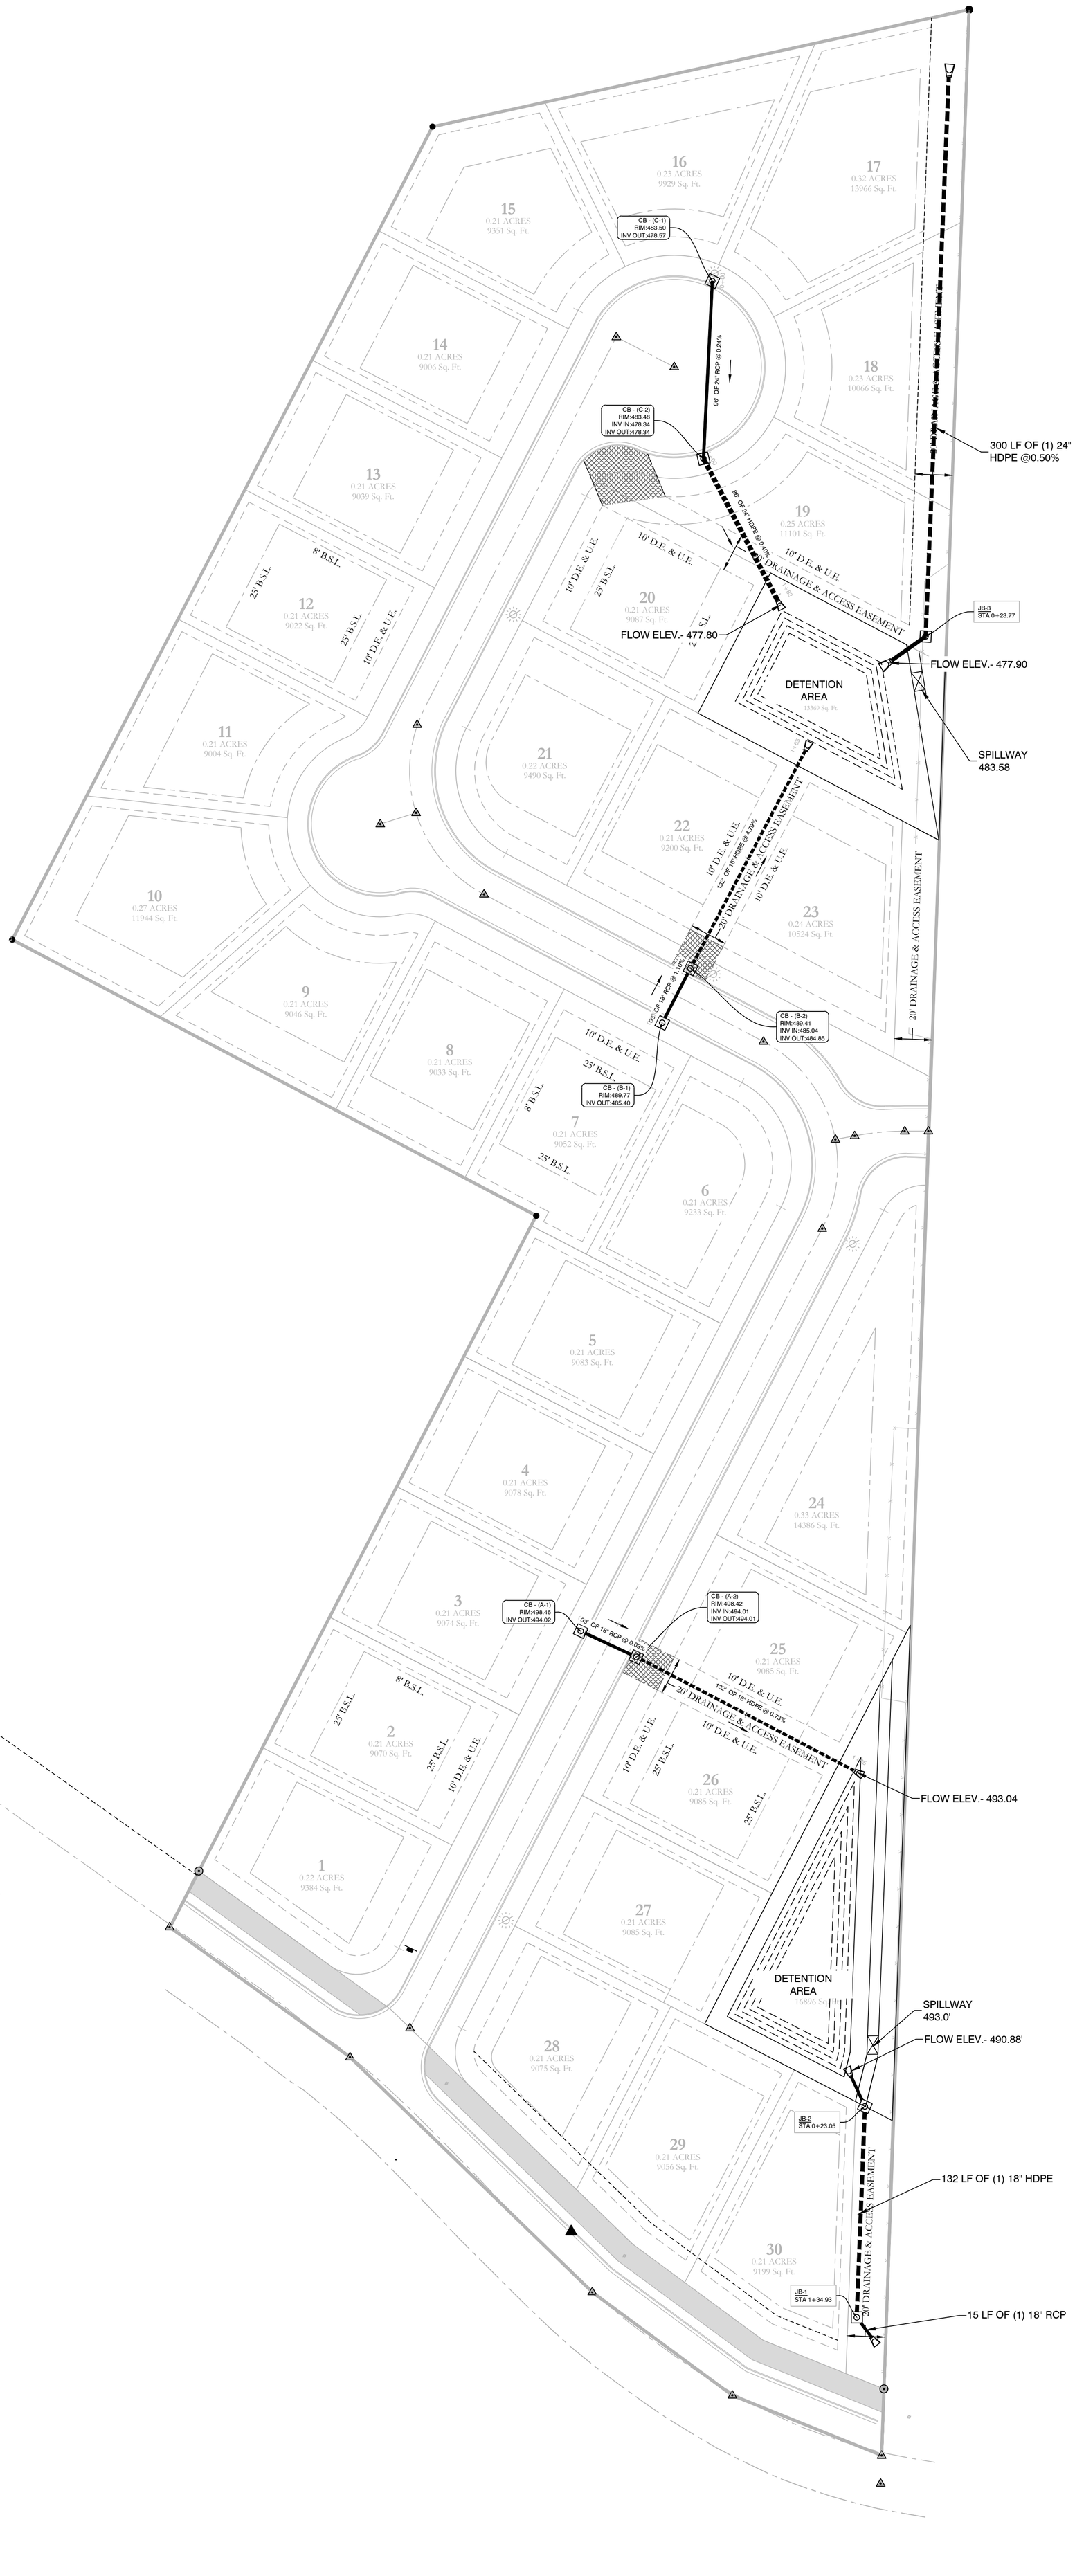

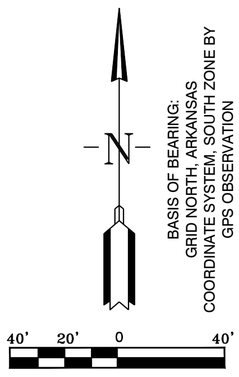

CERTIFICATE OF AUTHORIZATION
HOPE CONSULTING, INC.
No. 1931
ARKANSAS

STATE OF ARKANSAS
REGISTERED PROFESSIONAL ENGINEER
No. 14048
WILLIAM W. McFADDEN

HDPE

RCP

HOPE CONSULTING
ENGINEERS - SURVEYORS

117 S. Market Street,
Benton, Arkansas 72015
PH. (501)315-2626
FAX (501) 315-0024
www.hopeconsulting.com


FOR USE AND BENEFIT OF:
OLTMANS DEVELOPMENT


CORAL RIDGE SUBDIVISION
DRAINAGE AS-BUILTS PLAN
BRYANT, SALINE COUNTY, ARKANSAS

DATE:	09/26/2022	C.A.D. BY:	DRAWING NUMBER:
REVISED:		CHECKED BY:	21-0209
SHEET:		SCALE:	

VICINITY MAP:



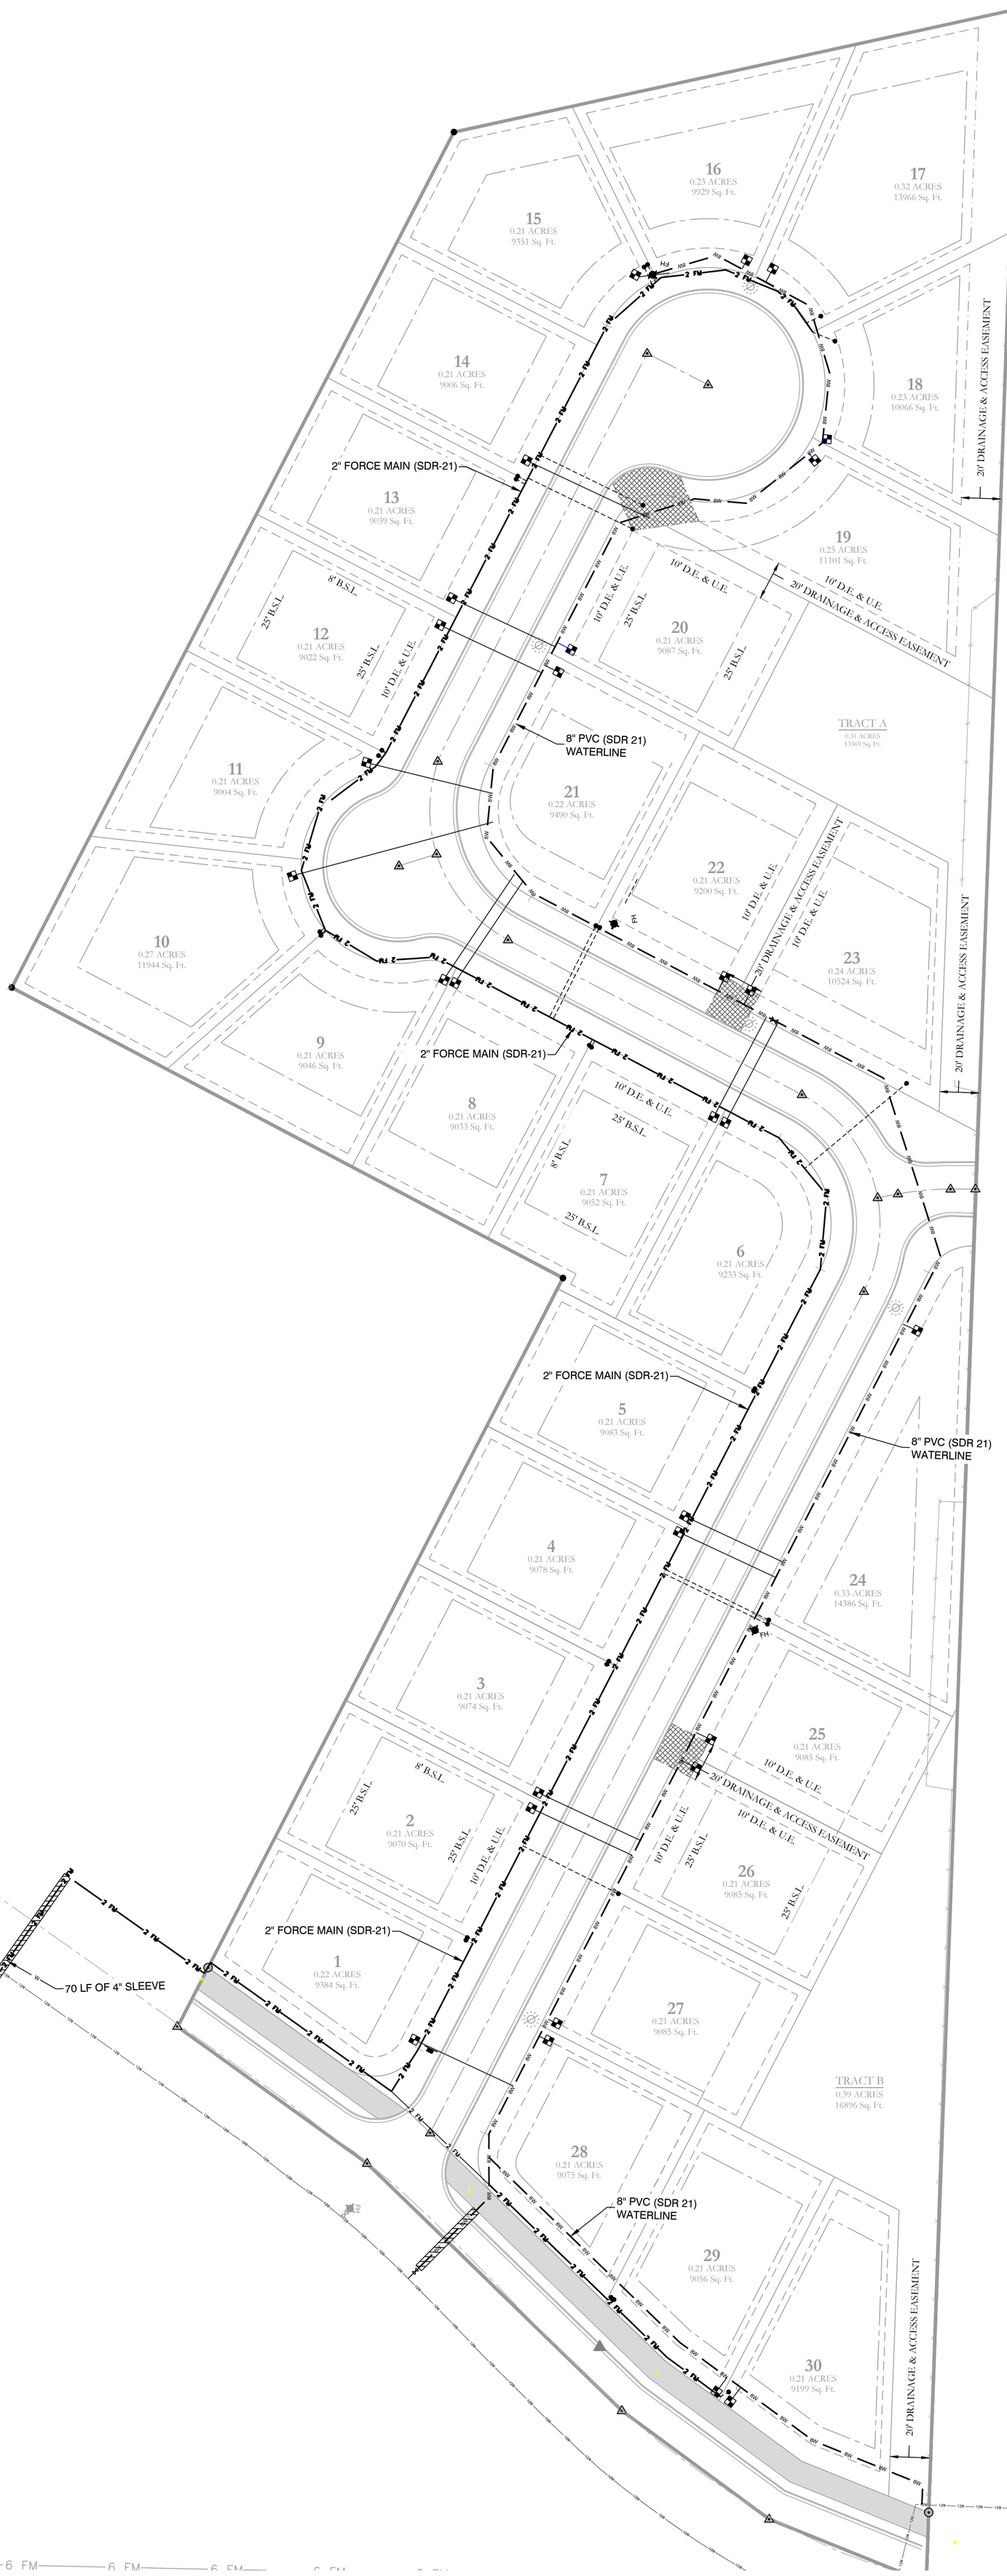


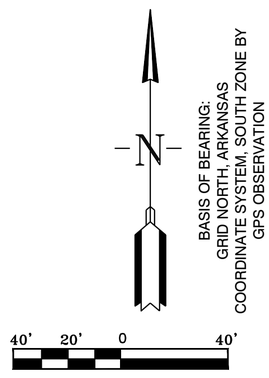

WATER LEGEND:

- DUAL WATER METERS
- SINGLE WATER METER
- GATE VALVE
- 45º FITTING
- 90º FITTING
- TEE FITTING
- CROSS FITTING
- FIRE HYDRANT

SEWER LEGEND:

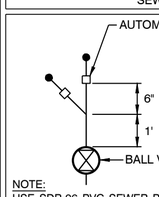

NOTE:
USE SDR-26 PVC SEWER PIPE EXCEPT WHERE DUCTILE IRON PIPE REQUIRED FOR COVER. USE DUCTILE IRON PIPE WHERE 3' MINIMUM COVE CANNOT BE MAINTAINED.
CONTRACTOR IS RESPONSIBLE FOR LOCATING ALL BURIED UTILITIES PRIOR TO CONSTRUCTION.

STATE OF ARKANSAS
PROFESSIONAL ENGINEER
No. 14048
WILLIAM W MCFADDEN

HOPE CONSULTING
ENGINEERS - SURVEYORS
117 S. Market Street,
Benton, Arkansas 72015
PH. (501)315-2626
FAX (501) 315-0024
www.hopeconsulting.com

FOR USE AND BENEFIT OF:
OLTMANS DEVELOPMENT

CORAL RIDGE SUBDIVISION
SANITARY SEWER AND WATER AS-BUILTS PLAN
BRYANT, SALINE COUNTY, ARKANSAS

DATE:	09/26/2022	C.A.D. BY:	DRAWING NUMBER: 21-0209
REVISED:	6/07/2022	CHECKED BY:	
SHEET:	C-3.0	SCALE:	

500	1S	14W	0	3	330	62	1762