

CONSTRUCTION PLANS FOR

BRYANT REALTY COMPANY, LLC
MARKET PLACE CENTER II
PHASE 2
BRYANT, ARKANSAS

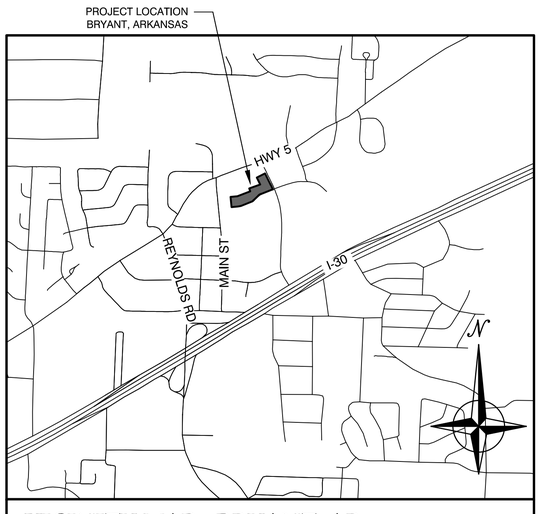

VICINITY MAP - BRYANT, AR

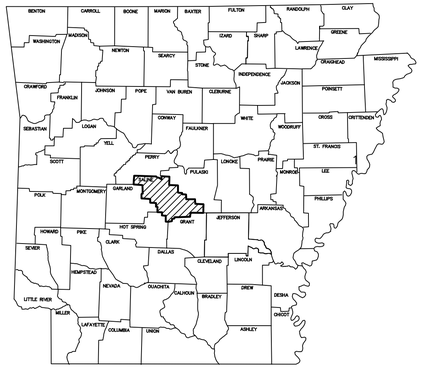

ARKANSAS

DRAWING INDEX:

V1.0	FINAL PLAT MARKET PLACE II PHASE II SUBDIVISION
C2.0	GRAVITY SEWER MAIN C PLAN AND PROFILE
C3.0	SCHEMATIC PLAN

Prepared by:

GarNat Engineering, LLC

P.O. Box 116
Benton, AR 72018
Ph (501) 408-4650


3825 Mt Carmel Road
Bryant, AR 72022
www.garnatengineering.com

Designing our client's success


STATE OF ARKANSAS
Vernon J. Williams
REGISTERED PROFESSIONAL ENGINEER
NO. 9551
VERNON J. WILLIAMS

10-27-2022

CERTIFICATE OF AUTHORIZATION
GarNat Engineering, LLC
No. 2174
ARKANSAS

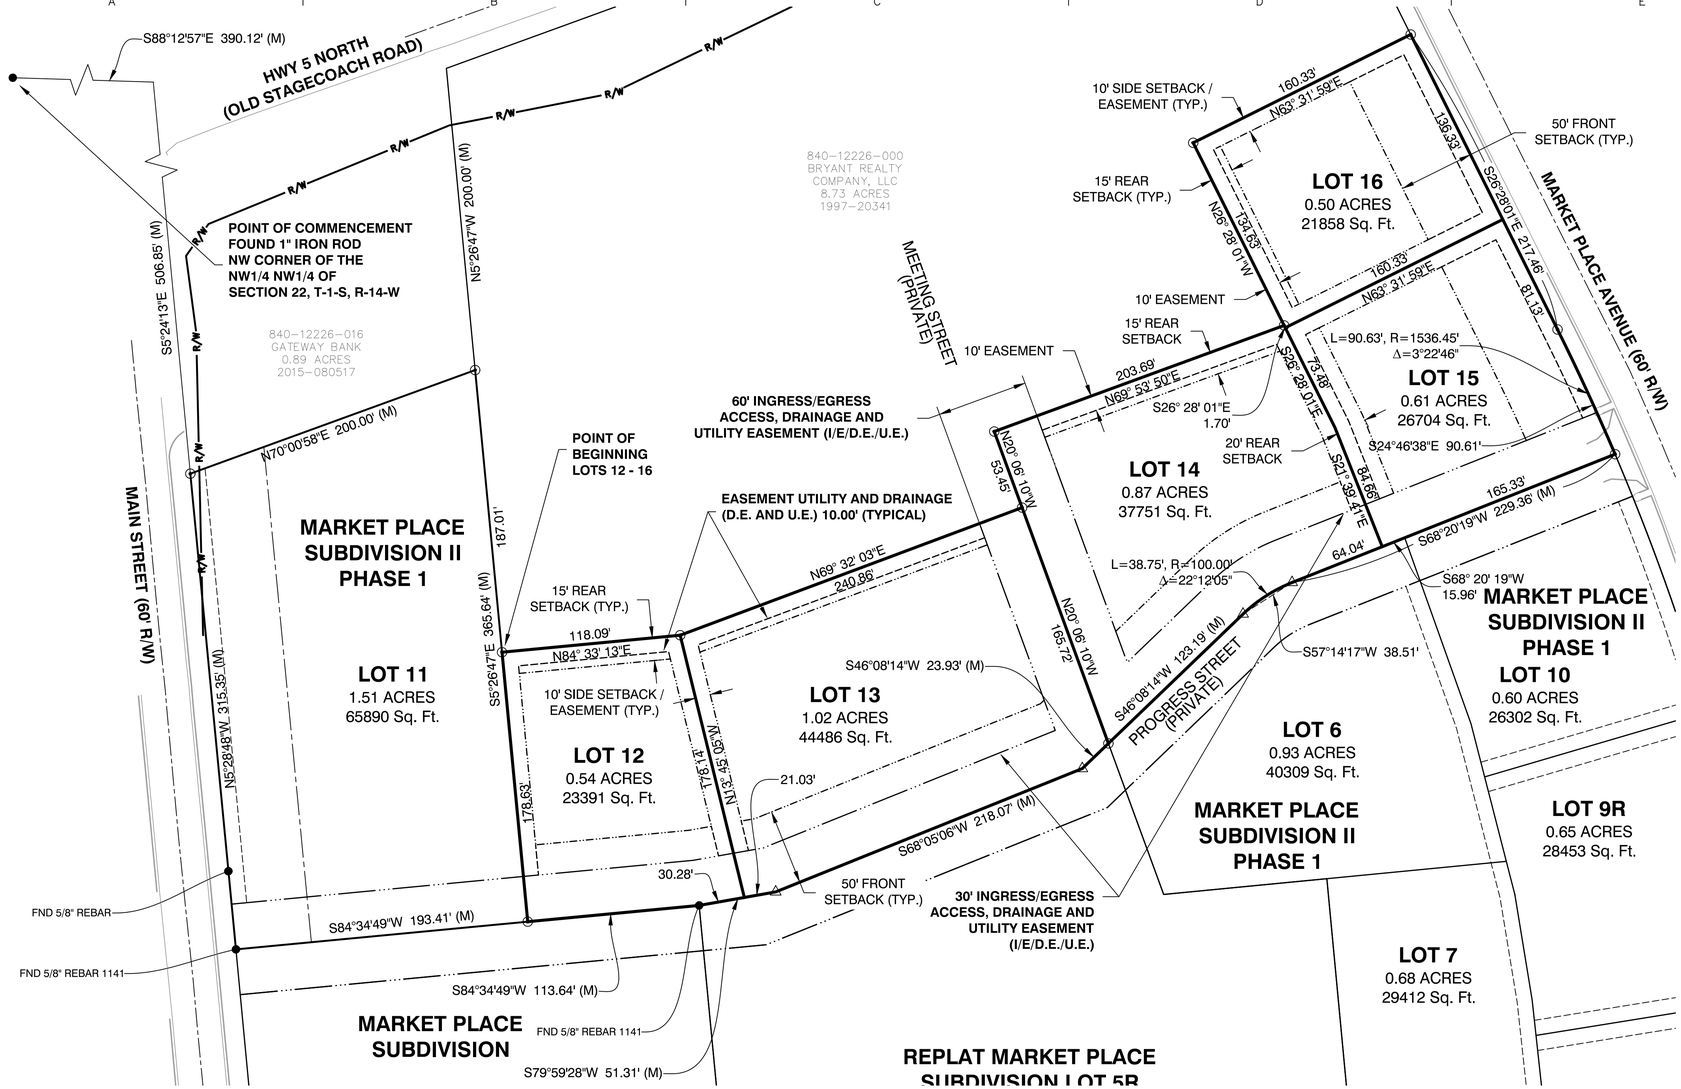

VICINITY MAP

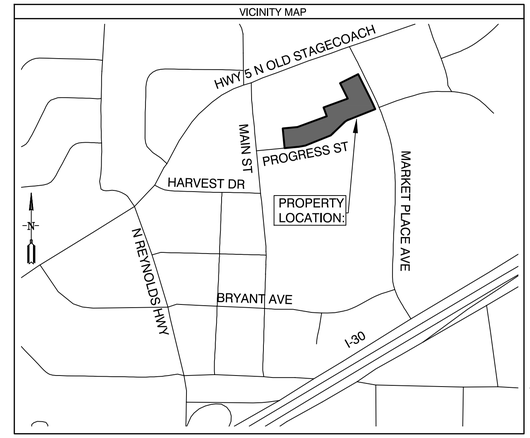

SUBDIVISION DESCRIPTION:

LOCATED IN THE NORTHWEST QUARTER OF THE NORTHWEST QUARTER (NW1/4 NW1/4) AND THE NORTHEAST QUARTER OF THE NORTHWEST QUARTER (NE1/4 NW1/4), OF SECTION 22, TOWNSHIP 1 SOUTH, RANGE 14 WEST, SALINE COUNTY, ARKANSAS, MORE PRECISELY DESCRIBED AS FOLLOWS:

LOTS 12 - 16:
COMMENCING AT A FOUND 1" IRON ROD LOCATED AT THE NORTHWEST CORNER OF THE SAID NW1/4 NW1/4 OF SECTION 22, T-1-S, R-14-W; THENCE S 88°12'57" E, ALONG THE NORTH LINE THEREOF FOR A DISTANCE OF 390.12 FEET TO A POINT; THENCE S 5°24'13" E, ALONG THE EAST RIGHT OF WAY LINE OF MAIN STREET A DISTANCE OF 506.85 FEET TO A SET 1/2" REBAR WITH CAP #1573 LOCATED AT THE SOUTHWEST CORNER OF GATEWAY BANK PROPERTY DEED BOOK 2015 PAGE 080517; THENCE N 70°00'58" E, LEAVING SAID RIGHT OF WAY AND ALONG SOUTH LINE OF GATEWAY BANK PROPERTY FOR A DISTANCE OF 200.00 FEET TO A SET 1/2" REBAR WITH CAP #1573; THENCE S 5°26'47" E FOR A DISTANCE OF 187.01 FEET TO A SET 1/2" REBAR WITH CAP #1573 FOR THE **POINT OF BEGINNING;** THENCE N 84°33'13" E FOR A DISTANCE OF 118.09 FEET TO A SET 1/2" REBAR WITH CAP #1573; THENCE N 69°32'03" E FOR A DISTANCE OF 240.86 FEET TO A SET 1/2" REBAR WITH CAP #1573 IN THE CENTER OF MEETING STREET; THENCE N 20°06'10" W, ALONG THE CENTER OF SAID MEETING STREET, FOR A DISTANCE OF 53.45 FEET TO A SET 1/2" REBAR WITH CAP #1573; THENCE N 69°53'50" E, LEAVING SAID MEETING STREET, FOR A DISTANCE OF 203.69 FEET TO A SET 1/2" REBAR WITH CAP #1573; THENCE N 26°28'01" W FOR A DISTANCE OF 134.63 FEET TO A SET 1/2" REBAR WITH CAP #1573; THENCE N 63°31'59" E FOR A DISTANCE OF 160.33 FEET TO A SET 1/2" REBAR WITH CAP #1573 LOCATED ON THE WEST RIGHT OF WAY OF MARKET PLACE AVENUE; THENCE S 26°28'01" E, ALONG SAID RIGHT OF WAY, FOR A DISTANCE OF 217.46 FEET TO A SET 1/2" REBAR WITH CAP #1573; THENCE ALONG A CURVE TO THE RIGHT, WITH A RADIUS OF 1536.45 FEET AND A LENGTH OF 90.63 FEET, WHOSE CHORD BEARS S 24°46'38" E - 90.61 FEET TO SET MAG NAIL WITH SHINER WASHER #1573 IN THE CENTER OF PROGRESS STREET AND THE NORTH LINE OF MARKET PLACE II SUBDIVISION PHASE 1; THENCE S 68°20'19" W, CONTINUING ALONG SAID PROGRESS STREET AND NORTH LINE OF MARKET PLACE II SUBDIVISION, FOR A DISTANCE OF 229.36 FEET TO A POINT; THENCE CONTINUING ALONG SAID PROGRESS STREET AND NORTH LINE OF MARKET PLACE II SUBDIVISION, ALONG A CURVE TO THE LEFT, WITH A RADIUS OF 100.00 FEET AND A LENGTH OF 38.75 FEET, WHOSE CHORD BEARS S 57°14'17" W - 38.51 FEET TO A POINT; THENCE S 46°08'14" W, CONTINUING ALONG SAID PROGRESS STREET AND NORTH LINE OF MARKET PLACE II SUBDIVISION, FOR A DISTANCE OF 123.19 FEET TO A FOUND MAG NAIL WITH SHINER WASHER #1573 LOCATED ON THE NORTH LINE OF LOT 5R OF THE REPLAT OF MARKET PLACE SUBDIVISION; THENCE S 46°08'14" W, CONTINUING ALONG SAID PROGRESS STREET AND NORTH LINE OF LOT 5R, FOR A DISTANCE OF 23.93 FEET TO A POINT; THENCE S 68°05'06" W, CONTINUING ALONG SAID PROGRESS STREET AND NORTH LINE OF LOT 5R, FOR A DISTANCE OF 218.07 FEET TO A POINT; THENCE S 79°59'28" W, CONTINUING ALONG SAID PROGRESS STREET AND NORTH LINE OF LOT 5R, FOR A DISTANCE OF 51.31 FEET TO A FOUND 5/8" REBAR WITH CAP #1141 LOCATED AT THE NORTHWEST CORNER OF LOT 5R; THENCE S 84°34'49" W, CONTINUING ALONG SAID PROGRESS STREET AND NORTH LINE OF MARKET PLACE SUBDIVISION, FOR A DISTANCE OF 113.64 FEET TO A FOUND MAG NAIL WITH SHINER WASHER #1573 LOCATED AT THE SOUTHEAST CORNER OF LOT 11 OF MARKET PLACE II SUBDIVISION PHASE 1; THENCE N 5°26'47" W, ALONG THE EAST LINE OF SAID LOT 11, FOR A DISTANCE OF 173.63 FEET TO THE **POINT OF BEGINNING**, CONTAINING 3.54 ACRES MORE OR LESS.

DOCUMENTS USED:

- SURVEY BY REAL ESTATE SERVICES OF SALINE COUNTY, INC. DATED 11/15/2018 KERRY LANE PLS #1141
- SURVEY BY REAL ESTATE SERVICES OF SALINE COUNTY, INC. DATED 4/2/2007 KERRY LANE PLS #1141
- SURVEY BY REAL ESTATE SERVICES OF SALINE COUNTY, INC. DATED 1/4/2018 KERRY LANE PLS #1141
- DEED BOOK 2016 PAGE 016810
- DEED BOOK 1997 PAGE 20341
- DEED BOOK 2008 PAGE 82137
- DEED BOOK 2000 PAGE 27385
- DEED BOOK 2000 PAGE 27387
- DEED BOOK 2015 PAGE 080517
- DEED BOOK 2018 PAGE 000713
- FINAL PLAT OF MARKET PLACE SUBDIVISION SURVEYED BY GARNAT ENGINEERING, LLC DATED 6/4/2019 GEORGE WOODEN PLS #1573

BASIS OF BEARINGS:

BENCHMARK(S) PROVIDED ARE REBAR AND COORDINATES ON BENCHMARKS ARE NORTH AMERICAN DATUM 1983, ARKANSAS SOUTH ZONE, US SURVEY FEET, GRID COORDINATES AND ELEVATIONS ARE NAVD 1988. COORDINATES AND ELEVATIONS WERE ESTABLISHED USING GPS AND WERE PROCESSED USING THE NATIONAL GEODETIC SURVEY'S "ONLINE POSITIONING USER SERVICE" (OPUS).

CERTIFICATIONS:

BY AFFIXING MY SEAL AND SIGNATURE, I GEORGE P. WOODEN, PS NO.1573, HEREBY CERTIFY THAT THIS DRAWING CORRECTLY DEPICTS A SURVEY COMPILED UNDER MY SUPERVISION ON SEPTEMBER 11, 2019.

THIS SURVEY WAS BASED ON LEGAL DESCRIPTIONS AND TITLE WORK FURNISHED BY OTHERS AND DOES NOT REPRESENT A TITLE SEARCH.

THIS PROPERTY IS NOT LOCATED IN THE 100 YEAR FLOOD PLAIN. THE PROPERTY SHOWN ON THIS PLAT IS LOCATED IN ZONE "X" OF THE F.E.M.A. MAP PANEL 05125C0240E EFFECTIVE DATE JUNE 05, 2020.

PLAT CERTIFICATES:

OWNER:
Name: Bryant Realty Company, LLC
Address: 422 North Main Street, Benton, AR 72015

DEVELOPER:
Name: Bryant Realty Company, LLC
Address: 422 North Main Street, Benton, AR 72015

CERTIFICATE OF OWNER:
We, the undersigned, owners of the real estate shown and described herein do hereby certify that we have laid off, platted and subdivided, and do hereby lay off, plat and subdivide said real estate in accordance with the within plat.

Date: _____ Signed: _____
Fred Briner, Agent
Bryant Realty Company, LLC

Source of Title: SALINE COUNTY, ARKANSAS
Saline County Document# 1997-20341

CERTIFICATE OF ENGINEERING ACCURACY:
I, Vernon J. Williams, hereby certify that this plat correctly represents a survey and a plan made by me or under my supervision; that all monuments shown hereon actually exist and their locations, size, type, and material are correctly shown; and that all requirements of the City of Bryant Subdivision Rules and Regulations have been fully complied with.

Date: _____ Signed: _____
Vernon J. Williams
Registered Professional Engineer
No. 9551, Arkansas

CERTIFICATE OF RECORDING:

CERTIFICATE OF SURVEYING ACCURACY:
I, George P. Wooden, hereby certify that this plat correctly represents a boundary survey made by me or under my supervision; that the boundary lines shown hereon correspond with the description in the deeds cited in the above Source of Title; and that all monuments which were found or placed on the property are correctly described and located.

Date: _____ Signed: _____
George P. Wooden
Registered Land Surveyor
No. 1573, Arkansas

CERTIFICATE OF FINAL PLAT APPROVAL:
Pursuant to the City of Bryant Subdivision Rules and Regulations, this document was given approval by the Bryant Planning Commission. All of the document is hereby accepted, and this certificate executed under the authority of said rules and regulations.

Date: _____ Signed: _____
Rick Johnson, Chairman
Bryant Planning Commission

CERTIFICATE OF AUTHORIZATION
GarNat Engineering, LLC
No. 2174
ARKANSAS

FINAL PLAT
MARKET PLACE II SUBDIVISION
PHASE 2
LOTS 12 THROUGH 16
CITY OF BRYANT
SALINE COUNTY, ARKANSAS

STATE OF ARKANSAS
REGISTERED PROFESSIONAL ENGINEER
VERNON J. WILLIAMS
NO. 9551

PROPERTY SPECIFICATIONS:
ZONING CLASSIFICATION: C-2
SOURCE OF WATER: CITY OF BRYANT SOURCE OF SEWER: CITY OF BRYANT
BUILDING SETBACKS (SB): FRONT - 50' REAR - 15' SIDE - 0'
EASEMENTS: UTILITY & DRAINAGE (D.E. & U.E.) FRONT, SIDE AND REAR - 10' OR AS SHOWN INGRESS/EGRESS (I/E) LOT CORNERS: SET #4 REBAR WITH CAP

SURVEY LEGEND
△ - Computed point
● - Found monument
⊙ - Set #4 RB/Plas. Cap or Mag Nail with Shiner
(M)-Measured
(R)-Record
(P)-Platted

N
50' 25' 0 50'

SURVEY PLAT CODE:
500-01S-14W-0-22-400-62-1573

BY	REVISION	DATE

GNE Designing our client's success

GarNat Engineering, LLC
P.O. Box 116, Benton, AR 72018
3825 Mt Carmel Road, Bryant, AR 72022
Ph. (501) 408-4650
garnatengineering@gmail.com

BRYANT REALTY COMPANY, LLC
MARKET PLACE II SUBDIVISION
CITY OF BRYANT
SALINE COUNTY, ARKANSAS

REGISTERED PROFESSIONAL LAND SURVEYOR
STATE OF ARKANSAS
NO. 1573
SIGNATURE
GEORGE P. WOODEN


CONTENTS:
FINAL PLAT
LOTS 12 - 16
PHASE 2


PROJECT NO:
18087

DATE:
OCT. 5, 2022

SHEET NO:
V1.0

J:\Projects\2018 Projects\18087 Bart Ferguson - Market Place II Final Plat Lots 12 through 16 Phase 2 - 102522.dwg

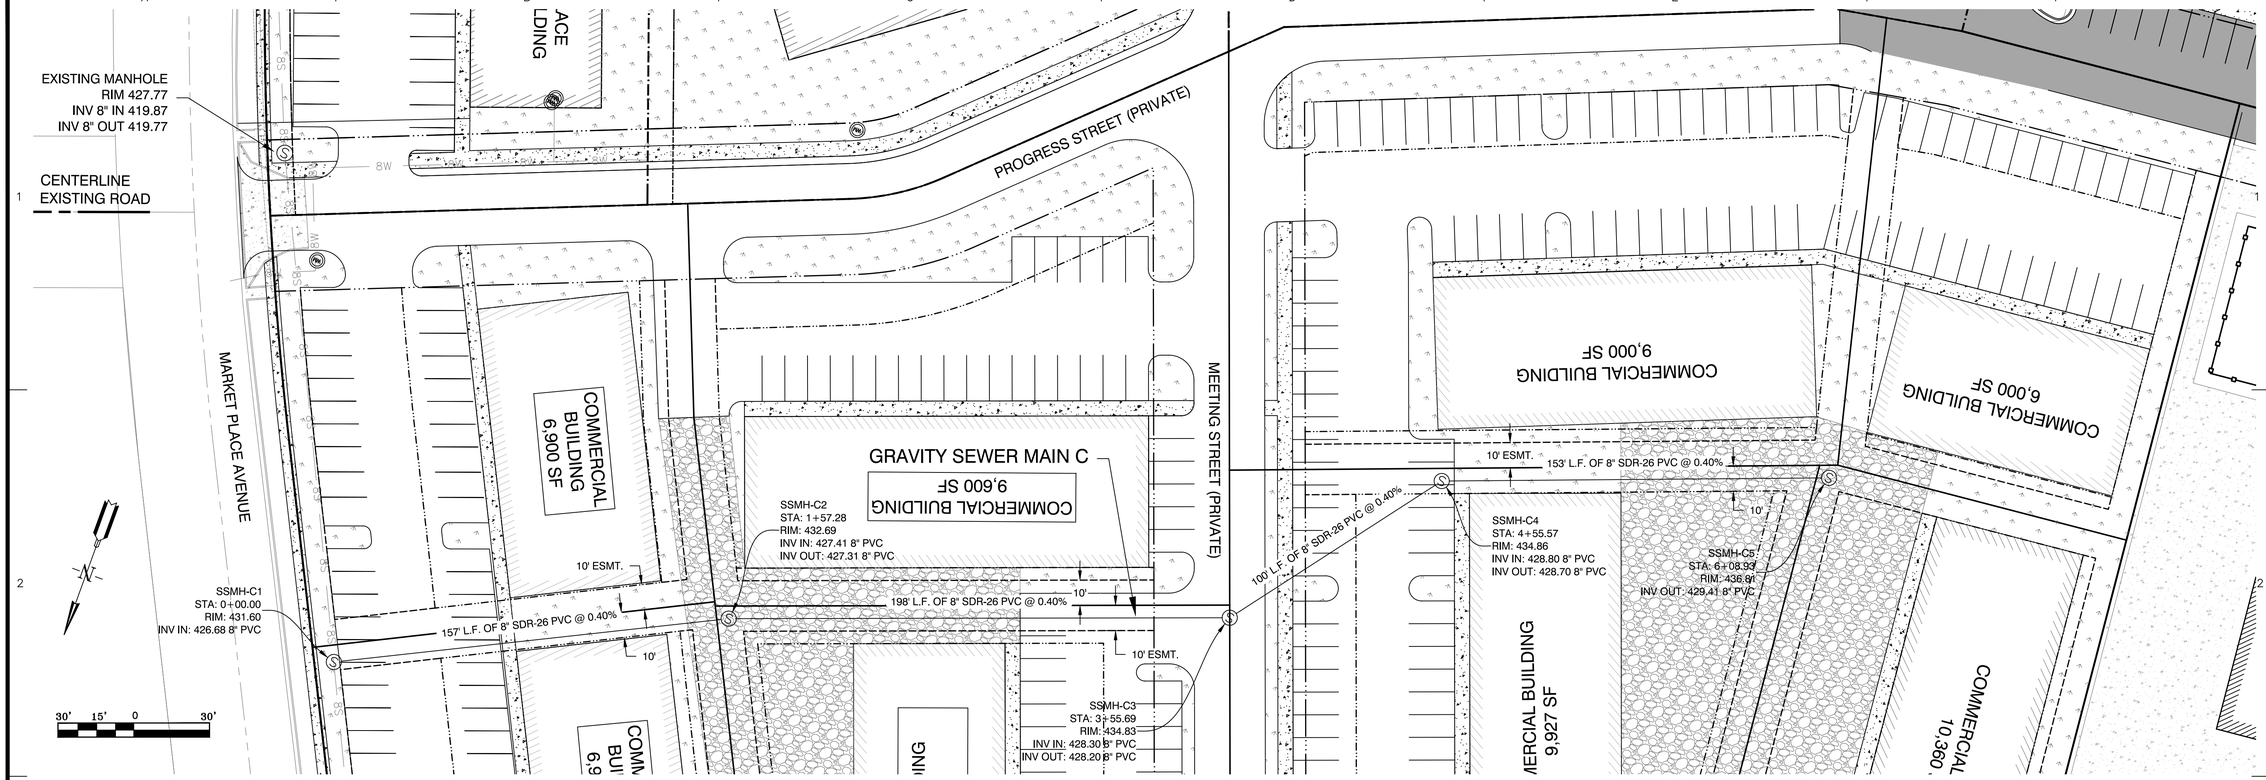

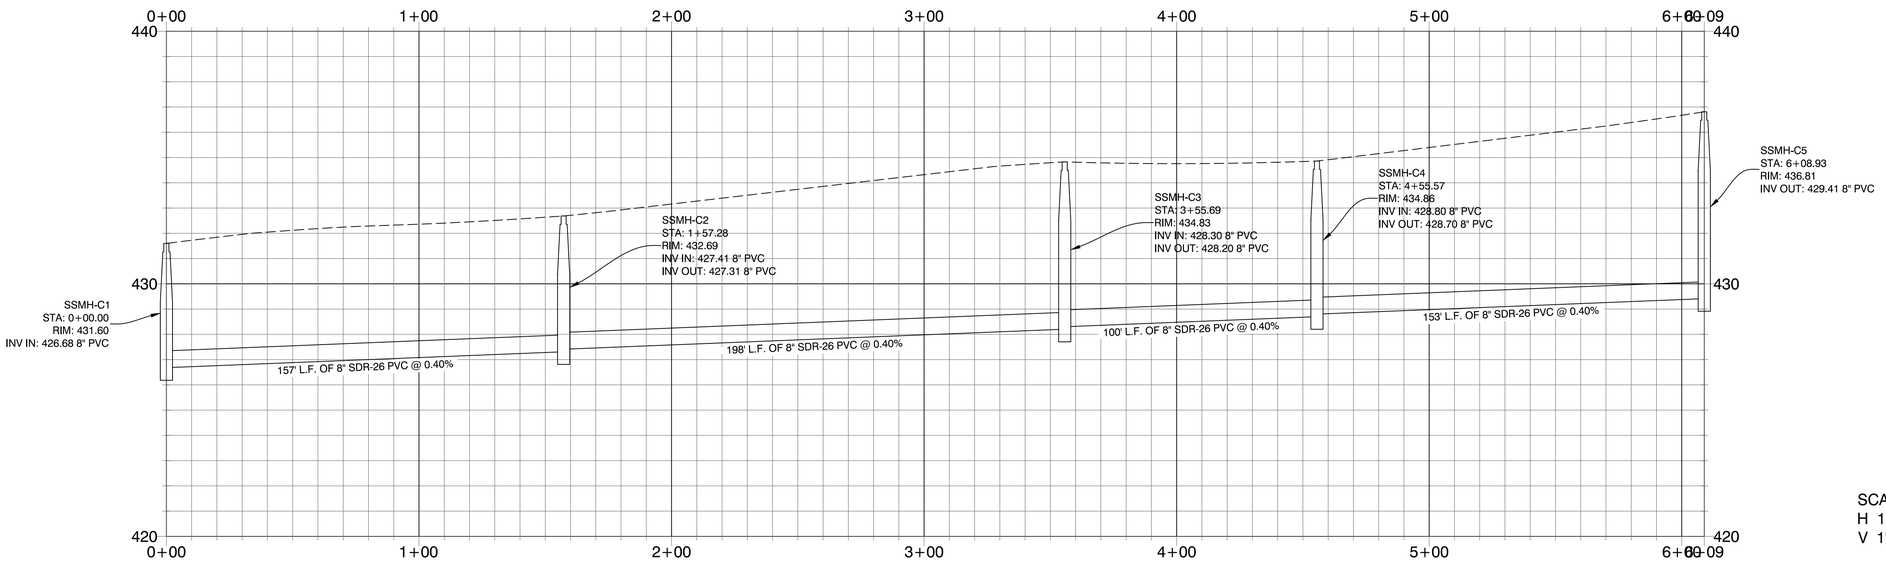

GRAVITY SEWER MAIN C PROFILE

SCALE:
H 1" = 30'
V 1" = 3'

DATE	REVISION	BY
01-25-22	REVISED PER AS-BUILT	GPW

GNE Designing our client's success
GarNat Engineering, LLC
P.O. Box 116
Benton, AR 72018
3825 Mt Carmel Rd
Bryant, AR 72022
garnatengineering@gmail.com
Ph (501) 408-4650

MARKET PLACE CENTER II
PHASE 2
CITY OF BRYANT
SALINE COUNTY, ARKANSAS

STATE OF ARKANSAS
Vernon J. Williams
REGISTERED PROFESSIONAL ENGINEER
NO. 9551
VERNON J. WILLIAMS

10-27-2022

CONTENTS:
GRAVITY SEWER MAIN C PLAN & PROFILE

PROJECT NO: 18087

DATE: OCTOBER 2022

SHEET NO: C2.0

A:\Projects\2018 Projects\18087 Bart Ferguson - Market Place Center\Drawings\CAD\Layout\18087 - Market Place II - Gravity Sewer - Phase II - 102022.dwg

LEGEND:

- GREEN SPACE
- GRAVEL
- CONCRETE
- EXISTING COMMERCIAL CONSTRUCTION PER CITY OF BRYANT COMMERCIAL BUILDING REQUIREMENTS.
- PROPOSED COMMERCIAL CONSTRUCTION PER CITY OF BRYANT COMMERCIAL BUILDING REQUIREMENTS.
- * SCREENED TRASH CART ENCLOSURE

12' X 12' DUMPSTER LOCATION

12' X 12' DUMPSTER LOCATION

CENTERLINE EXISTING ROAD

CENTERLINE EXISTING COMMERCIAL DRIVEWAY

CENTERLINE EXISTING COMMERCIAL DRIVEWAY

MEETING STREET (PRIVATE)

PROGRESS STREET (PRIVATE)

COMMERCIAL BUILDING 10,250 SF

COMMERCIAL BUILDING 8,180 SF

COMMERCIAL BUILDING 6,160 SF

COMMERCIAL BUILDING 8,267 SF

COMMERCIAL BUILDING 6,480 SF

COMMERCIAL BUILDING 9,600 SF

COMMERCIAL BUILDING 6,040 SF

COMMERCIAL BUILDING 10,360 SF

COMMERCIAL BUILDING 9,827 SF

COMMERCIAL BUILDING 9,000 SF

COMMERCIAL BUILDING 6,000 SF

3418 MAIN COMMERCIAL BUILDING 11,970 SF FF APPROX 441.3

1429 MARKET PLACE COMMERCIAL BUILDING 6,328 SF FF=438

305 PROGRESS COMMERCIAL BUILDING 9,600 SF FF=433

317 MARKET PLACE COMMERCIAL BUILDING 7,380 SF FF=436

205 PROGRESS COMMERCIAL BUILDING 8,400 SF FF=436

105 PROGRESS COMMERCIAL BUILDING 6,960 SF FF=437.59

221 PROGRESS COMMERCIAL BUILDING 9,600 SF FF=436.5

265 PROGRESS COMMERCIAL BUILDING 9,600 SF FF=435.50

327 PROGRESS COMMERCIAL BUILDING 7,200 SF FF=435.50

365 PROGRESS COMMERCIAL BUILDING 12,000 SF FF=435.50

305 MARKET PLACE COMMERCIAL BUILDING 6,468 SF FF = 436.63

348 MAIN COMMERCIAL BUILDING 9,600 SF FF=437

NEW RETAIL BUILDING 2 6,000 SF FF=436

NEW WAREHOUSE BUILDING 4 8,400 SF FF=436.35

243 PROGRESS COMMERCIAL BUILDING 12,000 SF FF=437.26

FND 5/8" REBAR

FND 5/8" REBAR 1141

FND ALUM MON

FND RBR-CAP 1EBAR 1141

N

60' 30' 0 60'

DATE	REVISION	BY
01-25-22	REVISED PER AS-BUILT	GPW

GNE Designing our client's success

GarNat Engineering, LLC

P.O. Box 116
Benton, AR 72018

3825 Mt Carmel Rd
Bryant, AR 72022

Ph (501) 408-4650
garnatengineering@gmail.com

MARKET PLACE CENTER
CITY OF BRYANT
SALINE COUNTY, ARKANSAS

STATE OF ARKANSAS
Vernon J. Williams
REGISTERED PROFESSIONAL ENGINEER
NO. 9551
VERNON J. WILLIAMS

10-27-2022

CONTENTS:

SCHEMATIC PLAN

PROJECT NO: 18087

DATE: OCTOBER 2022

SHEET NO: C3.0

J:\Projects\2018 Projects\18087 Bart Ferguson - Market Place Center\Engineering\CAD\Sheets\18087 - SCHEMATIC - DR 10-05-22-01.dwg