


811 Know what's below. Call before you dig.

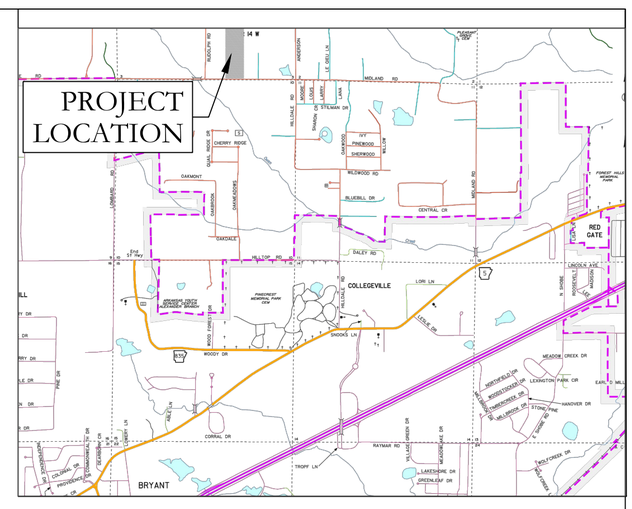

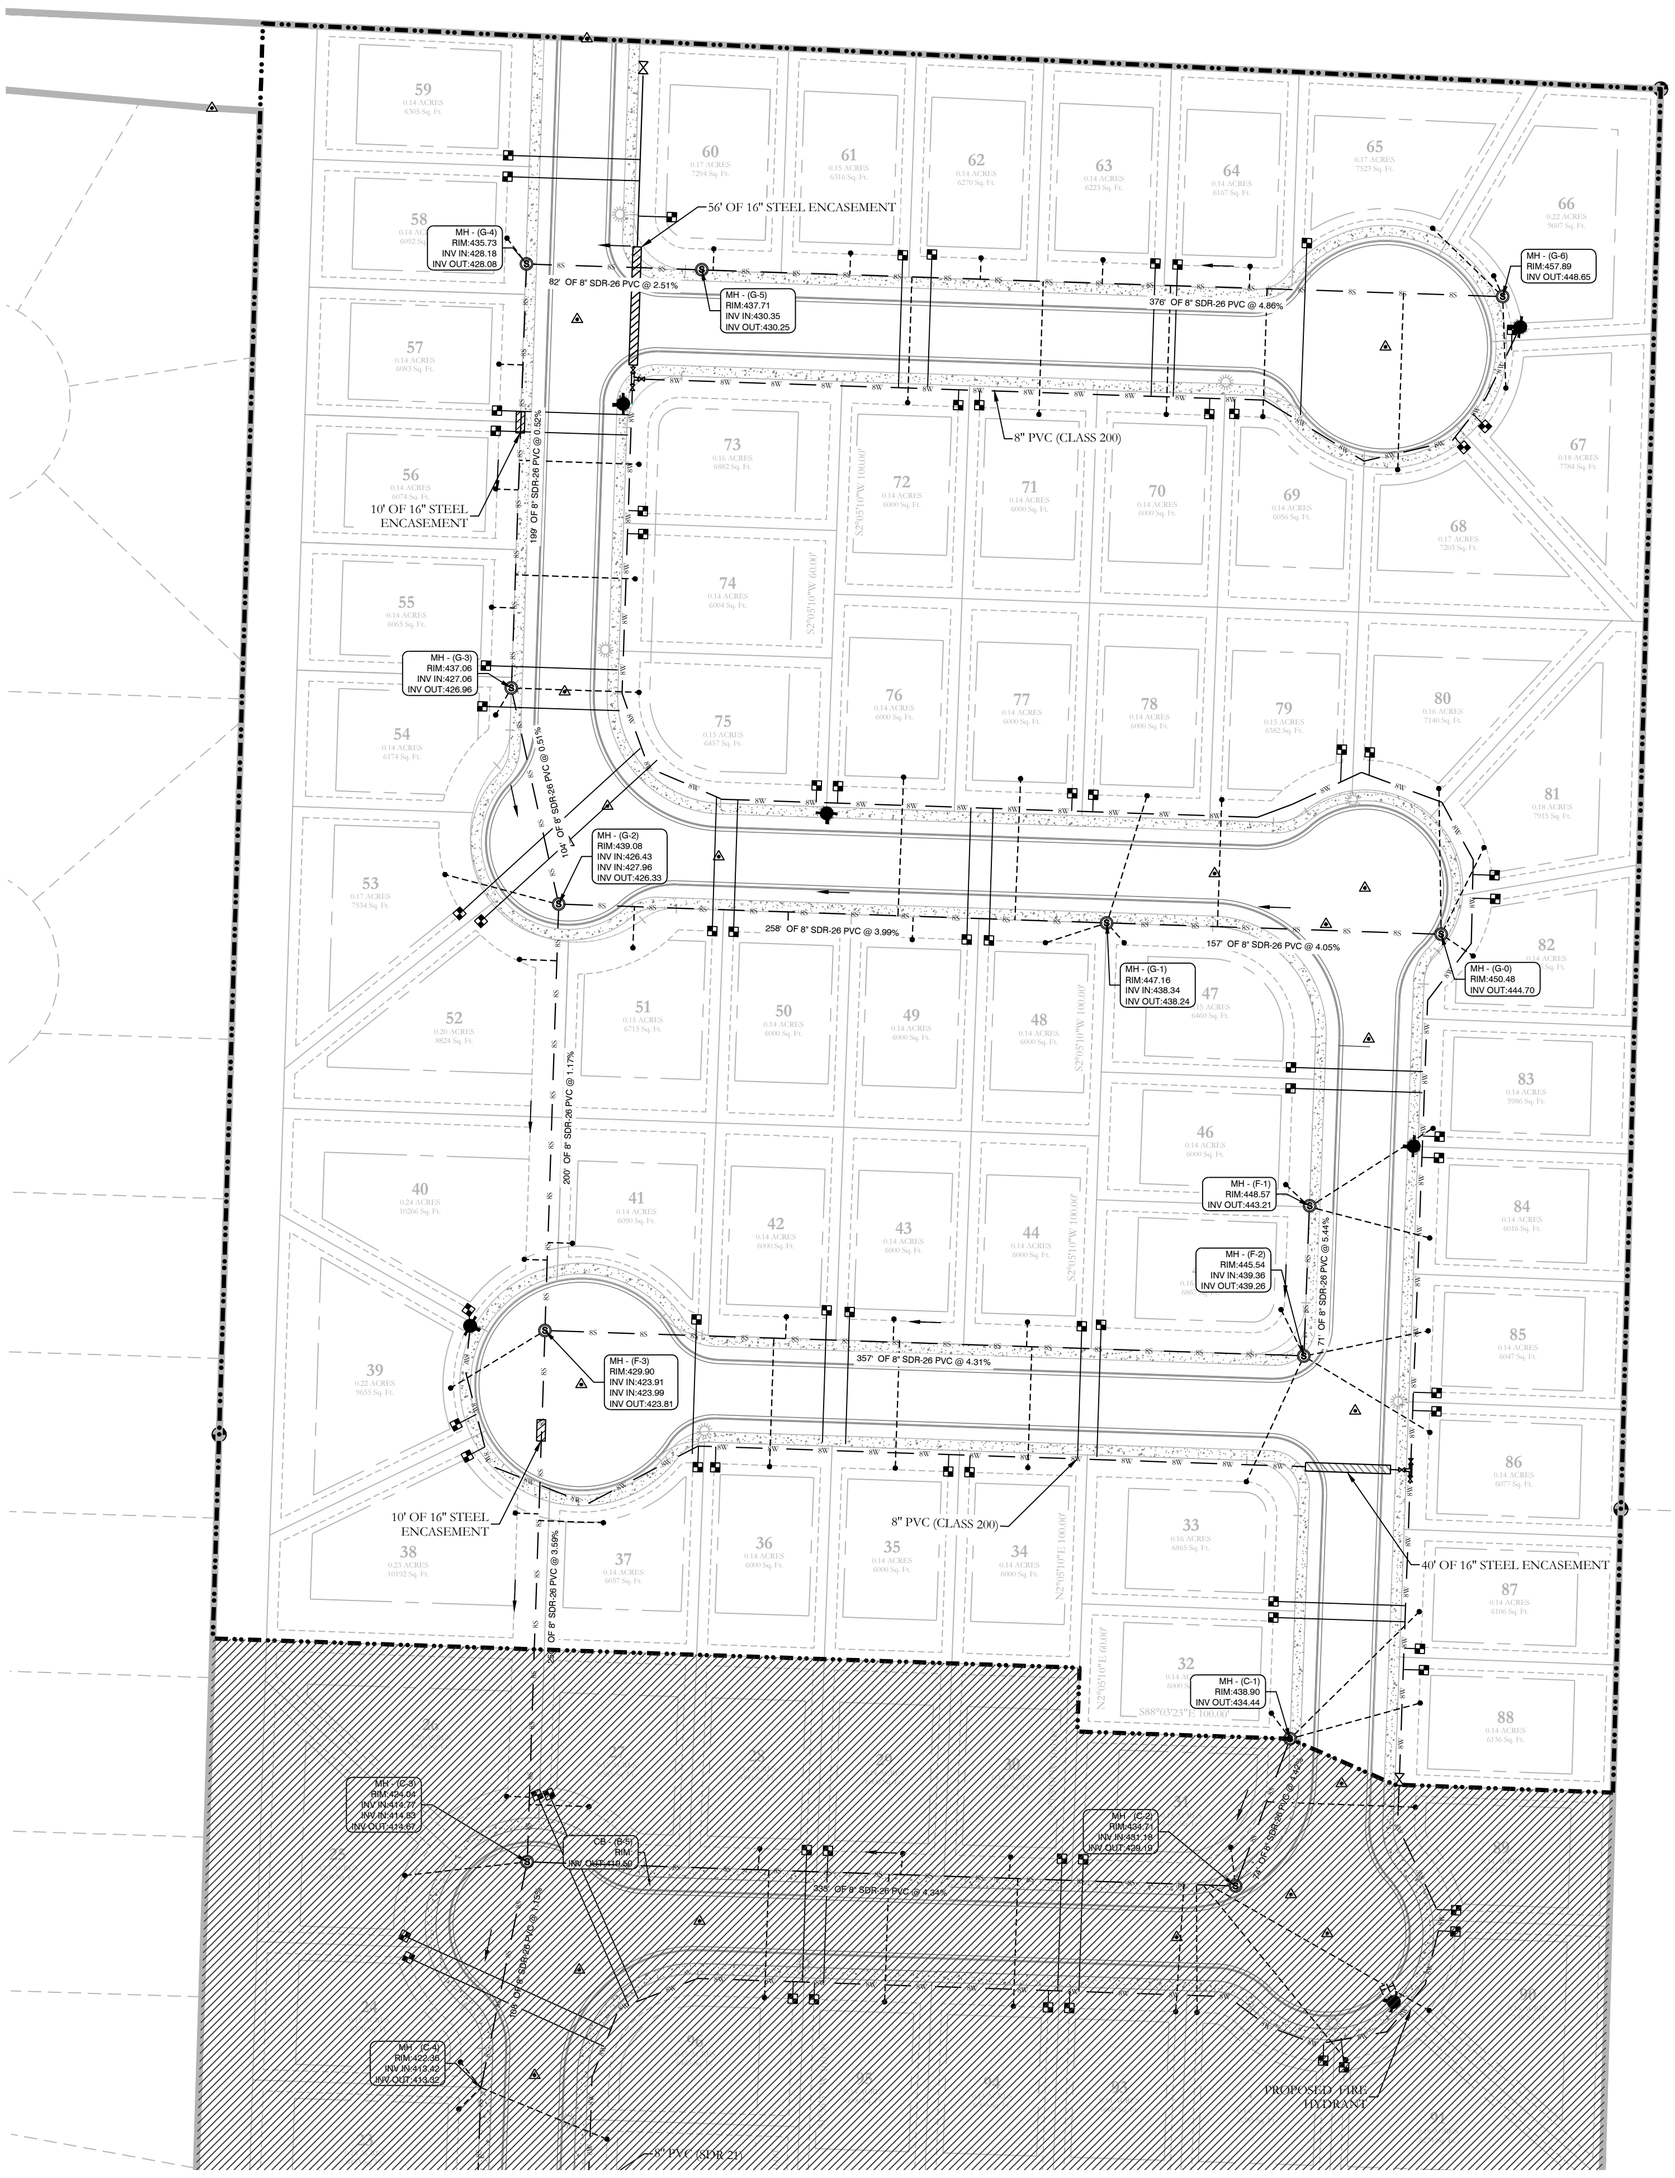

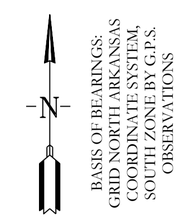

50' 25' 0 50'
BAR SCALE: 1" = 60'

SANITARY SEWER AND WATER AS-BUILTS
HILLDALE CROSSING PHASE 2
A SUBDIVISION IN SALINE COUNTY, ARKANSAS

SEWER LEGEND:	WATER LEGEND:	TYPICAL FIRE HYDRANT:
AIR RELEASE VALVE	3" BLOW OFF	3" BLOW OFF
CLEAN OUT	GATE VALVE	REDUCER 8"
ISOLATION VALVE	REDUCER	GATE VALVE
SEWER SERVICE	WATER LINE	FIRE HYDRANT
SEWER SERVICE	FIRE HYDRANT	
	DOUBLE WATER SERVICE	
	SINGLE WATER SERVICE	

NOTE:
PROPOSED SEWER MAINS IS TO HAVE TRACER WIRE. ALSO A NON-BIODEGRADABLE TAPE IDENTIFYING THE LINE AS "SEWER" MUST BE PLACED IN THE TRENCH ABOVE THE SEWER MIANS.

NOTE:
ALL FIRE HYDRANT LEADERS HAVE A GATE VALVE BETWEEN MAIN AND FIRE HYDRANT.

CERTIFICATE OF AUTHORIZATION
HOPE CONSULTING, INC.
No. 1931
ARKANSAS

HOPE CONSULTING
ENGINEERS - SURVEYORS
117 S. Market Street,
Benton, Arkansas 72015
PH. (501)315-2626
FAX (501) 315-0024
www.hopeconsulting.com

FOR USE AND BENEFIT OF:
HAVENS DEVELOPMENT, LLC

WATER & SEWER AS-BUILTS PLAN
HILLDALE CROSSING PHASE 2
A SUBDIVISION IN SALINE COUNTY, ARKANSAS

DATE: 12/20/2021		C.A.D. BY: B.JOHNSON	DRAWING NUMBER: 20-0169
REVISED:		CHECKED BY:	
		SCALE: 1"=50'	

500	01S	14W	0	03	330	62	1762

K:\LAND PROJECTS 2004\SUBDIVISIONS\2020\20-0169 HILLDALE CROSSING\PHASE 2\20-0169 HILLDALE CROSSING PHASE 2-AS-BUILTS-11-29-2022.DWG