

811 Know what's below. Call before you dig.

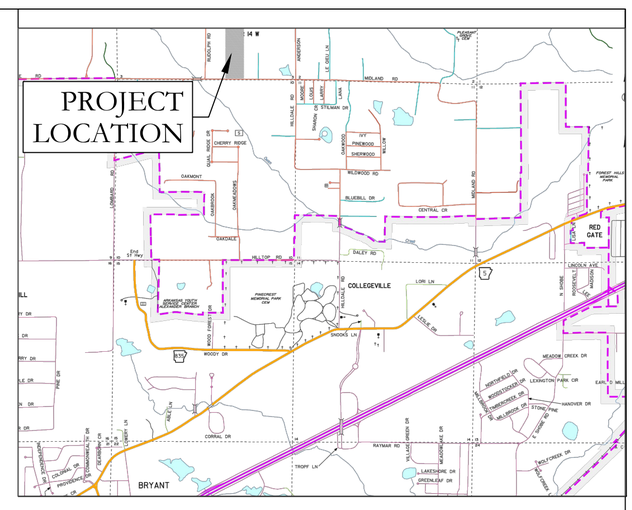

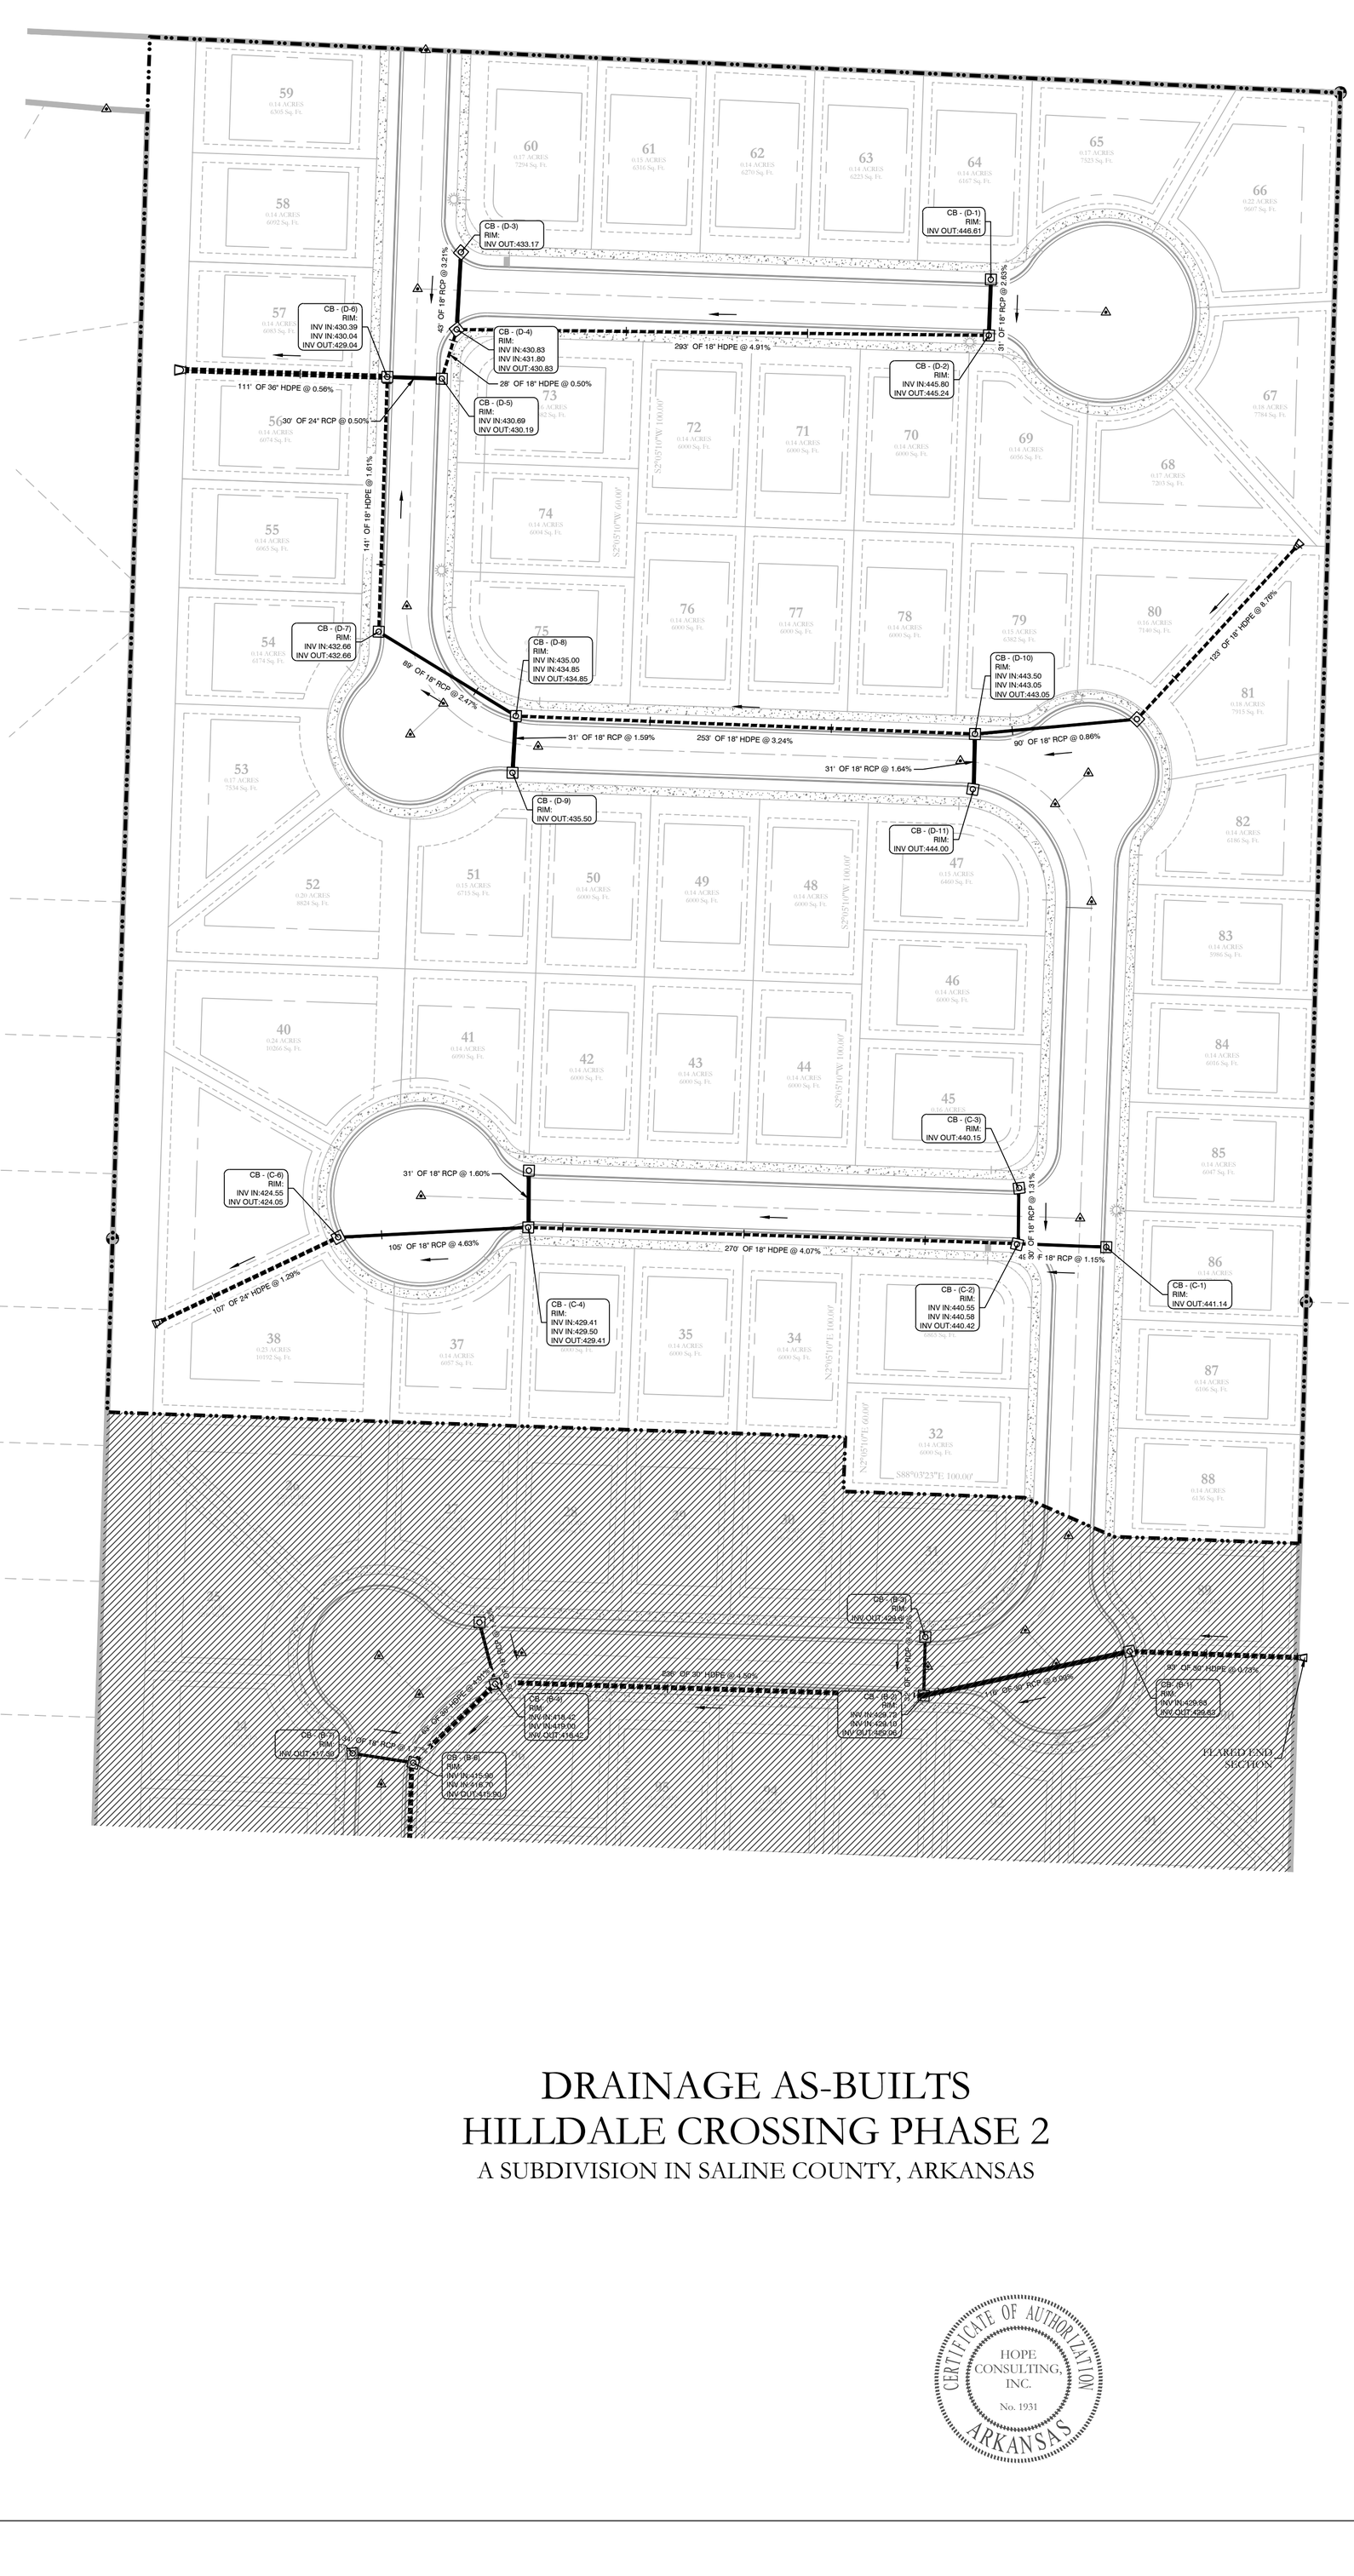

BASIS OF BEARINGS:
GRID NORTH ARKANSAS
COORDINATE SYSTEM,
SOUTH ZONE BY G.P.S.
OBSERVATIONS

50' 25' 0 50'
BAR SCALE: 1" = 60'

DRAINAGE AS-BUILTS
HILLDALE CROSSING PHASE 2
A SUBDIVISION IN SALINE COUNTY, ARKANSAS

CERTIFICATE OF AUTHORIZATION
HOPE CONSULTING, INC.
No. 1931
ARKANSAS

HOPE CONSULTING
ENGINEERS - SURVEYORS
117 S. Market Street,
Benton, Arkansas 72015
PH. (501)315-2626
FAX (501) 315-0024
www.hopeconsulting.com

FOR USE AND BENEFIT OF:
HAVENS DEVELOPMENT, LLC

DRAINAGE AS-BUILTS PLAN
HILLDALE CROSSING PHASE 2
A SUBDIVISION IN SALINE COUNTY, ARKANSAS

DATE: 12/20/2022			C.A.D. BY: B.JOHNSON		DRAWING NUMBER: 20-0169		
REVISED:			CHECKED BY:				
			SCALE: 1"=50'				
500	01S	14W	0	03	330	62	1762

K:\LAND PROJECTS 2004\SUBDIVISIONS\2020\20-0169 HILLDALE CROSSING\PHASE 2\20-0169 HILLDALE CROSSING PHASE 2-AS-BUILTS-11-29-2022.DWG