
811 Know what's below. Call before you dig.

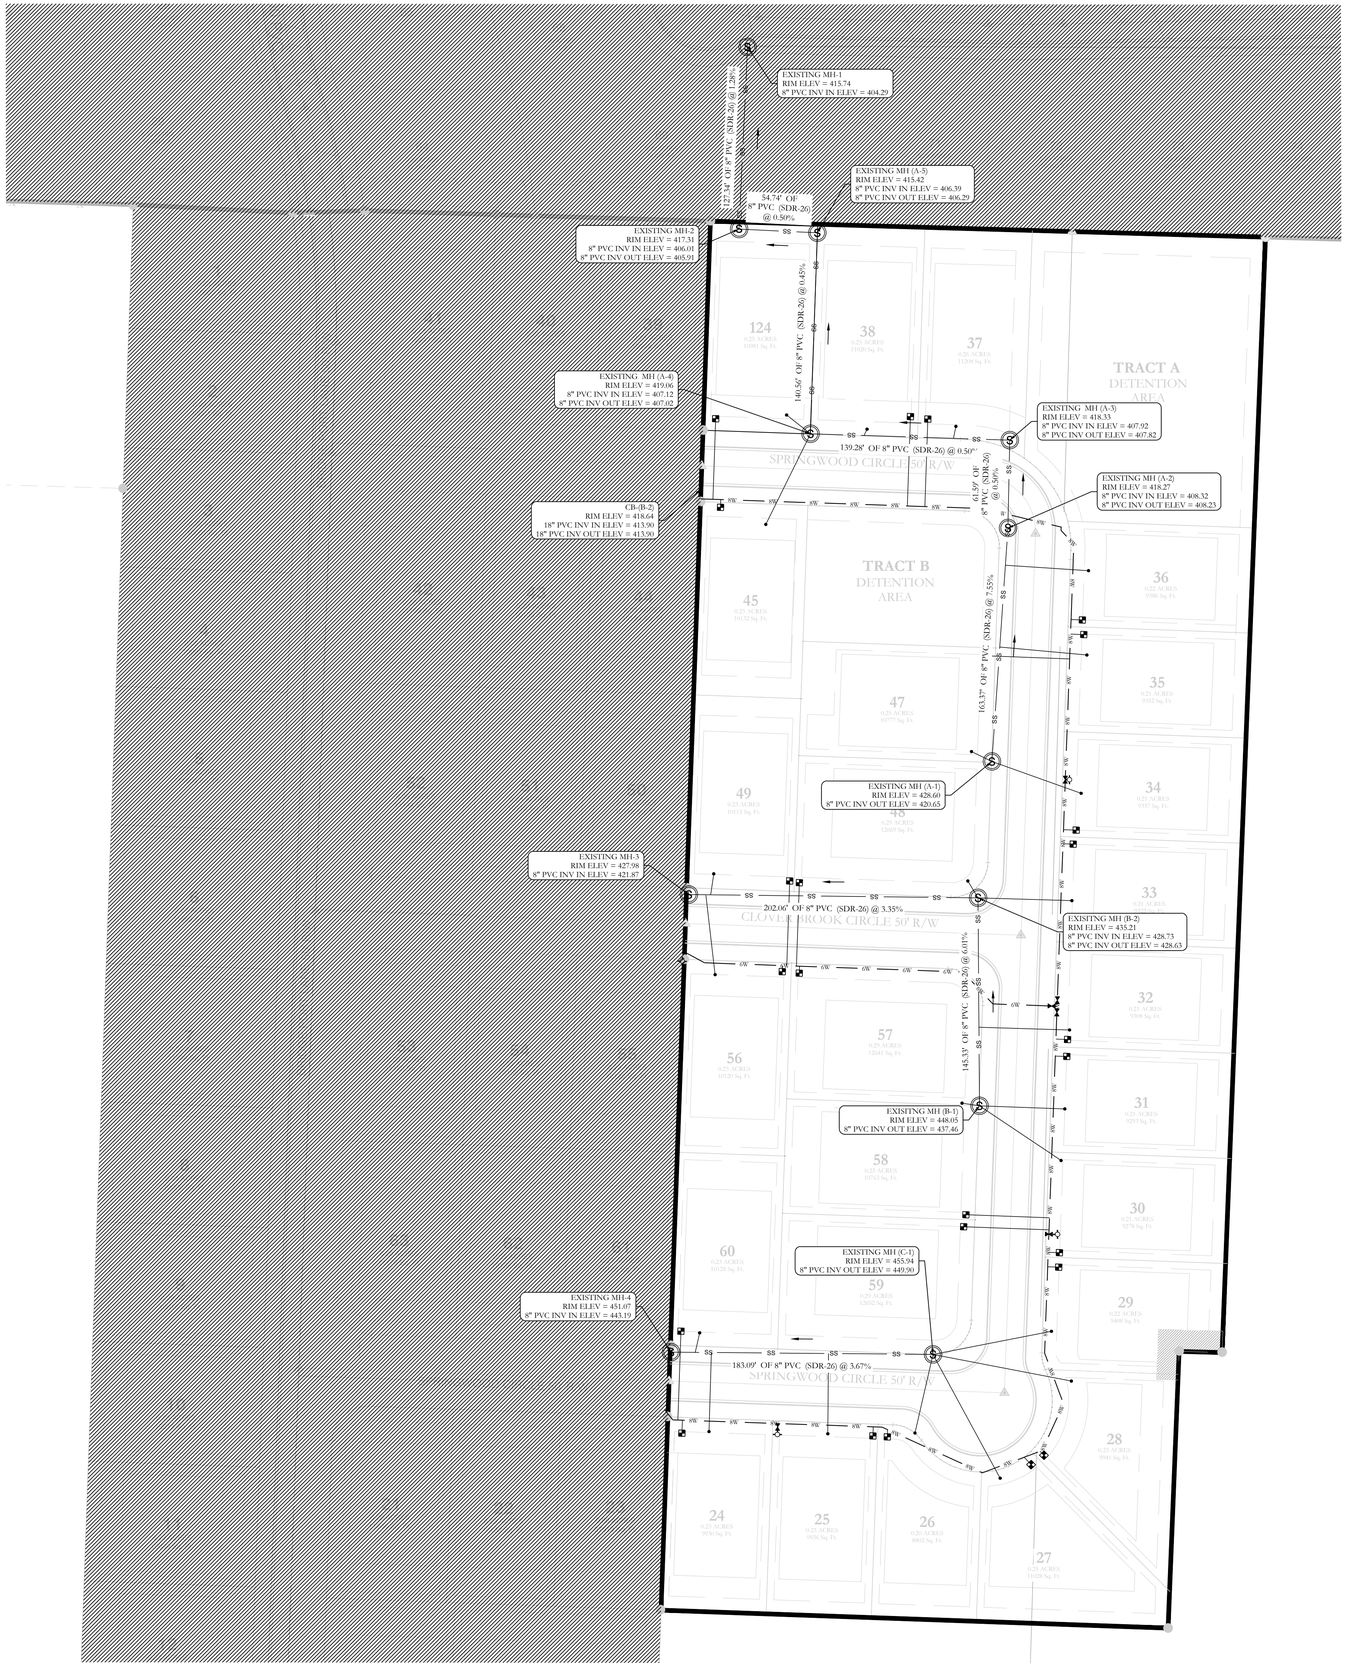

SEWER CONSTRUCTION NOTES:

1. ALL SEWER INSTALLATION TO BE IN ACCORDANCE WITH THE CITY OF BRYANT " STANDARD SPECIFICATIONS FOR DESIGN AND CONSTRUCTION OF WATER LINES AND SEWER LINES, 2015 EDITION"
2. ALL SEWER LINES CROSSING UNDER ALL CONCRETE STORM DRAINS OR ANY STORM DRAIN 30-INCH DIAMETER AND LARGER, OR ALL STORM DRAINS WITH MULTIPLE PIPE RUNS, SHALL BE STEEL ENCASED A MINIMUM OF 5 FEET EITHER SIDE OF THE STORM DRAIN.
3. FORCE MAIN WILL BE TESTED IN ACCORDANCE WITH BRYANT WATER/WASTEWATER SPECIFICATION SECTION 5200-1.03.A.4
4. SANITARY SEWER FORCE MAIN SHALL BE INSTALLED IN ACCORDANCE WITH BRYANT WATER/WASTEWATER SPECIFICATIONS.
5. CONNECTING MANHOLE FROM FORCE MAIN SHALL BE REQUIRED TO BE COATED WITH AN EPOXY COATING ACCORDANCE WITH BRYANT WATER/WASTEWATER SPECIFICATION SECTION 1200-1.07A.1.I

WATER UTILITY NOTES:

ALL NEW 8-INCH AND 6-INCH WATER MAINS TO BE C900 DR 14 PVC

ALL WATER AND SEWER INSTALLATION TO BE IN ACCORDANCE WITH THE CITY OF BRYANT "STANDARD SPECIFICATIONS FOR DESIGN AND CONSTRUCTION OF WATER LINES AND SEWER LINES, 2015 EDITION"


WATER LINES UNDER CULVERTS, CREEKS, CONCRETE CHANNELS, RETAINING WALLS, OR OTHER DIFFICULT AND/OR DANGEROUS TO MAINTAIN AREAS SHALL BE ENCASED IN A SMOOTH STEEL ENCASEMENT PIPE. THE STEEL ENCASEMENT SHALL EXTEND FIVE FEET EITHER SIDE OF THE AREA.

EACH WATER SERVICE METER MUST HAVE ITS OWN SERVICE LINE CONNECTION TO THE MAIN (INCLUDES DOUBLE METERS DISPLAYED AS ONE SERVICE LINE ON THE PLAN).

THE SEWER/WATER MAIN CROSSINGS THAT REQUIRE ENCASEMENT REQUIRE TEN (10) LINEAR FEET OF PIPE ON EITHER SIDE OF THE CROSSING.

ADH RULES PERTAINING TO PUBLIC WATER SYSTEMS NOTES REGARDING CROSS-CONNECTIONS AND SEPARATIONS OF WATER AND SEWER- WATER AND SEWER WILL BE 10 FEET APART IN PARALLEL AND IN THE CASE OF WATER CROSSING SEWER WATER LINE SHOULD BE MINIMUM 18" ABOVE SEWER LINE. AT THE EVENT OF WATER CROSSING BELOW SWER EITHER ONE OF THE PIPE WILL NEED TO BE ENCASED.

SEWER LEGEND:

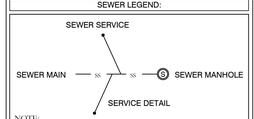

NOTE:
USE SDR-26 PVC SEWER PIPE EXCEPT WHERE DUCTILE IRON PIPE REQUIRED FOR COVER. USE DUCTILE IRON PIPE WHERE 3' MINIMUM COVE CANNOT BE MAINTAINED.
CONTRACTOR IS RESPONSIBLE FOR LOCATING ALL BURIED UTILITIES PRIOR TO CONSTRUCTION.

STATE OF ARKANSAS
LICENSED PROFESSIONAL ENGINEER
No. 20876
KAZI TAMZIDUL ISLAM

WATER LEGEND:

- DUAL WATER METERS
- SINGLE WATER METER
- GATE VALVE
- 45º FITTING
- 90º FITTING
- TEE FITTING
- CROSS FITTING
- FIRE HYDRANT

HOPE CONSULTING
ENGINEERS - SURVEYORS
129 N. Main Street,
Benton, Arkansas 72015
PH. (501)315-2626
FAX (501) 315-0024
www.hopeconsulting.com

FOR USE AND BENEFIT OF:
CYPRESS VALLEY

WATER & SEWER ASBUILTS
CYPRESS VALLY, PHASE 2
A SUBDIVISION IN THE CITY OF BRYANT, SALINE COUNTY, ARKANSAS

DATE: 04/18/2023	C.A.D. BY: JPP	DRAWING NUMBER:	
REVISED:	CHECKED BY:	21-0421	
SHEET:	SCALE: 1"= 50'		

500	01S	14W	0	10	300	62	1762

C:\Users\Jpp\Documents\21-0421 Cypress Valley Phase 2 21-0421 Cypress Valley Phase 2_R23.rvt 4/18/2023 2:53:52 PM