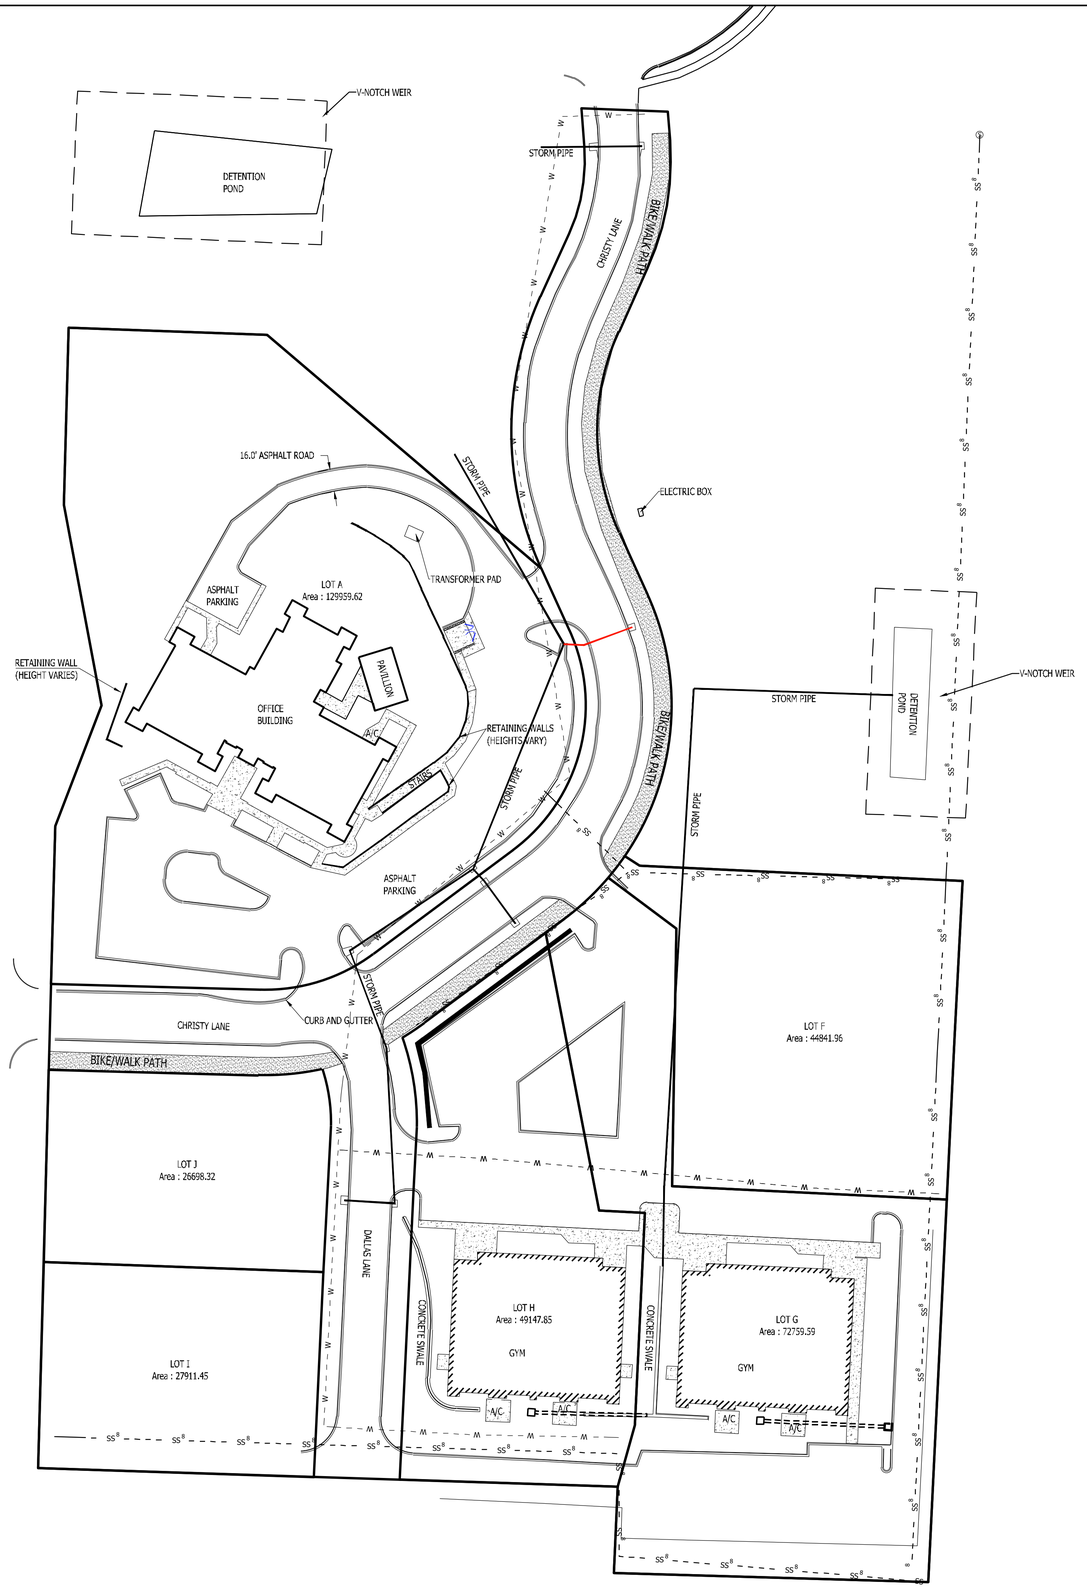


DATE	REVISIONS

VERNIA PARK SUBDIVISION PHASE 1
HENRY AVE. & BRYANT PARKWAY
BRYANT, SALINE COUNTY, ARKANSAS 72019

AS-BUILT

ROBBINS PROFESSIONAL LAND SERVICES
LAND SURVEYING
SURVEYING | GIS | CONSTRUCTION STAKING
P.O. BOX 509 | BRYANT, ARKANSAS 72089
OFFICE: 501.425.5161 | EMAIL: ZACH@ROBBINSSURVEY.COM

DRAWN BY	ZR
CHECKED BY	ZR
DATE	05-05-2023
SCALE	1"=50'
PROJECT No.	2021180
SHEET	--
PAGE	1 of 1