
811 Know what's below. Call before you dig.

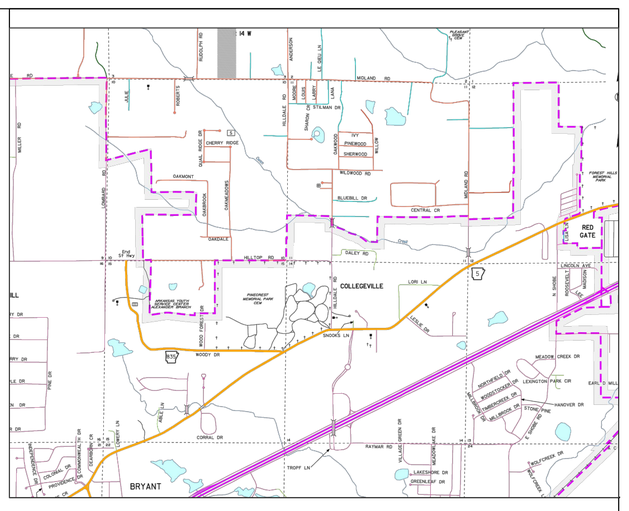

BOSSHART MARGARET
ALANA S & KIMBERLY C
SALINE COUNTY
TAX PARCEL #001-03406-000

"LOT 59 RESERVED FOR TEMPORARY EMERGENCY VEHICLE ACCESS FROM RUDOLPH LANE UNTIL ONE STUB STREET OPENS TO A PUBLIC ACCESS STREET"

NORTH HAVEN SUBDIVISION

WINDFLOWER COVE (50' R/W)

BENTWOOD DRIVE (50' R/W)

FUTURE DEVELOPMENT

REDBERRY COURT (50' R/W)

BENTWOOD DRIVE (50' R/W)

HILLDALE CROSSING PHASE 1

TRELON COVE (50' R/W)

TUCKER GREG & MEGAN
SALINE COUNTY
TAX PARCEL #001-03404-002

MOORE REDA GALE
SALINE COUNTY
TAX PARCEL #001-03412-004

CB - (D-1) INV OUT:446.61
CB - (D-2) INV IN:445.80 INV OUT:445.24
CB - (D-3) INV OUT:433.17
CB - (D-4) INV IN:430.83 INV IN:431.80 INV OUT:430.83
CB - (D-5) INV IN:430.69 INV OUT:430.19
CB - (D-6) INV IN:430.39 INV IN:430.04 INV OUT:429.04
CB - (D-7) INV IN:432.66 INV OUT:432.66
CB - (D-8) INV IN:435.00 INV IN:434.85 INV OUT:434.85
CB - (D-9) INV OUT:435.50
CB - (D-10) INV IN:443.50 INV IN:443.05 INV OUT:443.05
CB - (D-11) INV OUT:444.00
CB - (C-1) INV OUT:441.14
CB - (C-2) INV IN:440.55 INV IN:440.58 INV OUT:440.42
CB - (C-3) INV OUT:440.15
CB - (C-4) INV IN:429.41 INV IN:429.50 INV OUT:429.41
CB - (C-6) INV IN:424.55 INV OUT:424.05
CB - (B-1) INV IN:429.83 INV OUT:429.83
CB - (B-2) INV IN:429.72 INV IN:429.10 INV OUT:429.06
CB - (B-3) INV OUT:429.60
CB - (B-4) INV IN:418.42 INV IN:419.00 INV OUT:418.42
CB - (B-6) INV IN:415.90 INV IN:416.70 INV OUT:415.90
CB - (B-7) INV OUT:417.30
CB - (B-8) INV IN:413.36 INV OUT:412.86
CB - (B-9) INV OUT:419.75

293' OF 18" HDPE @ 4.91%
31' OF 18" RCP @ 4.25%
111' OF 36" HDPE @ 0.56%
28' OF 18" HDPE @ 0.50%
30' OF 24" RCP @ 0.50%
141' OF 18" HDPE @ 1.91%
253' OF 18" HDPE @ 3.24%
31' OF 18" RCP @ 1.59%
68' OF 18" RCP @ 2.47%
123' OF 18" HDPE @ 8.76%
90' OF 18" RCP @ 0.86%
31' OF 18" RCP @ 1.84%
31' OF 18" RCP @ 1.60%
105' OF 18" RCP @ 4.63%
270' OF 18" HDPE @ 4.07%
30' OF 18" RCP @ 1.31%
49' OF 18" RCP @ 1.15%
107' OF 24" HDPE @ 1.29%
35' OF 18" RCP @ 1.43%
236' OF 30" HDPE @ 4.50%
32' OF 18" RCP @ 1.55%
93' OF 30" HDPE @ 0.73%
116' OF 30" RCP @ 0.09%
63' OF 30" HDPE @ 4.01%
34' OF 18" RCP @ 1.77%
156' OF 30" HDPE @ 1.63%
143' OF 8" SDR-26 PVC @ 1.64%
68' OF 18" RCP @ 0.69%

40 0.24 ACRES 10266 Sq. Ft.
41 0.14 ACRES 6050 Sq. Ft.
42 0.14 ACRES 6000 Sq. Ft.
43 0.14 ACRES 6000 Sq. Ft.
44 0.14 ACRES 6000 Sq. Ft.
45 0.16 ACRES
38 0.23 ACRES 10192 Sq. Ft.
37 0.14 ACRES 6057 Sq. Ft.
35 0.14 ACRES 6000 Sq. Ft.
34 0.14 ACRES 6000 Sq. Ft.
6865 Sq. Ft.
32 0.14 ACRES 6000 Sq. Ft.
31 0.15 ACRES 6467 Sq. Ft.
26 0.20 ACRES 8613 Sq. Ft.
27 0.15 ACRES 6565 Sq. Ft.
28 0.14 ACRES 6000 Sq. Ft.
29 0.14 ACRES 6000 Sq. Ft.
30 0.14 ACRES 6000 Sq. Ft.
25 0.17 ACRES 7209 Sq. Ft.
24 0.15 ACRES 6370 Sq. Ft.
23 0.15 ACRES 6433 Sq. Ft.
22 0.15 ACRES 6424 Sq. Ft.
96 0.14 ACRES 6000 Sq. Ft.
97 0.14 ACRES 6000 Sq. Ft.
95 0.14 ACRES 6000 Sq. Ft.
94 0.14 ACRES 6000 Sq. Ft.
93 0.14 ACRES 6000 Sq. Ft.
92 0.14 ACRES 6288 Sq. Ft.
91 0.19 ACRES 8274 Sq. Ft.
85 0.14 ACRES 6047 Sq. Ft.
86 0.14 ACRES 6077 Sq. Ft.
87 0.14 ACRES 6106 Sq. Ft.
88 0.14 ACRES 6136 Sq. Ft.
89 0.14 ACRES 6023 Sq. Ft.
90 0.16 ACRES 7138 Sq. Ft.

S2°05'10"W 100.00'
N2°05'10"E 600'
S88°03'23"E 100.00'
N2°05'10"E 600.00'
S2°05'10"W 100.00'
S1°56'57"W 60.00'

BASIS OF BEARINGS: GRID NORTH ARKANSAS COORDINATE SYSTEM, SOUTH ZONE BY G.P.S. OBSERVATIONS

50' 25' 0 50'
BAR SCALE: 1" = 60'

DRAINAGE AS-BUILTS
HILLDALE CROSSING PHASE 2
A SUBDIVISION IN SALINE COUNTY, ARKANSAS

CERTIFICATE OF AUTHORIZATION
HOPE CONSULTING, INC.
No. 1931
ARKANSAS

HOPE CONSULTING
ENGINEERS - SURVEYORS
117 S. Market Street,
Benton, Arkansas 72015
PH. (501)315-2626
FAX (501) 315-0024
www.hopeconsulting.com

FOR USE AND BENEFIT OF:
HAVENS DEVELOPMENT, LLC

DRAINAGE AS-BUILTS PLAN
HILLDALE CROSSING PHASE 2
A SUBDIVISION IN SALINE COUNTY, ARKANSAS

DATE: 05/10/2023			C.A.D. BY: B.JOHNSON			DRAWING NUMBER: 20-0169	
REVISED:			CHECKED BY:				
			SCALE: 1"=50'				
500	01S	14W	0	03	330	62	1762

K:\LAND PROJECTS 2004\SUBDIVISIONS\2020\20-0169 HILLDALE CROSSING\PHASE 2\20-0169 HILLDALE CROSSING PHASE 2-AS-BUILTS-11-29-2022.DWG