
811 Know what's below. Call before you dig.

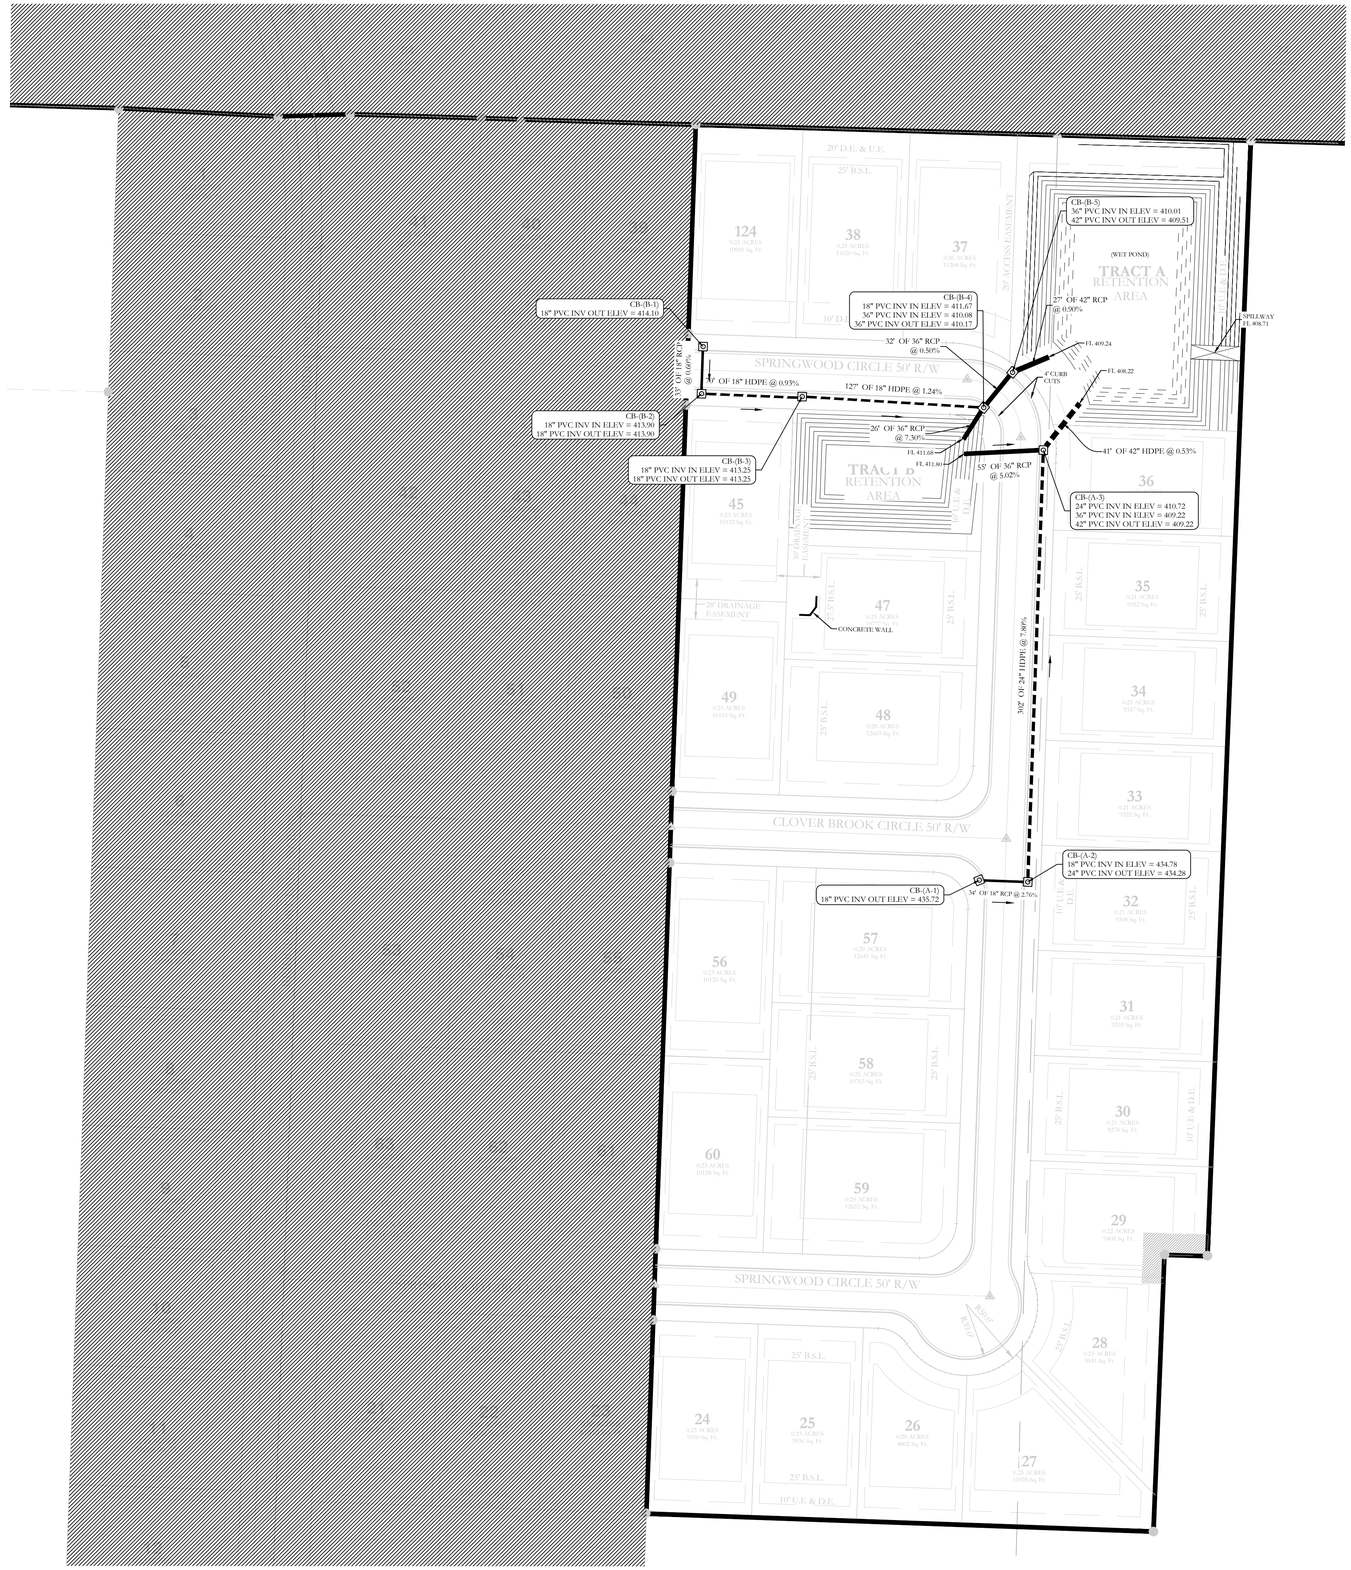

HOPE CONSULTING
ENGINEERS - SURVEYORS

129 N. Main Street,
Benton, Arkansas 72015
PH. (501)315-2626
FAX (501) 315-0024
www.hopeconsulting.com

FOR USE AND BENEFIT OF:
CYPRESS VALLEY

DRAINAGE AS-BUILTS
CYPRESS VALLY, PHASE 2
A SUBDIVISION IN THE CITY OF BRYANT, SALINE COUNTY, ARKANSAS

DATE: 05/10/2023	C.A.D. BY:		DRAWING NUMBER:
REVISED:	CHECKED BY:		21-0421
SHEET:	SCALE: 1"= 50'		

500	01S	14W	0	10	300	62	1762

C:\Users\Jay Hope\Documents\21-0421 Cypress Valley Phase 2\21-0421 Cypress Valley Phase 2 Drainage As-Built.dwg, 8.5x11