
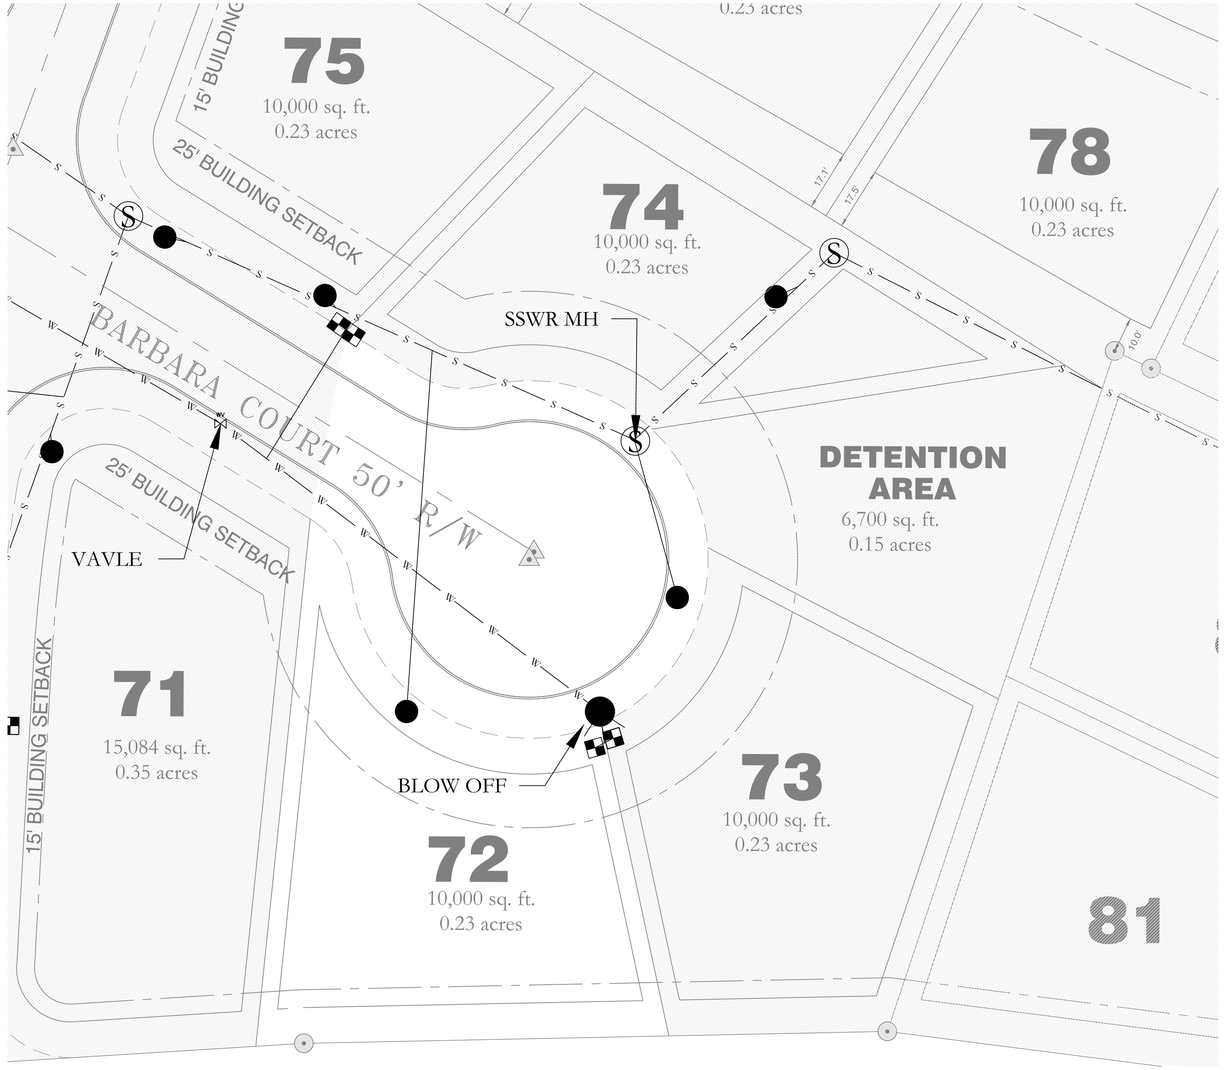


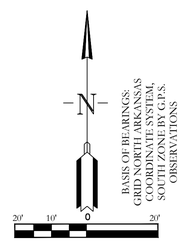

HOPE CONSULTING
ENGINEERS - SURVEYORS
117 S. Market Street,
Benton, Arkansas 72015
PH. (501)315-2626
FAX (501) 315-0024
www.hopeconsulting.com

FOR USE AND BENEFIT OF:
TED VAN TASSEL

WATER/SEWER AS-BUILTS
Lot 72 MEADOW RIDGE PHASE 4
A SUBDIVISION IN THE CITY OF BRYANT,
SALINE COUNTY, ARKANSAS

DATE:	06-19-2023	C.A.D. BY:	DRAWING NUMBER:
REVISED:		CHECKED BY:	18-0440
SHEET:	C-1.0	SCALE:	

500 | S

K:\LAND PROJECTS 2004\SUBDIVISIONS\2018\18-0440 MEADOW RIDGE LOTS 72-74 PHASE 4 AS BUILTS\VOID\18-0440_PHASE 4 AS BUILTS.DWG