
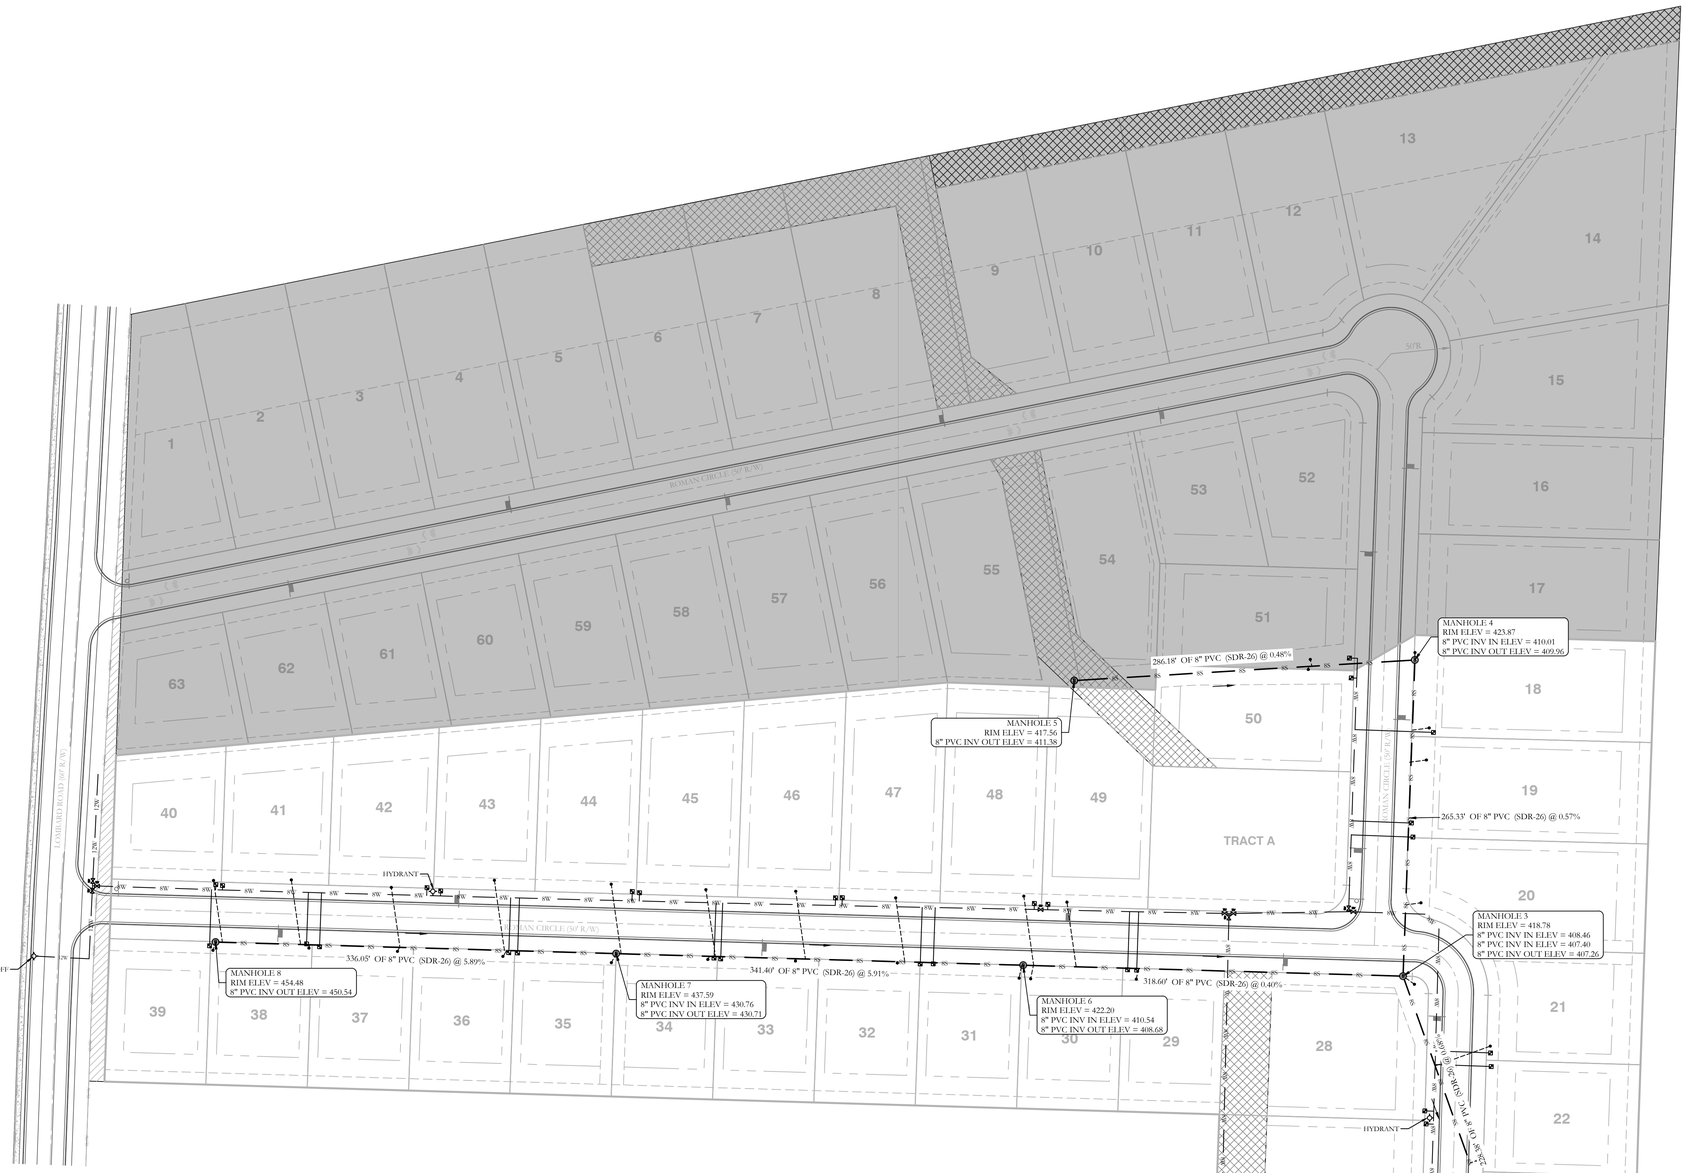


SANITARY SEWER AND WATER AS-BUILTS
ROMAN HEIGHTS SUBDIVISION PHASE 1

IN THE CITY OF BRYANT, SALINE COUNTY, ARKANSAS

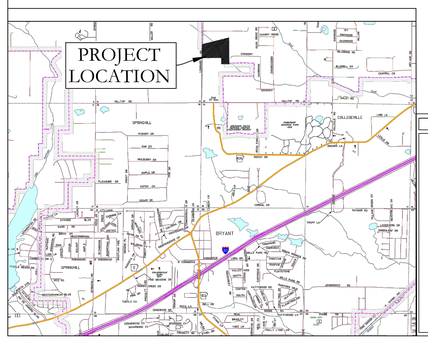

SEWER LEGEND:	WATER LEGEND:	TYPICAL FIRE HYDRANT:
AIR RELEASE VALVE	3" BLOW OFF	3" BLOW OFF
CLEAN OUT	GATE VALVE	REDUCER 6"
ISOLATION VALVE	REDUCER	6" GATE VALVE
SEWER SERVICE	WATER LINE	FIRE HYDRANT (2 TO 6 FEET FROM EDGE OF PAVEMENT)
SEWER SERVICE	FIRE HYDRANT	
	DOUBLE WATER SERVICE	
	SINGLE WATER SERVICE	

NOTE:
PROPOSED SEWER MAINS IS TO HAVE TRACER WIRE. ALSO A NON-BIODEGRADABLE TAPE IDENTIFYING THE LINE AS "SEWER" MUST BE BURIED IN THE TRENCH ABOVE THE SEWER MIANS.

NOTE:
ALL FIRE HYDRANT LEADERS HAVE A GATE VALVE BETWEEN MAIN AND FIRE HYDRANT.

CERTIFICATE OF AUTHORIZATION
HOPE CONSULTING, INC.
No. 1931
ARKANSAS

STATE OF ARKANSAS
REGISTERED PROFESSIONAL ENGINEER
WILLIAM W. McFADDEN
NO. 14048

BASIS OF BEARINGS:
GRID NORTH ARKANSAS COORDINATE SYSTEM, SOUTH ZONE BY G.P.S. OBSERVATIONS

60' 30' 0 60'
BAR SCALE: 1" = 60'

HOPE CONSULTING
ENGINEERS - SURVEYORS
117 S. Market Street,
Benton, Arkansas 72015
PH. (501)315-2626
FAX (501) 315-0024
www.hopeconsulting.com

FOR USE AND BENEFIT OF:
BULL DEVELOPMENT LLC

WATER & SEWER AS-BUILTS PLAN
ROMAN HEIGHTS SUBDIVISION PHASE 1
IN THE CITY OF BRYANT, SALINE COUNTY, ARKANSAS

DATE:	10/06/2021		C.A.D. BY:	JPP		DRAWING NUMBER:	
REVISED:			CHECKED BY:			17-0077	
			SCALE: 1"=60'				
500	01S	14W	0	10	300	62	1762

K:\LAND PROJECTS 2004\SUBDIVISIONS\2017\17-0077 ROMAN HEIGHTS\DWG\17-0077 ROMAN HEIGHTS AS-BUILTS 05-10-2021.DWG