

811 Know what's below. Call before you dig.

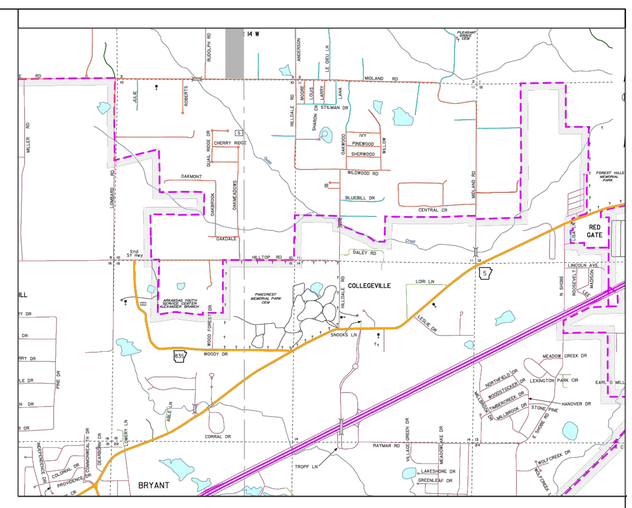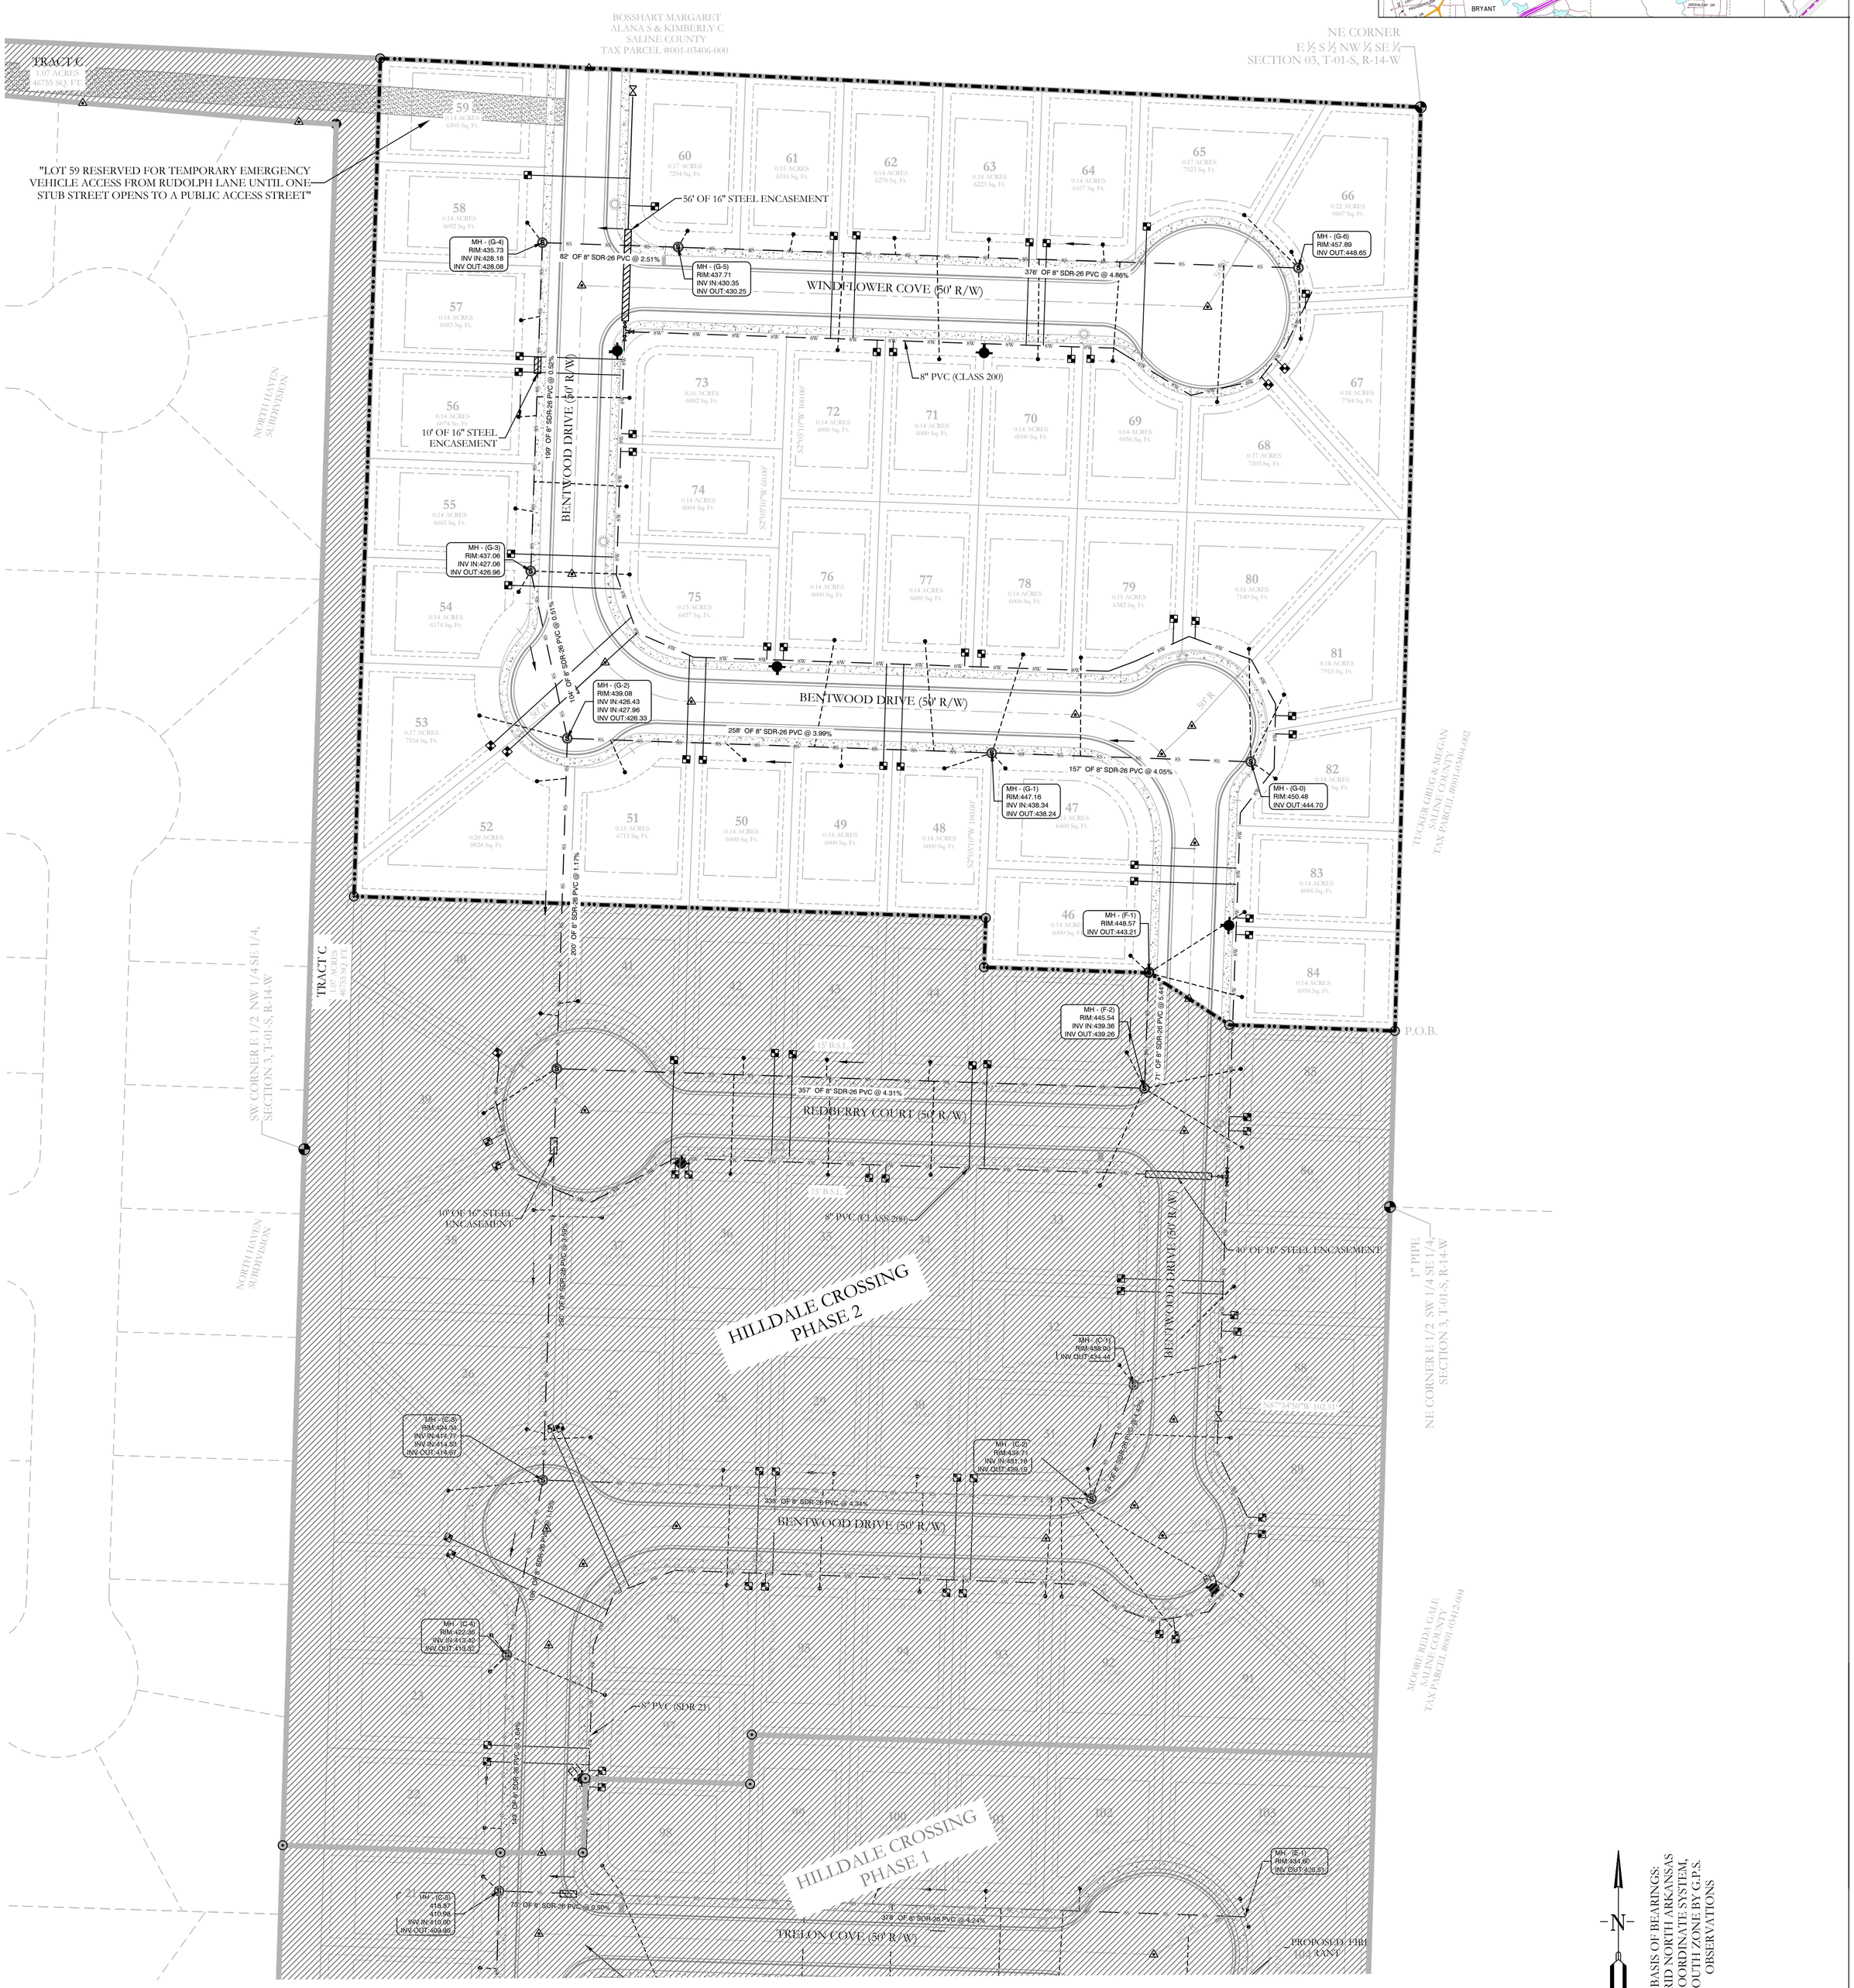


# SANITARY SEWER AND WATER AS-BUILTS
# HILLDALE CROSSING PHASE 2
## A SUBDIVISION IN SALINE COUNTY, ARKANSAS

| SEWER LEGEND: | WATER LEGEND: | TYPICAL FIRE HYDRANT: |
|---|---|---|
| AIR RELEASE VALVE | 3" BLOW OFF | 3" BLOW OFF |
| CLEAN OUT | GATE VALVE | REDUCER 8" |
| ISOLATION VALVE | REDUCER | 8" GATE VALVE |
| SEWER SERVICE | WATER LINE | FIRE HYDRANT |
| SEWER SERVICE | FIRE HYDRANT | |
| | DOUBLE WATER SERVICE | |
| | SINGLE WATER SERVICE | |

NOTE: PROPOSED SEWER MAINS IS TO HAVE TRACER WIRE. ALSO A NON-BIODEGRADABLE TAPE IDENTIFYING THE LINE AS "SEWER" MUST BE PLACED IN THE TRENCH ABOVE THE SEWER MIANS.

NOTE: ALL FIRE HYDRANT LEADERS HAVE A GATE VALVE BETWEEN MAIN AND FIRE HYDRANT.

CERTIFICATE OF AUTHORIZATION — HOPE CONSULTING, INC. — No. 1931 — ARKANSAS

BASIS OF BEARINGS: GRID NORTH ARKANSAS COORDINATE SYSTEM, SOUTH ZONE BY G.P.S. OBSERVATIONS

50' 25' 0 50'
BAR SCALE: 1" = 60'


HOPE CONSULTING ENGINEERS - SURVEYORS
117 S. Market Street,
Benton, Arkansas 72015
PH. (501)315-2626
FAX (501) 315-0024
www.hopeconsulting.com


FOR USE AND BENEFIT OF:
HAVENS DEVELOPMENT, LLC

WATER & SEWER AS-BUILTS PLAN
HILLDALE CROSSING PHASE 2
A SUBDIVISION IN SALINE COUNTY, ARKANSAS

| DATE: 09/27/2023 | | C.A.D. BY: B.JOHNSON | DRAWING NUMBER: 20-0169 |
|---|---|---|---|
| REVISED: | | CHECKED BY: | |
| | | SCALE: 1"=50' | |

| 500 | 01S | 14W | 0 | 03 | 330 | 62 | 1762 |
|---|---|---|---|---|---|---|---|

K:\LAND PROJECTS 2004\SUBDIVISIONS\2020\20-0169 HILLDALE CROSSING\PHASE 3\AS BUILTS-09-27-2023.DWG