


811 Know what's below. Call before you dig.

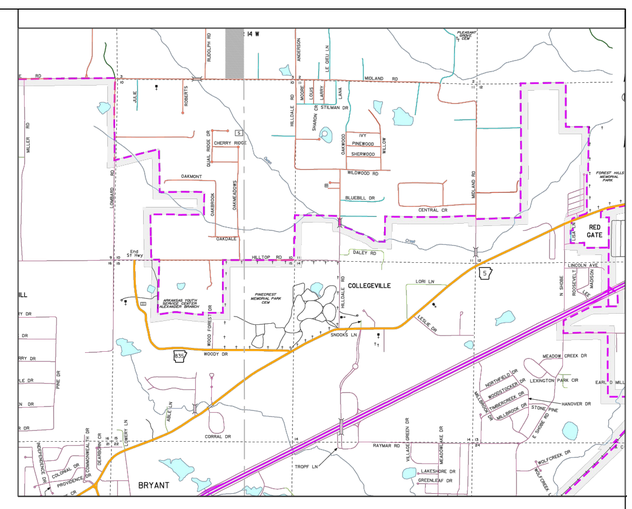

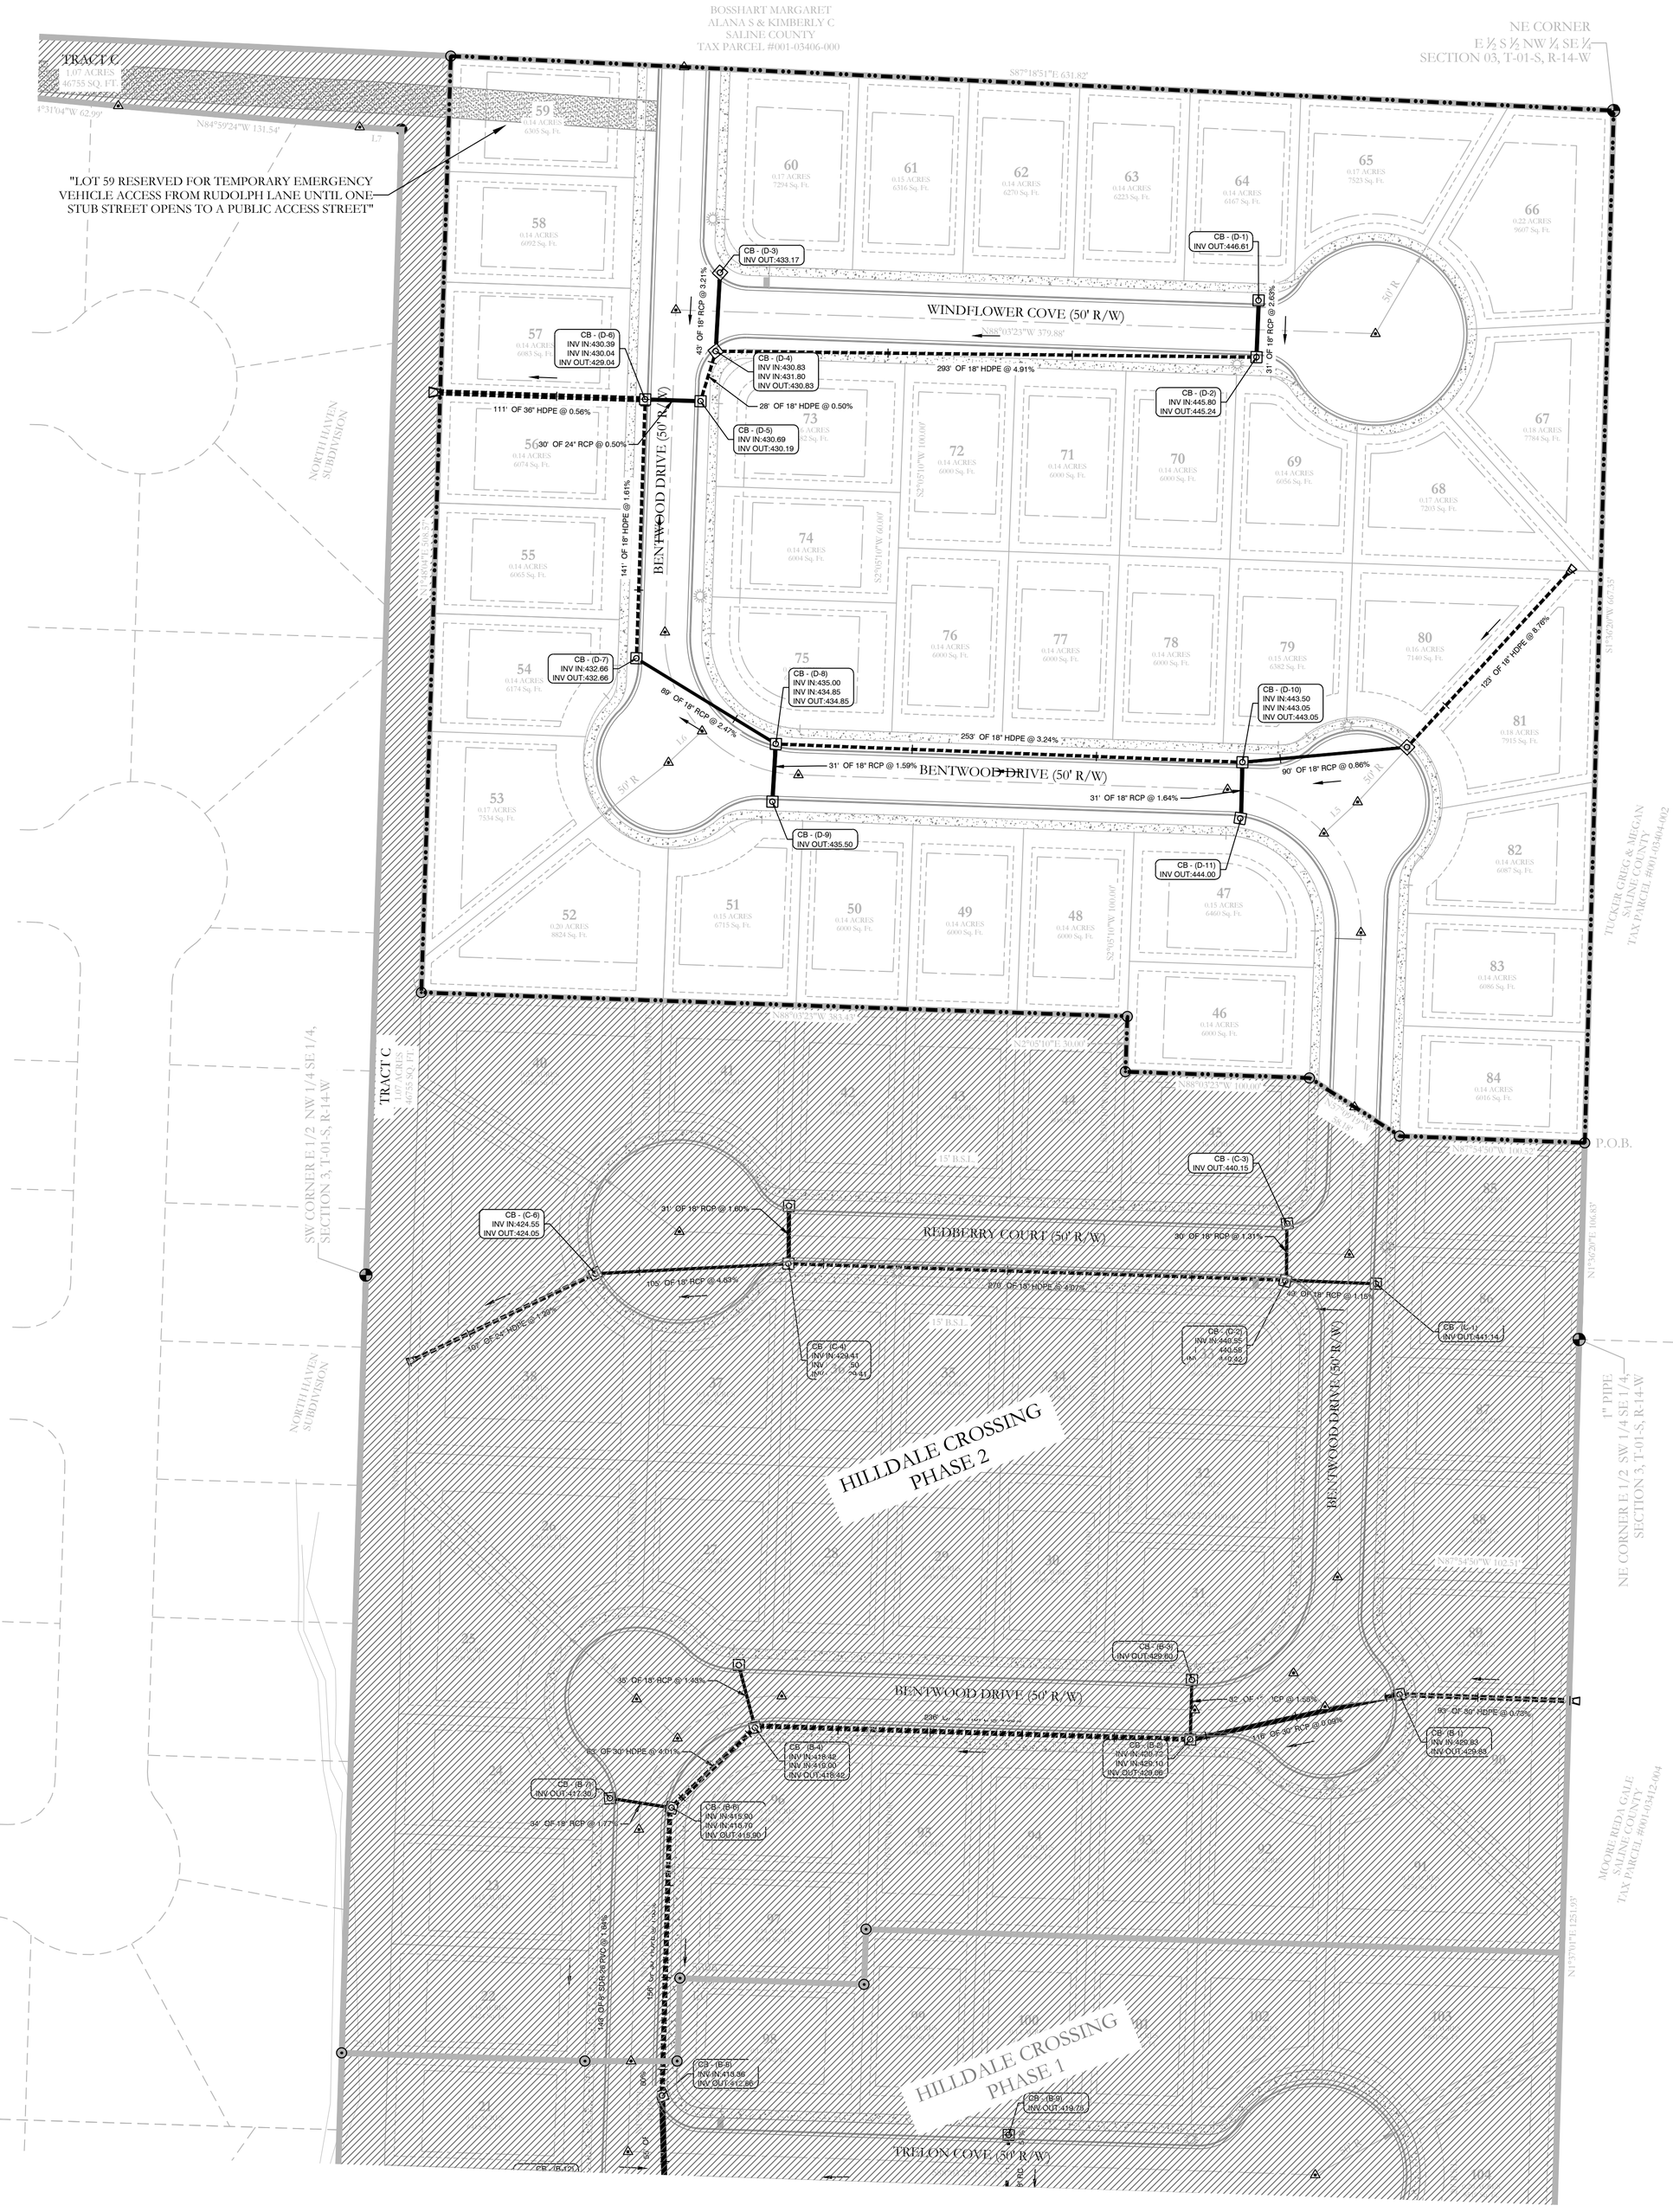

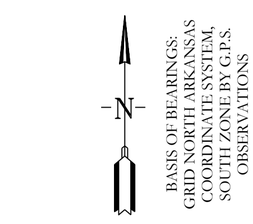

50' 25' 0 50'

BAR SCALE: 1" = 60'

DRAINAGE AS-BUILTS
HILLDALE CROSSING PHASE 2
A SUBDIVISION IN SALINE COUNTY, ARKANSAS

CERTIFICATE OF AUTHORIZATION
HOPE CONSULTING, INC.
No. 1931
ARKANSAS

HOPE CONSULTING
ENGINEERS - SURVEYORS
117 S. Market Street,
Benton, Arkansas 72015
PH. (501)315-2626
FAX (501) 315-0024
www.hopeconsulting.com

FOR USE AND BENEFIT OF:
HAVENS DEVELOPMENT, LLC

DRAINAGE AS-BUILTS PLAN
HILLDALE CROSSING PHASE 2
A SUBDIVISION IN SALINE COUNTY, ARKANSAS

DATE: 09/27/2023	C.A.D. BY: B.JOHNSON	DRAWING NUMBER: 20-0169	
REVISED:	CHECKED BY:		
	SCALE: 1"=50'		

500	01S	14W	0	03	330	62	1762

K:\LAND PROJECTS 2004\SUBDIVISIONS\2020\20-0169 HILLDALE CROSSING\PHASE 3\AS-BUILTS-09-27-2023.DWG