
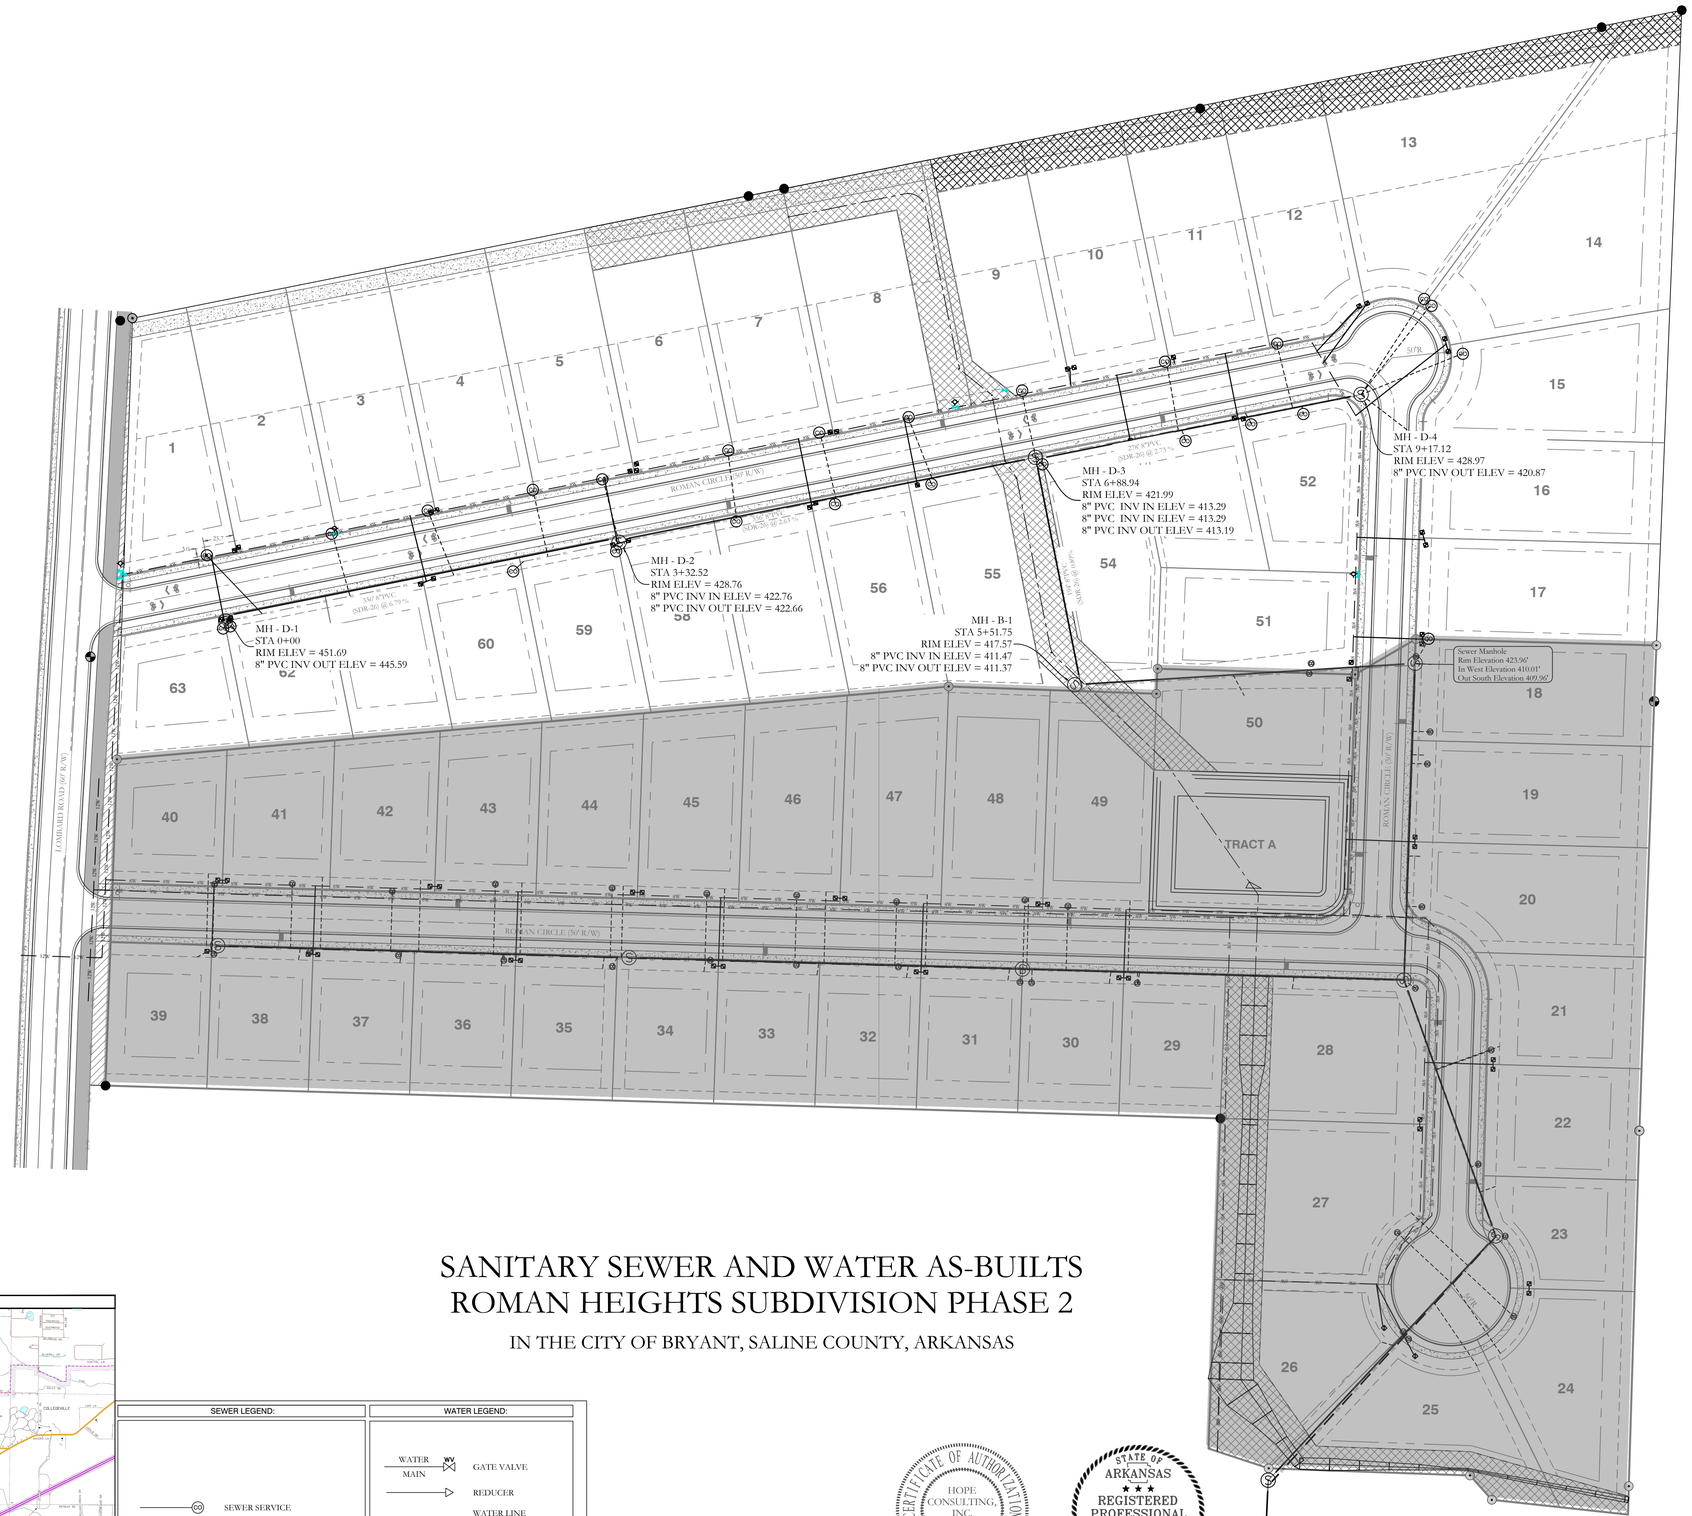



# SANITARY SEWER AND WATER AS-BUILTS
# ROMAN HEIGHTS SUBDIVISION PHASE 2

IN THE CITY OF BRYANT, SALINE COUNTY, ARKANSAS

VICINITY MAP:

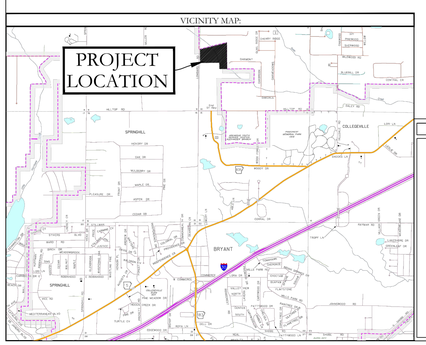


| SEWER LEGEND: | WATER LEGEND: |
|---|---|
| SEWER SERVICE | GATE VALVE |
| SEWER SERVICE | REDUCER |
| | WATER LINE |
| | FIRE HYDRANT |
| | DOUBLE WATER SERVICE |
| | SINGLE WATER SERVICE |

NOTE:
PROPOSED SEWER MAINS IS TO HAVE TRACER WIRE. ALSO A NON-BIODEGRADABLE TAPE IDENTIFYING THE LINE AS "SEWER" MUST BE BURIED IN THE TRENCH ABOVE THE SEWER MIANS.

NOTE:
ALL FIRE HYDRANT LEADERS HAVE A GATE VALVE BETWEEN MAIN AND FIRE HYDRANT.

CERTIFICATE OF AUTHORIZATION
HOPE CONSULTING, INC.
No. 1931
ARKANSAS

STATE OF ARKANSAS
REGISTERED PROFESSIONAL ENGINEER
NO. 14048
WILLIAM W. McFADDEN

BASIS OF BEARINGS:
GRID NORTH ARKANSAS COORDINATE SYSTEM, SOUTH ZONE BY G.P.S. OBSERVATIONS

60' 30' 0 60'
BAR SCALE: 1" = 60'


HOPE CONSULTING
ENGINEERS - SURVEYORS
117 S. Market Street,
Benton, Arkansas 72015
PH. (501)315-2626
FAX (501) 315-0024
www.hopeconsulting.com


FOR USE AND BENEFIT OF:
BULL DEVELOPMENT LLC

WATER & SEWER AS-BUILTS PLAN
ROMAN HEIGHTS SUBDIVISION PHASE 2
IN THE CITY OF BRYANT, SALINE COUNTY, ARKANSAS

| DATE: | 09/23/2023 | C.A.D. BY: | MD | DRAWING NUMBER: |
|---|---|---|---|---|
| REVISED: | | CHECKED BY: | | 17-0077 |
| | | SCALE: 1"=60' | | |

| 500 | 01S | 14W | 0 | 10 | 300 | 62 | 1762 |
|---|---|---|---|---|---|---|---|

K:\LAND PROJECTS 2004-08\BDN\SIDS\2017\17-0077_ROMAN HEIGHTS\DWG\17-0077_ROMAN HEIGHTS_AS-BUILTS.PKF 09-28-23.DWG