
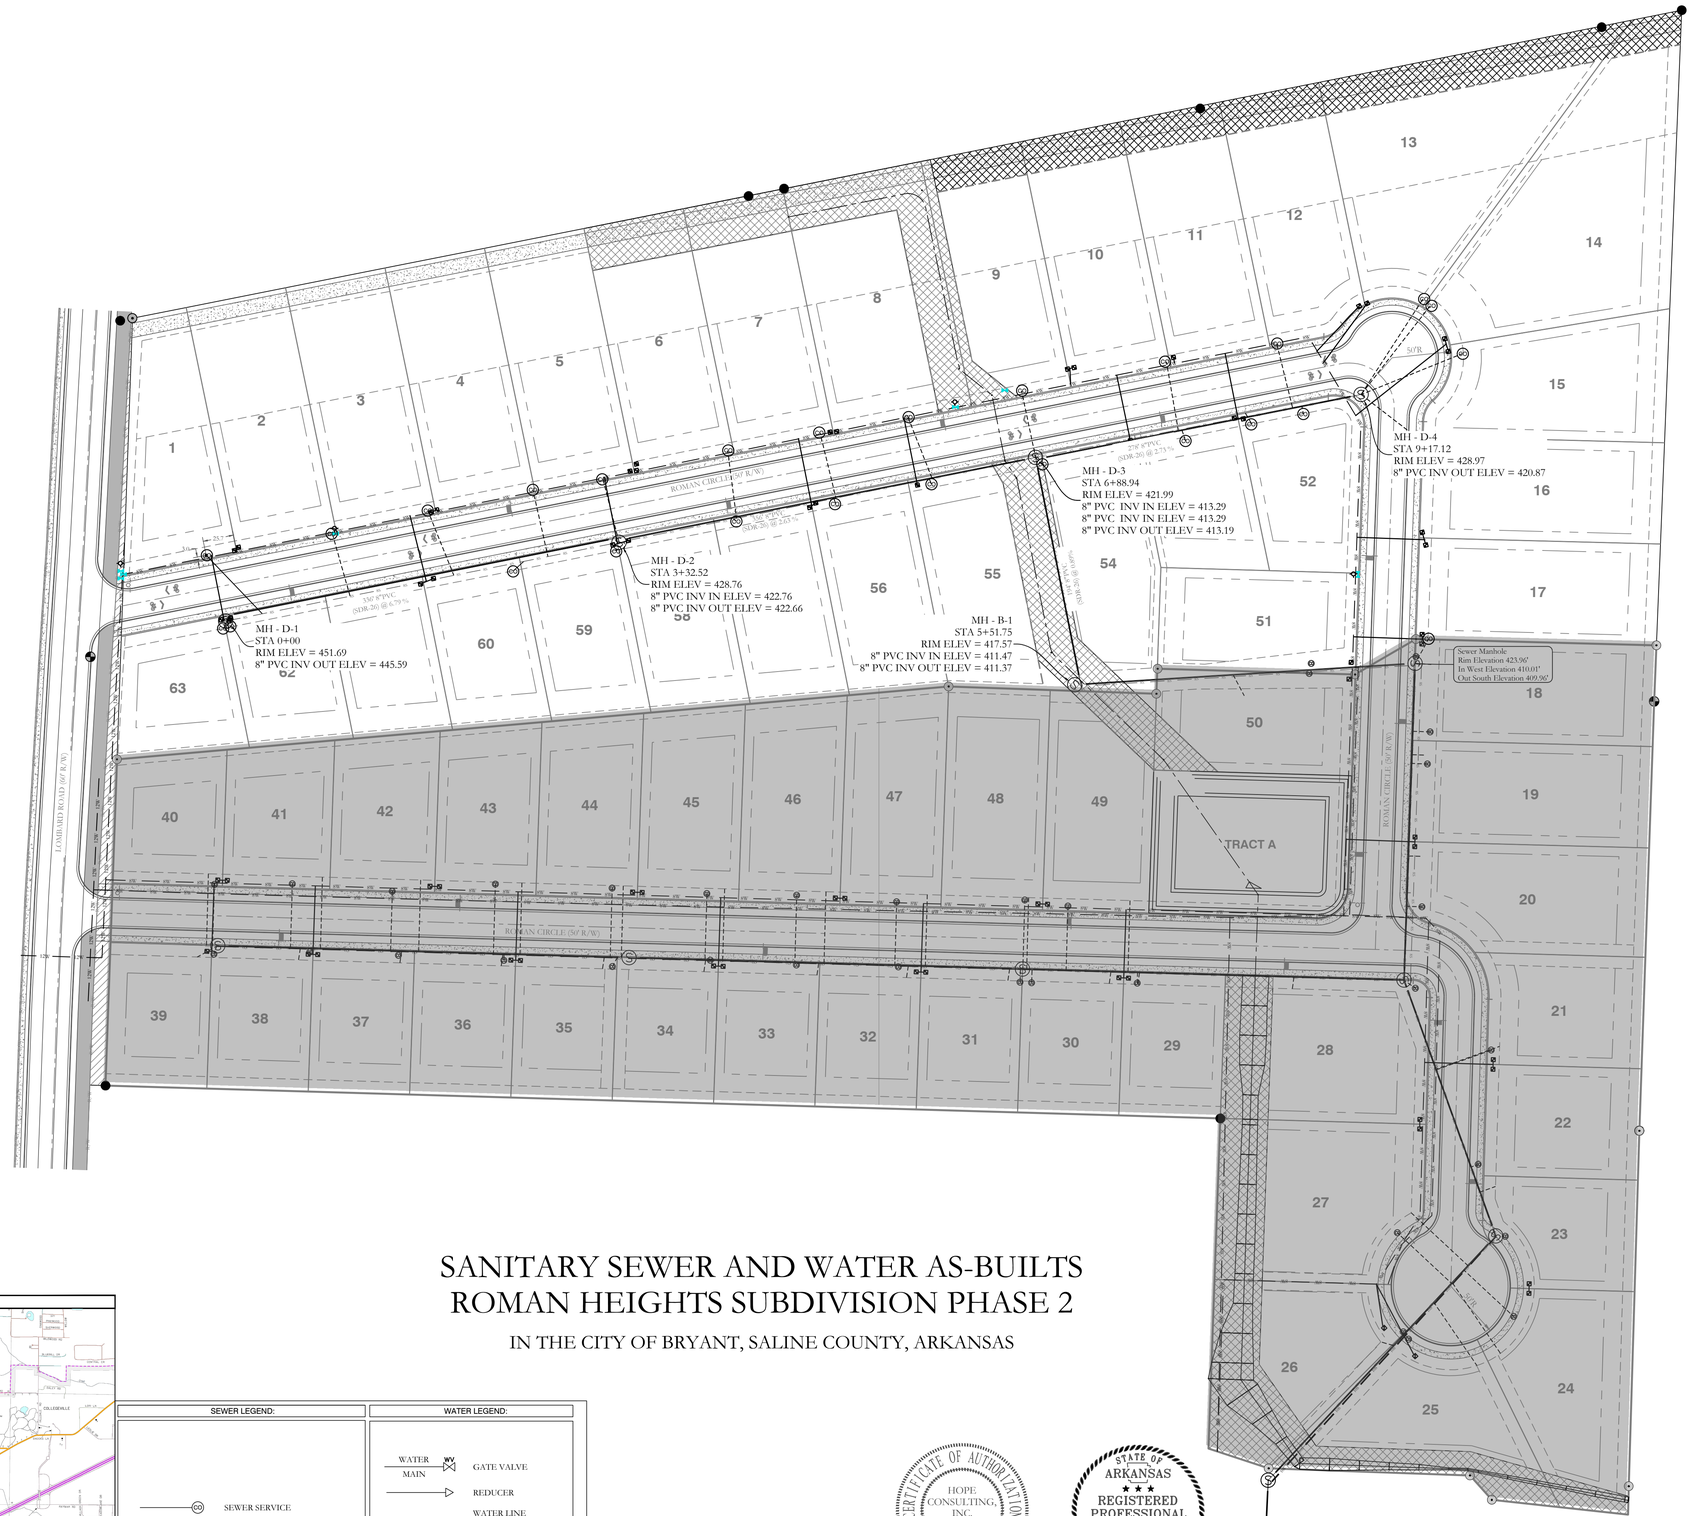


SANITARY SEWER AND WATER AS-BUILTS
ROMAN HEIGHTS SUBDIVISION PHASE 2

IN THE CITY OF BRYANT, SALINE COUNTY, ARKANSAS

VICINITY MAP:

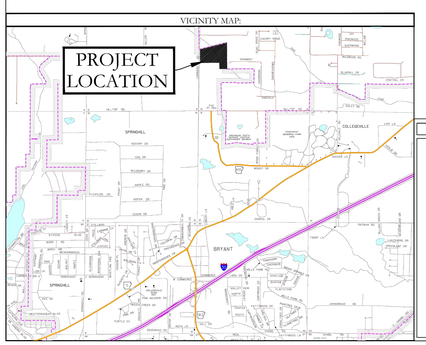

SEWER LEGEND:	WATER LEGEND:
SEWER SERVICE	GATE VALVE
SEWER SERVICE	REDUCER
	WATER LINE
	FIRE HYDRANT
	DOUBLE WATER SERVICE
	SINGLE WATER SERVICE

NOTE:
PROPOSED SEWER MAINS IS TO HAVE TRACER WIRE. ALSO A NON-BIODEGRADABLE TAPE IDENTIFYING THE LINE AS "SEWER" MUST BE BURIED IN THE TRENCH ABOVE THE SEWER MIANS.

NOTE:
ALL FIRE HYDRANT LEADERS HAVE A GATE VALVE BETWEEN MAIN AND FIRE HYDRANT.

CERTIFICATE OF AUTHORIZATION
HOPE CONSULTING, INC.
No. 1931
ARKANSAS

STATE OF ARKANSAS
REGISTERED PROFESSIONAL ENGINEER
NO. 14048
WILLIAM W. McFADDEN

BASIS OF BEARINGS:
GRID NORTH ARKANSAS COORDINATE SYSTEM, SOUTH ZONE BY G.P.S. OBSERVATIONS

60' 30' 0 60'
BAR SCALE: 1" = 60'

HOPE CONSULTING
ENGINEERS - SURVEYORS
117 S. Market Street,
Benton, Arkansas 72015
PH. (501)315-2626
FAX (501) 315-0024
www.hopeconsulting.com

FOR USE AND BENEFIT OF:
BULL DEVELOPMENT LLC

WATER & SEWER AS-BUILTS PLAN
ROMAN HEIGHTS SUBDIVISION PHASE 2
IN THE CITY OF BRYANT, SALINE COUNTY, ARKANSAS

DATE:	09/23/2023	C.A.D. BY:	MD	DRAWING NUMBER:
REVISED:		CHECKED BY:		17-0077
		SCALE: 1"=60'		

500	01S	14W	0	10	300	62	1762

K:\LAND PROJECTS 2004-08\BDN\SIDS\2017\17-0077_ROMAN HEIGHTS\DWG\17-0077_ROMAN HEIGHTS_AS-BUILTS.PKF 09-28-23.DWG