
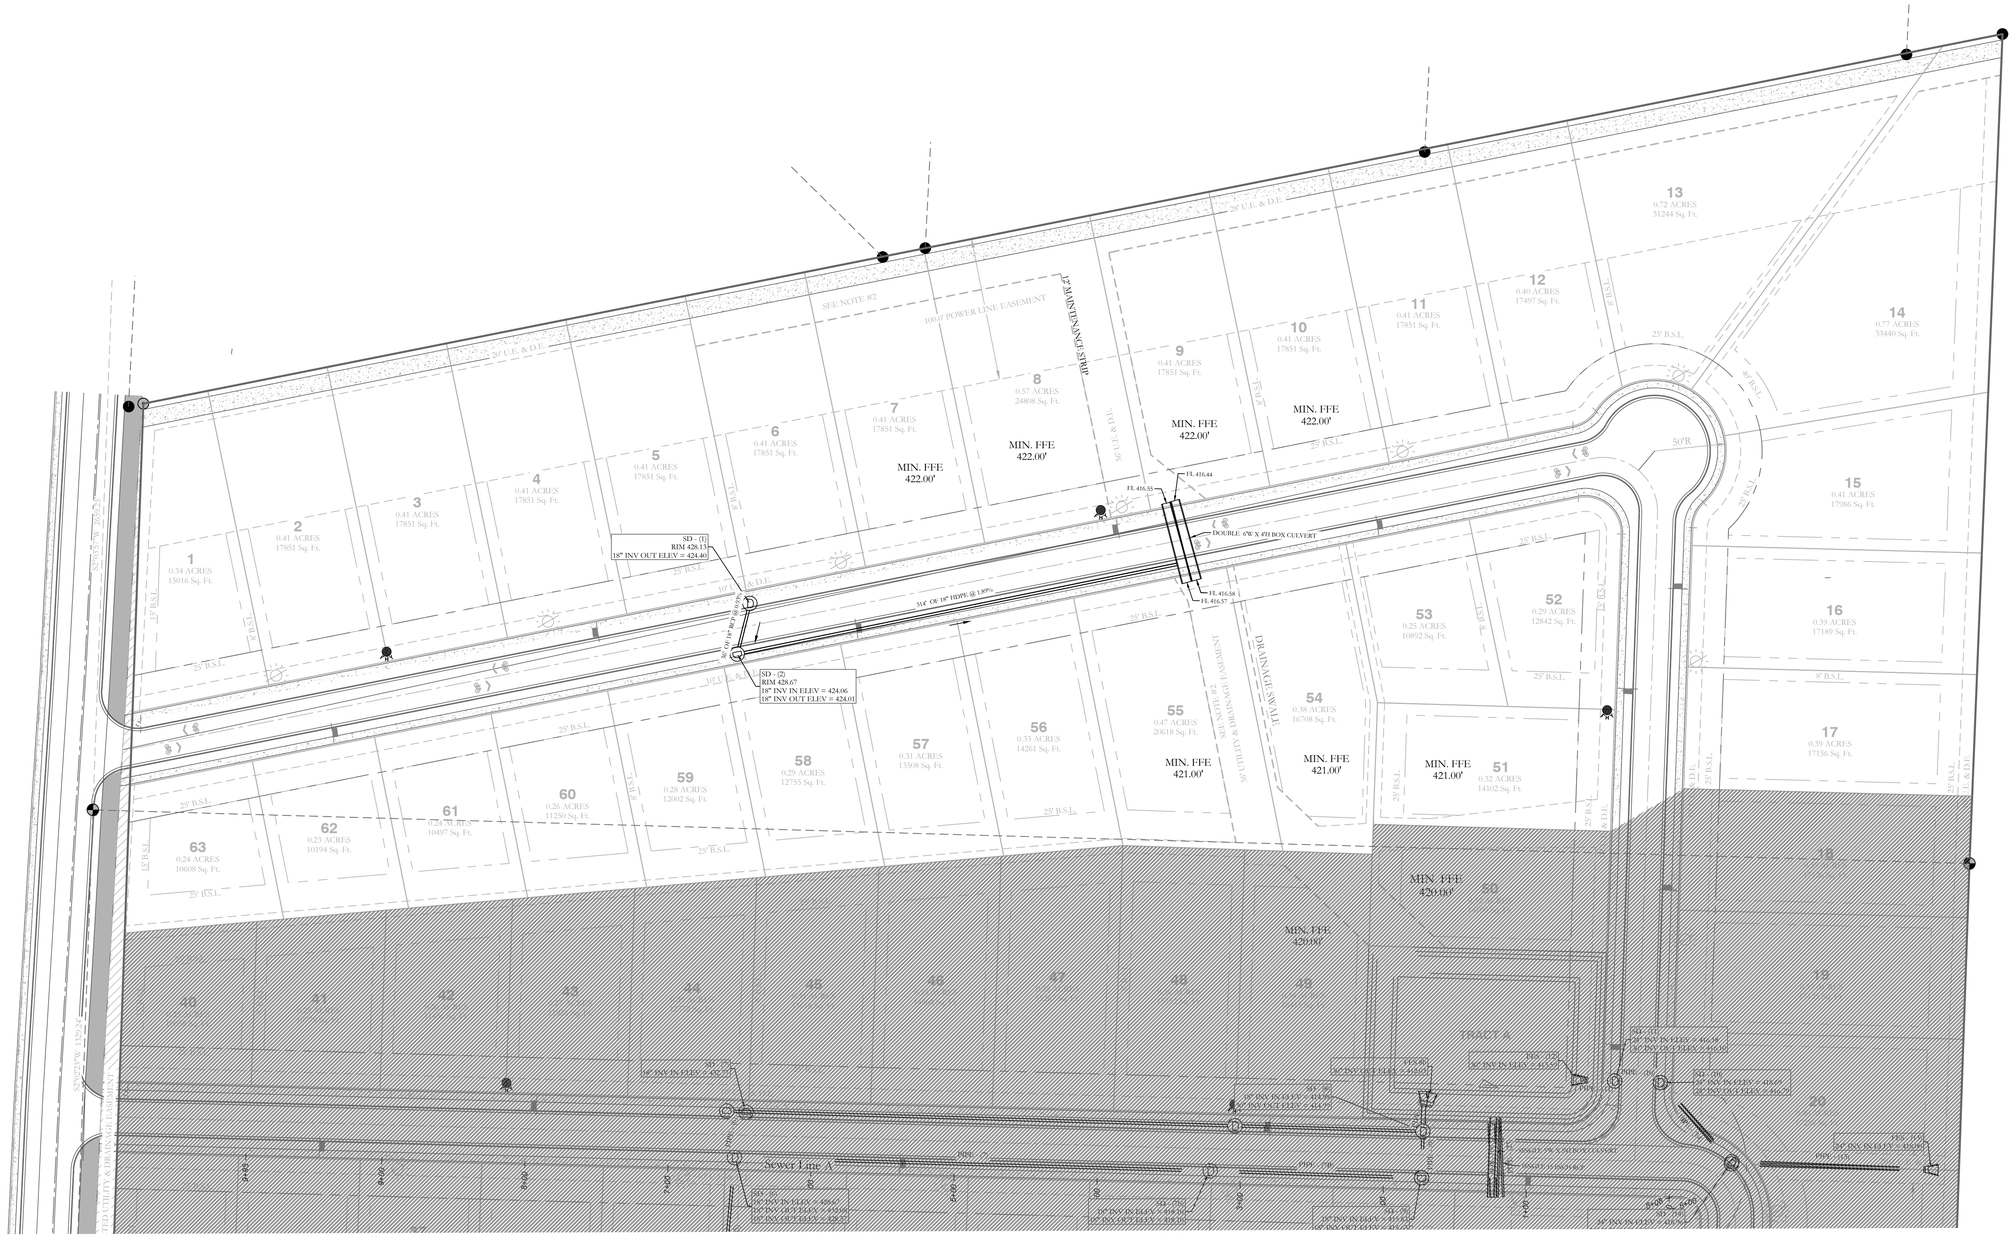


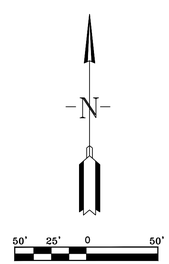

HOPE CONSULTING
ENGINEERS - SURVEYORS
117 S. Market Street,
Benton, Arkansas 72015
PH. (501)315-2626
FAX (501) 315-0024
www.hopeconsulting.com

FOR USE AND BENEFIT OF:
BULL DEVELOPMENT LLC.

DRAINAGE AS-BUILTS
ROMAN HEIGHTS PHASE 2 SUBDIVISION

A SUBDIVISION IN SALINE COUNTY, ARKANSAS

DATE: 07/21/2021	C.A.D. BY: MD	DRAWING NUMBER:	
REVISED:	CHECKED BY:	17-0077	
SHEET:	SCALE: 1"=60'		

K:\LAND PROJECTS 2004\SUBDIVISIONS\2017\17-0077 ROMAN HEIGHTS\DWG\17-0077 ROMAN HEIGHTS PHASE 2 DRAINAGE AS-BUILTS.DWG